


FOR CONTINUATION SEE SHEET C-05

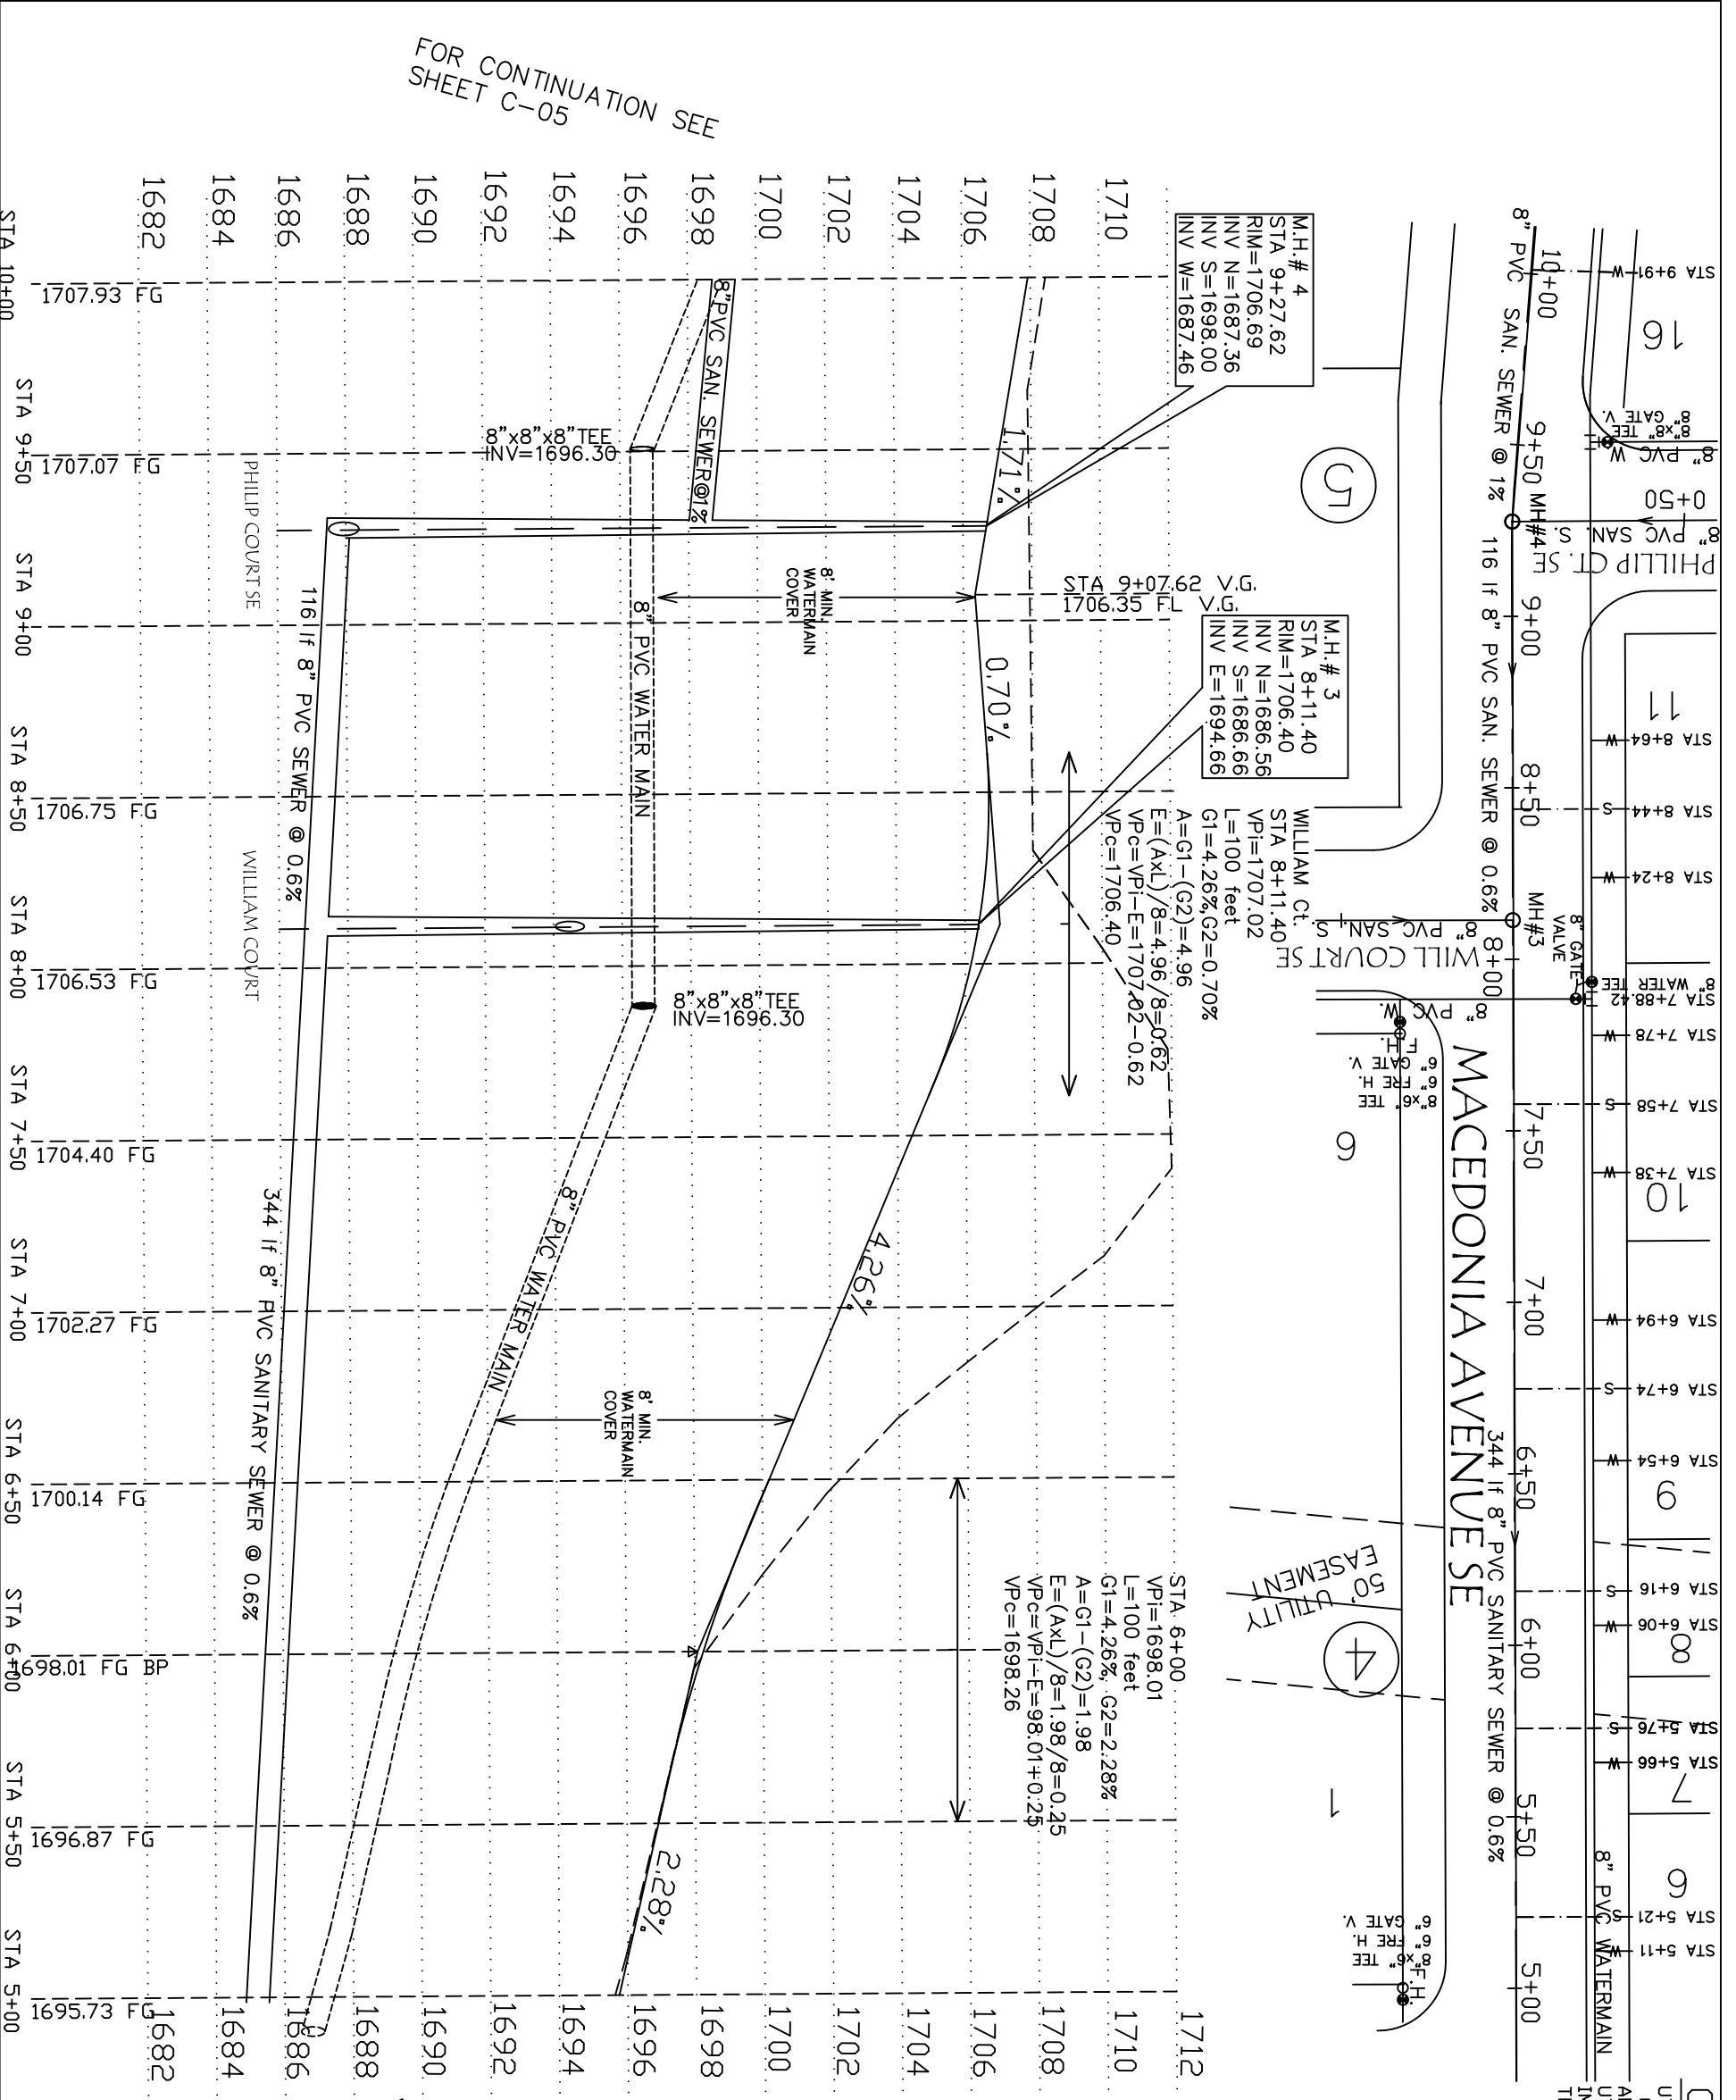

FOR CONTINUATION SEE SHEET C-03


CONTRACTORS NOTE:
 UTILITY LOCATIONS ARE APPROXIMATE, CONTRACTOR TO VERIFY HORIZONTAL AND VERTICAL ALIGNMENT OF EXISTING UTILITIES AND TO NOTIFY THE ENGINEER IMMEDIATELY OF ANY DISCREPANCIES PRIOR TO CONSTRUCTION.

AVOID CUTTING UNDERGROUND UTILITY LINES IN YOUR AREA
 TWO WORKING DAYS BEFORE YOU DIG-DRILL-BLAST IN NORTH DAKOTA - CALL TOLL FREE 1-800-795-0555
 LISTEN! UNDERGROUND LOCATIONS CHANGERS

AS BILT -- MACEDONIA AVE SE
 STA 5+00 to 9+50

WATER & SEWER IMPROVEMENTS
 MACEDONIA HILLS—FIRST ADDITION
 PROJECT NUMBER 2013-21
 CITY OF MANDAN
 MORTON COUNTY, NORTH DAKOTA

REVISIONS:
 MACKOVSKI CONSULTING
 7745 MAGGIE BELLE CT.
 LAS VEGAS, NV 89123
 (702) 648-9690 Phone/Fax
 (702) 499-8961 Cell
 MB@MBinvestors.com

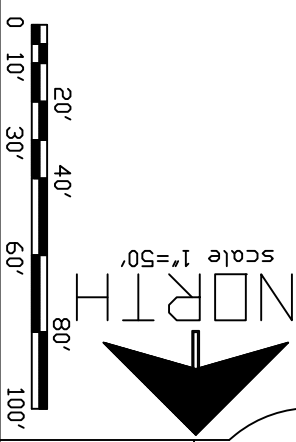

SHEET
 C-04
 4 OF 14