

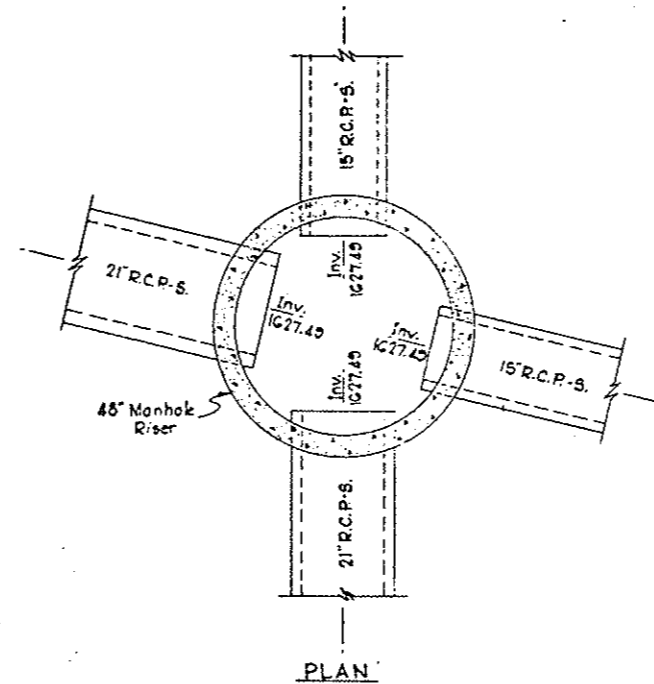


# MANHOLE DETAILS

FINVA REGION	STATE	FED. AID PROJ. NO.	SHEET NO.
8	N.D.	MG-1-010(05)	9

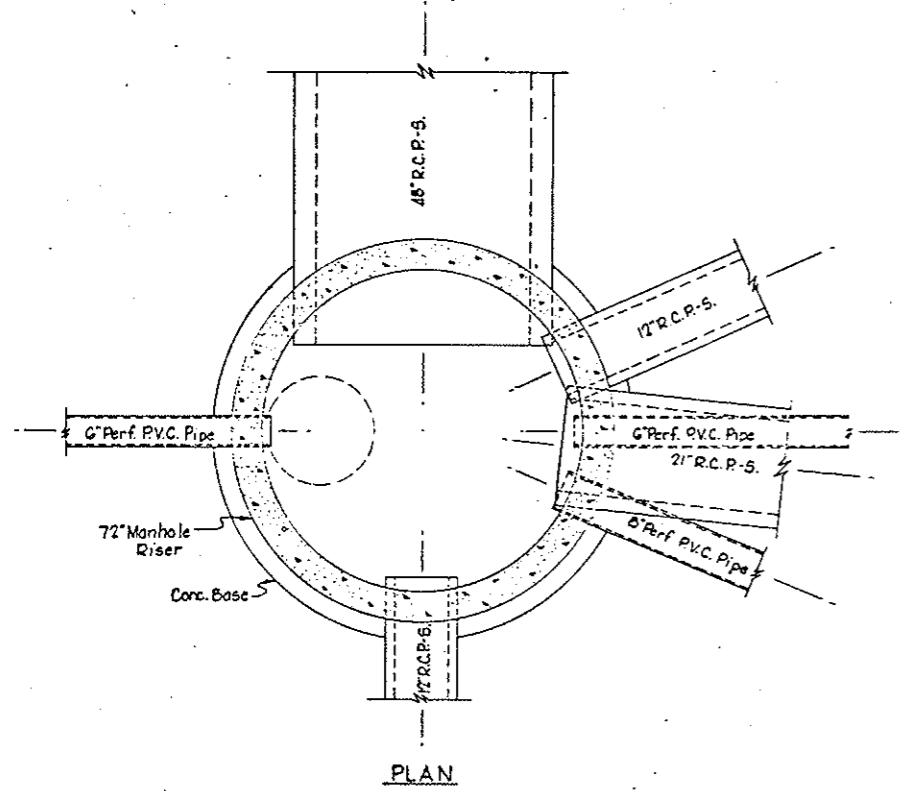

MANHOLE - STA. 3+30-20 Lt.

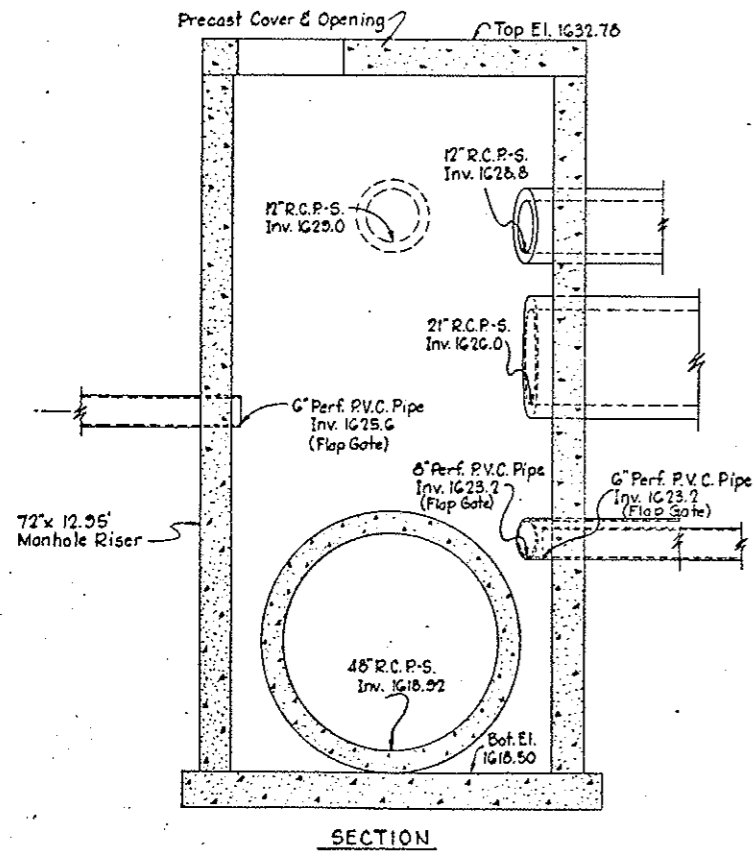

MANHOLE - STA. 2+25-37 Lt.