

Install Pavement Marking, Drop on Beads, Type II

Sta. 91+00 to 96+00 Lt. & Rt. Edge Lines	1000 L.F.
Sta. 91+00 to 96+00 Lt. & Rt. Lane Lines	260 L.F.
Sta. 91+00 to 96+00 Lt. & Rt. No Passing Zone Lines	1260 L.F.
Left Arrows 2 Ea.	




Sta. 92+68 Lt.
R8-3-36
Light Std. Mtd.



Sta. 93+75 Lt.
R1-1-30
Assembly 1
Reg-Sign

95

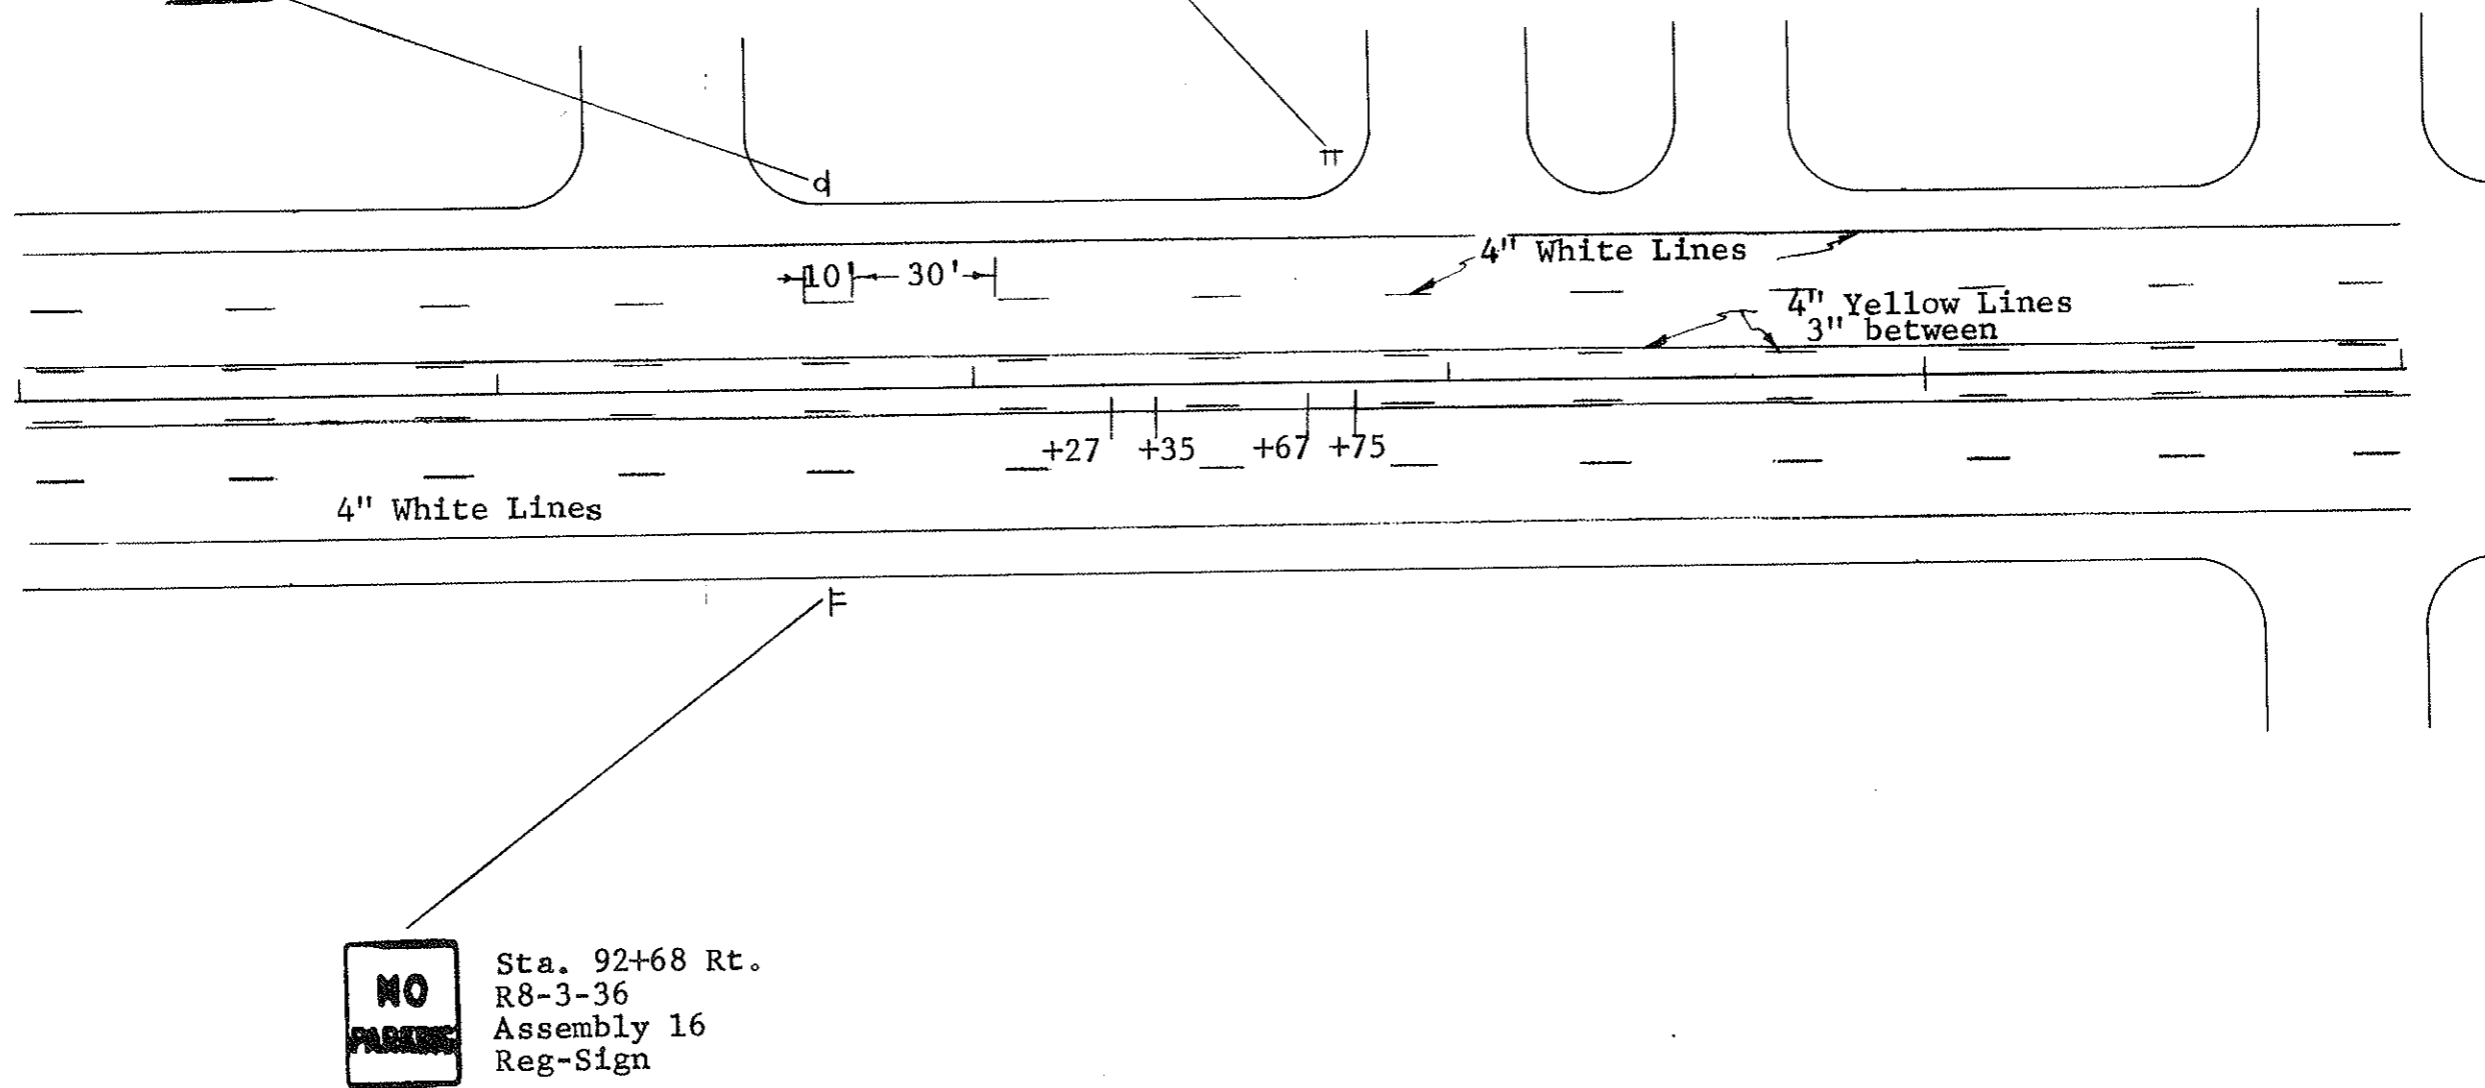

FHWA REGION	STATE	FED. AID PROJ. NO.	SHEET NO.
8	N.D.	F-1-094(03)	69

Install Pavement Marking, Drop on Beads, Type II

Sta. 96+00 to 101+00 Lt. & Rt. Edge Lines 1000 L.F.
 Sta. 96+00 to 101+00 Lt. & Rt. Lane Lines 240 L.F.
 Sta. 96+00 to 101+00 Lt. & Rt. No Passing Zone Lines 1240 L.F.

Left Arrows 2 Ea.

SPEED LIMIT
40

In Place
Remove

SPEED LIMIT
40

Sta. 98+20 Lt.
R2-1-36
Light Std. Mtd.

NO
PARKING

Sta. 97+02 Lt.
R8-3-36
Light Std. Mtd.

STOP

Sta. 97+60 Lt.
R1-1-30
Assembly 1
Reg-Sign


STOP

Sta. 99+30 Lt.
R1-1-30
Assembly 1
Reg-Sign

100

STOP

Sta. 100+00 Lt.
R1-1-30
Assembly 1
Reg-Sign

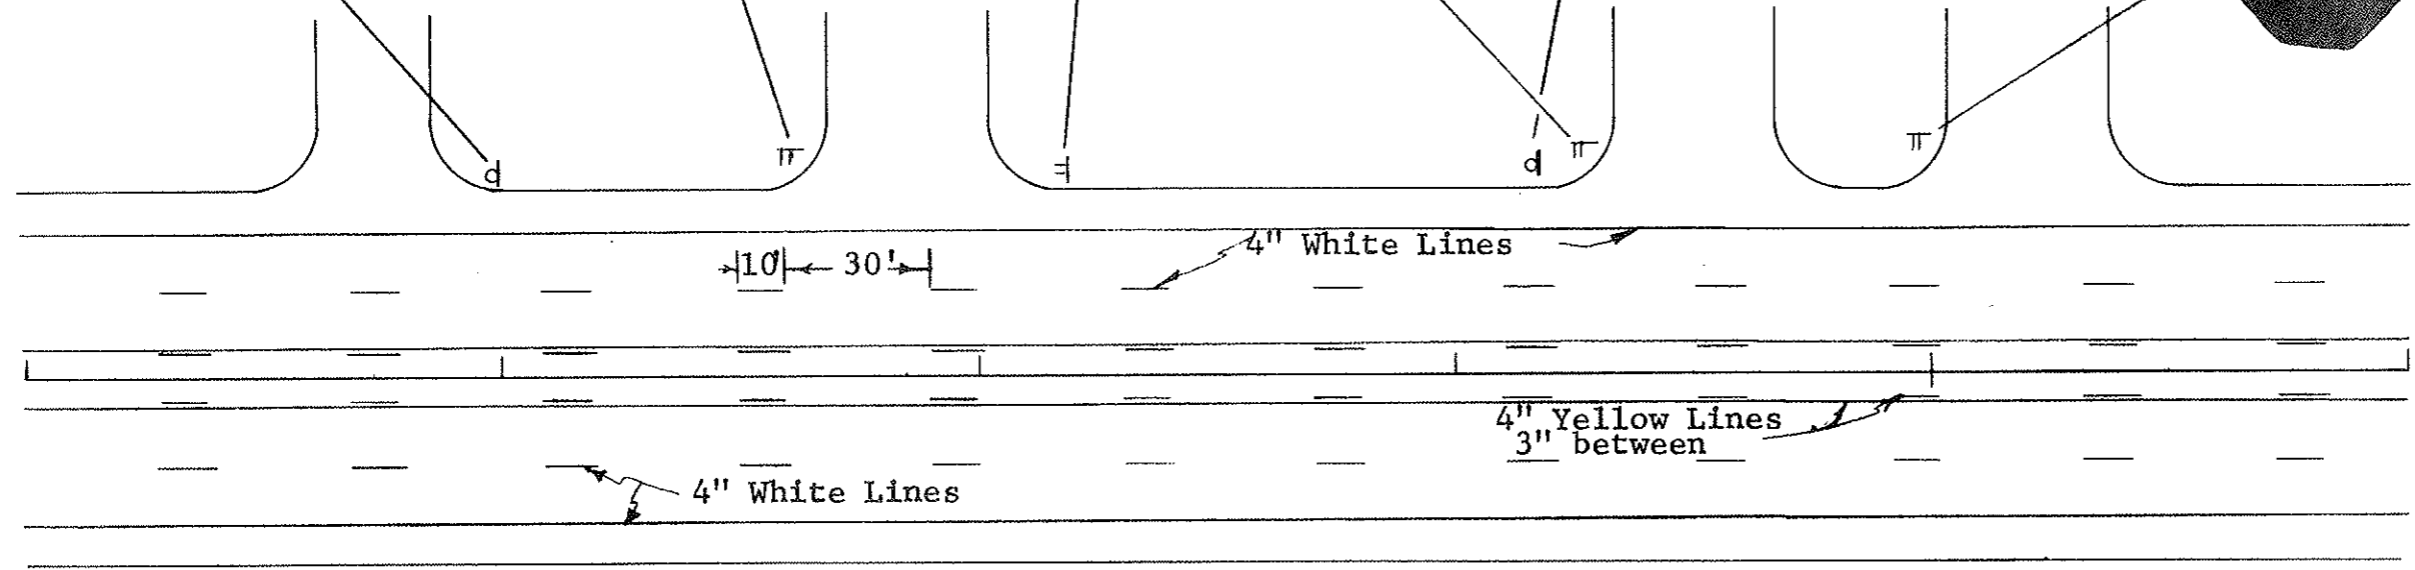

NO
PARKING

Sta. 97+02 Rt.
R8-3-36
Assembly 16
Reg-Sign