
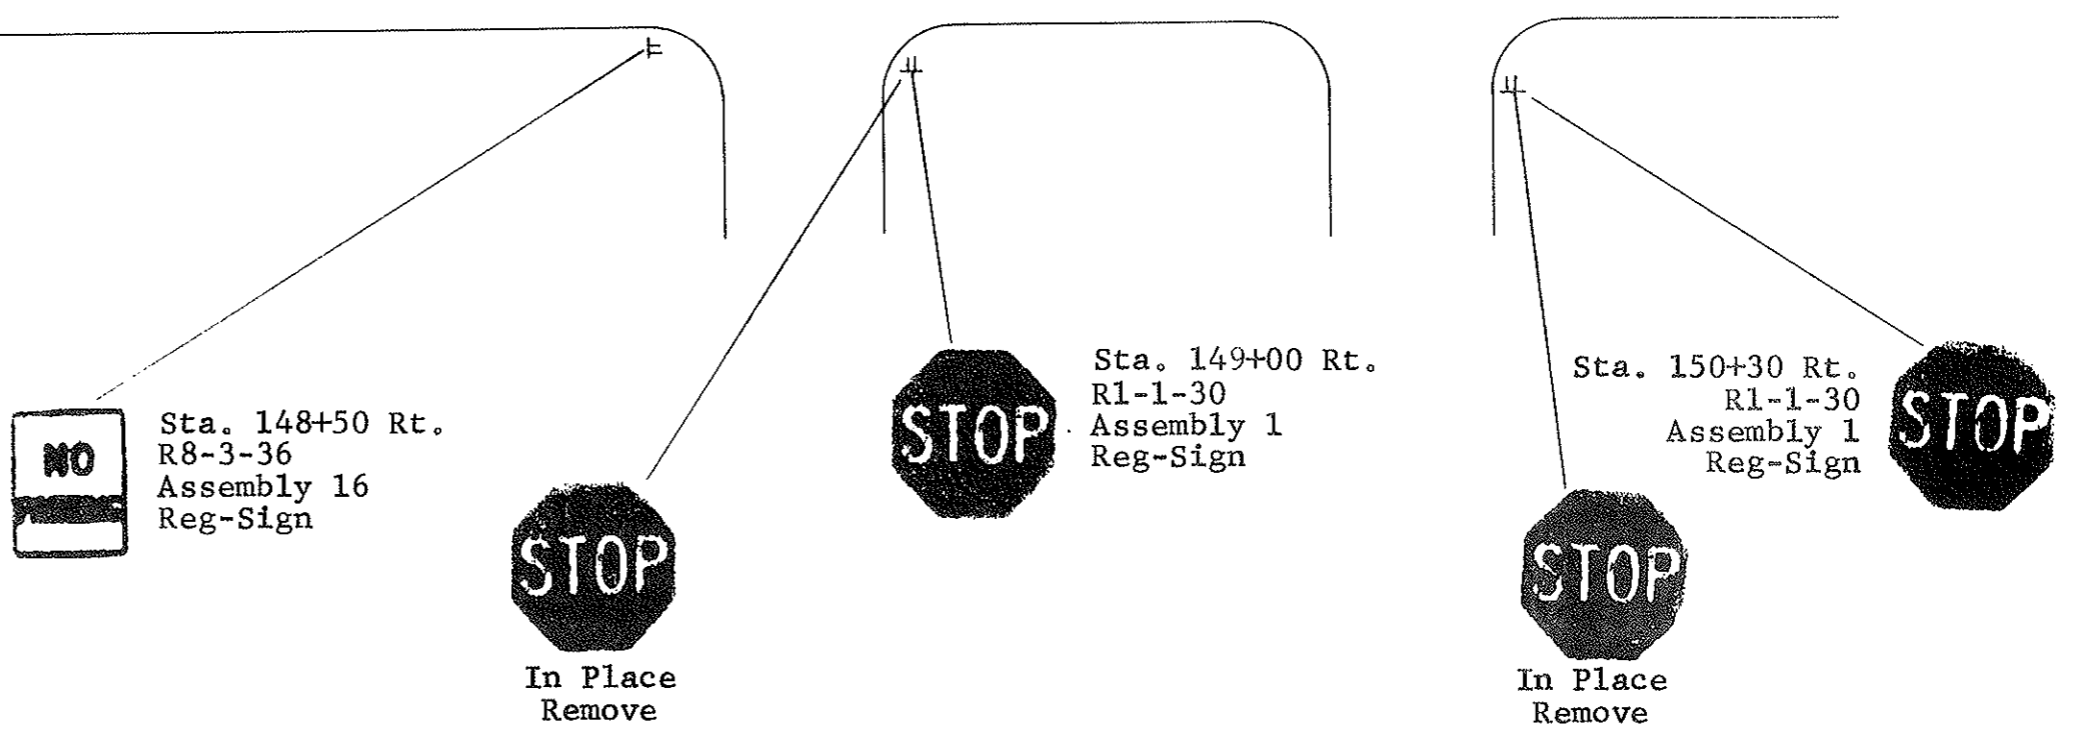
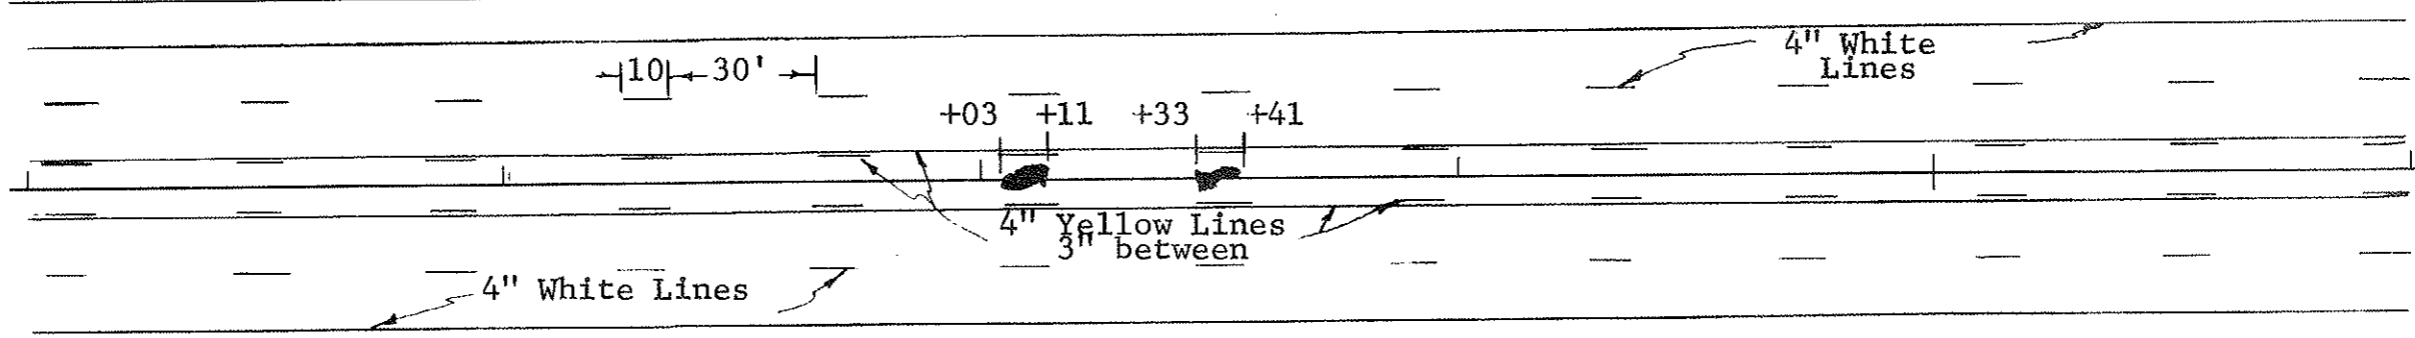


Install Pavement Marking, Drop on Beads, Type II

Sta. 146+00 to 151+00 Lt. & Rt. Edge Lines 1000 L.F.  
 Sta. 146+00 to 151+00 Lt. & Rt. Lane Lines 260 L.F.  
 Sta. 146+00 to 151+00 Lt. & Rt. No Passing Zone Lines 1260 L.F.

Left Arrows 2 Ea.

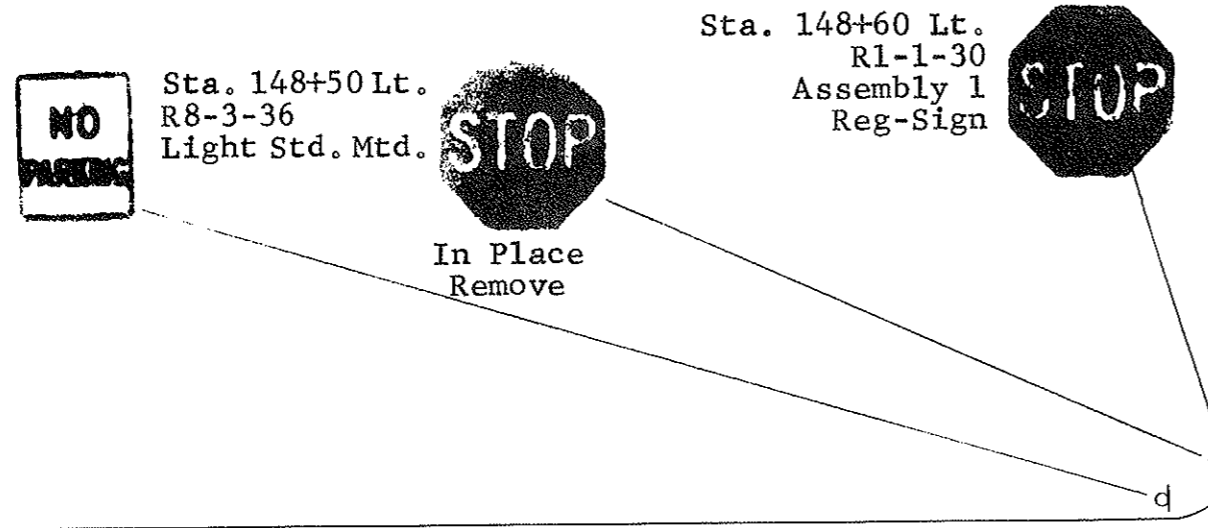

150