

**INSTALL WOVEN WIRE FENCE**

30+00 to 30+60 Rt. 60 L.F.  
 31+40 to 42+15 Rt. 1075 L.F.  
 42+60 to 57+30 Rt. 1470 L.F.


**INSTALL CONDUIT PIPE**

59+23.5-1000' Rt. 18" X 49"  
 (On Proj. I-194-4 (35))

**INSTALL CAST IRON FLAP GATE**

59+23.5-1000' Rt. 1-18"  
 (On Proj. I-194-4 (35))

FED. AID DIV. NO.	STATE	FED. AID PROJECT NO.	SHEET NO.	TOTAL SHEETS
8	N.D.	F-1094(03)	23	

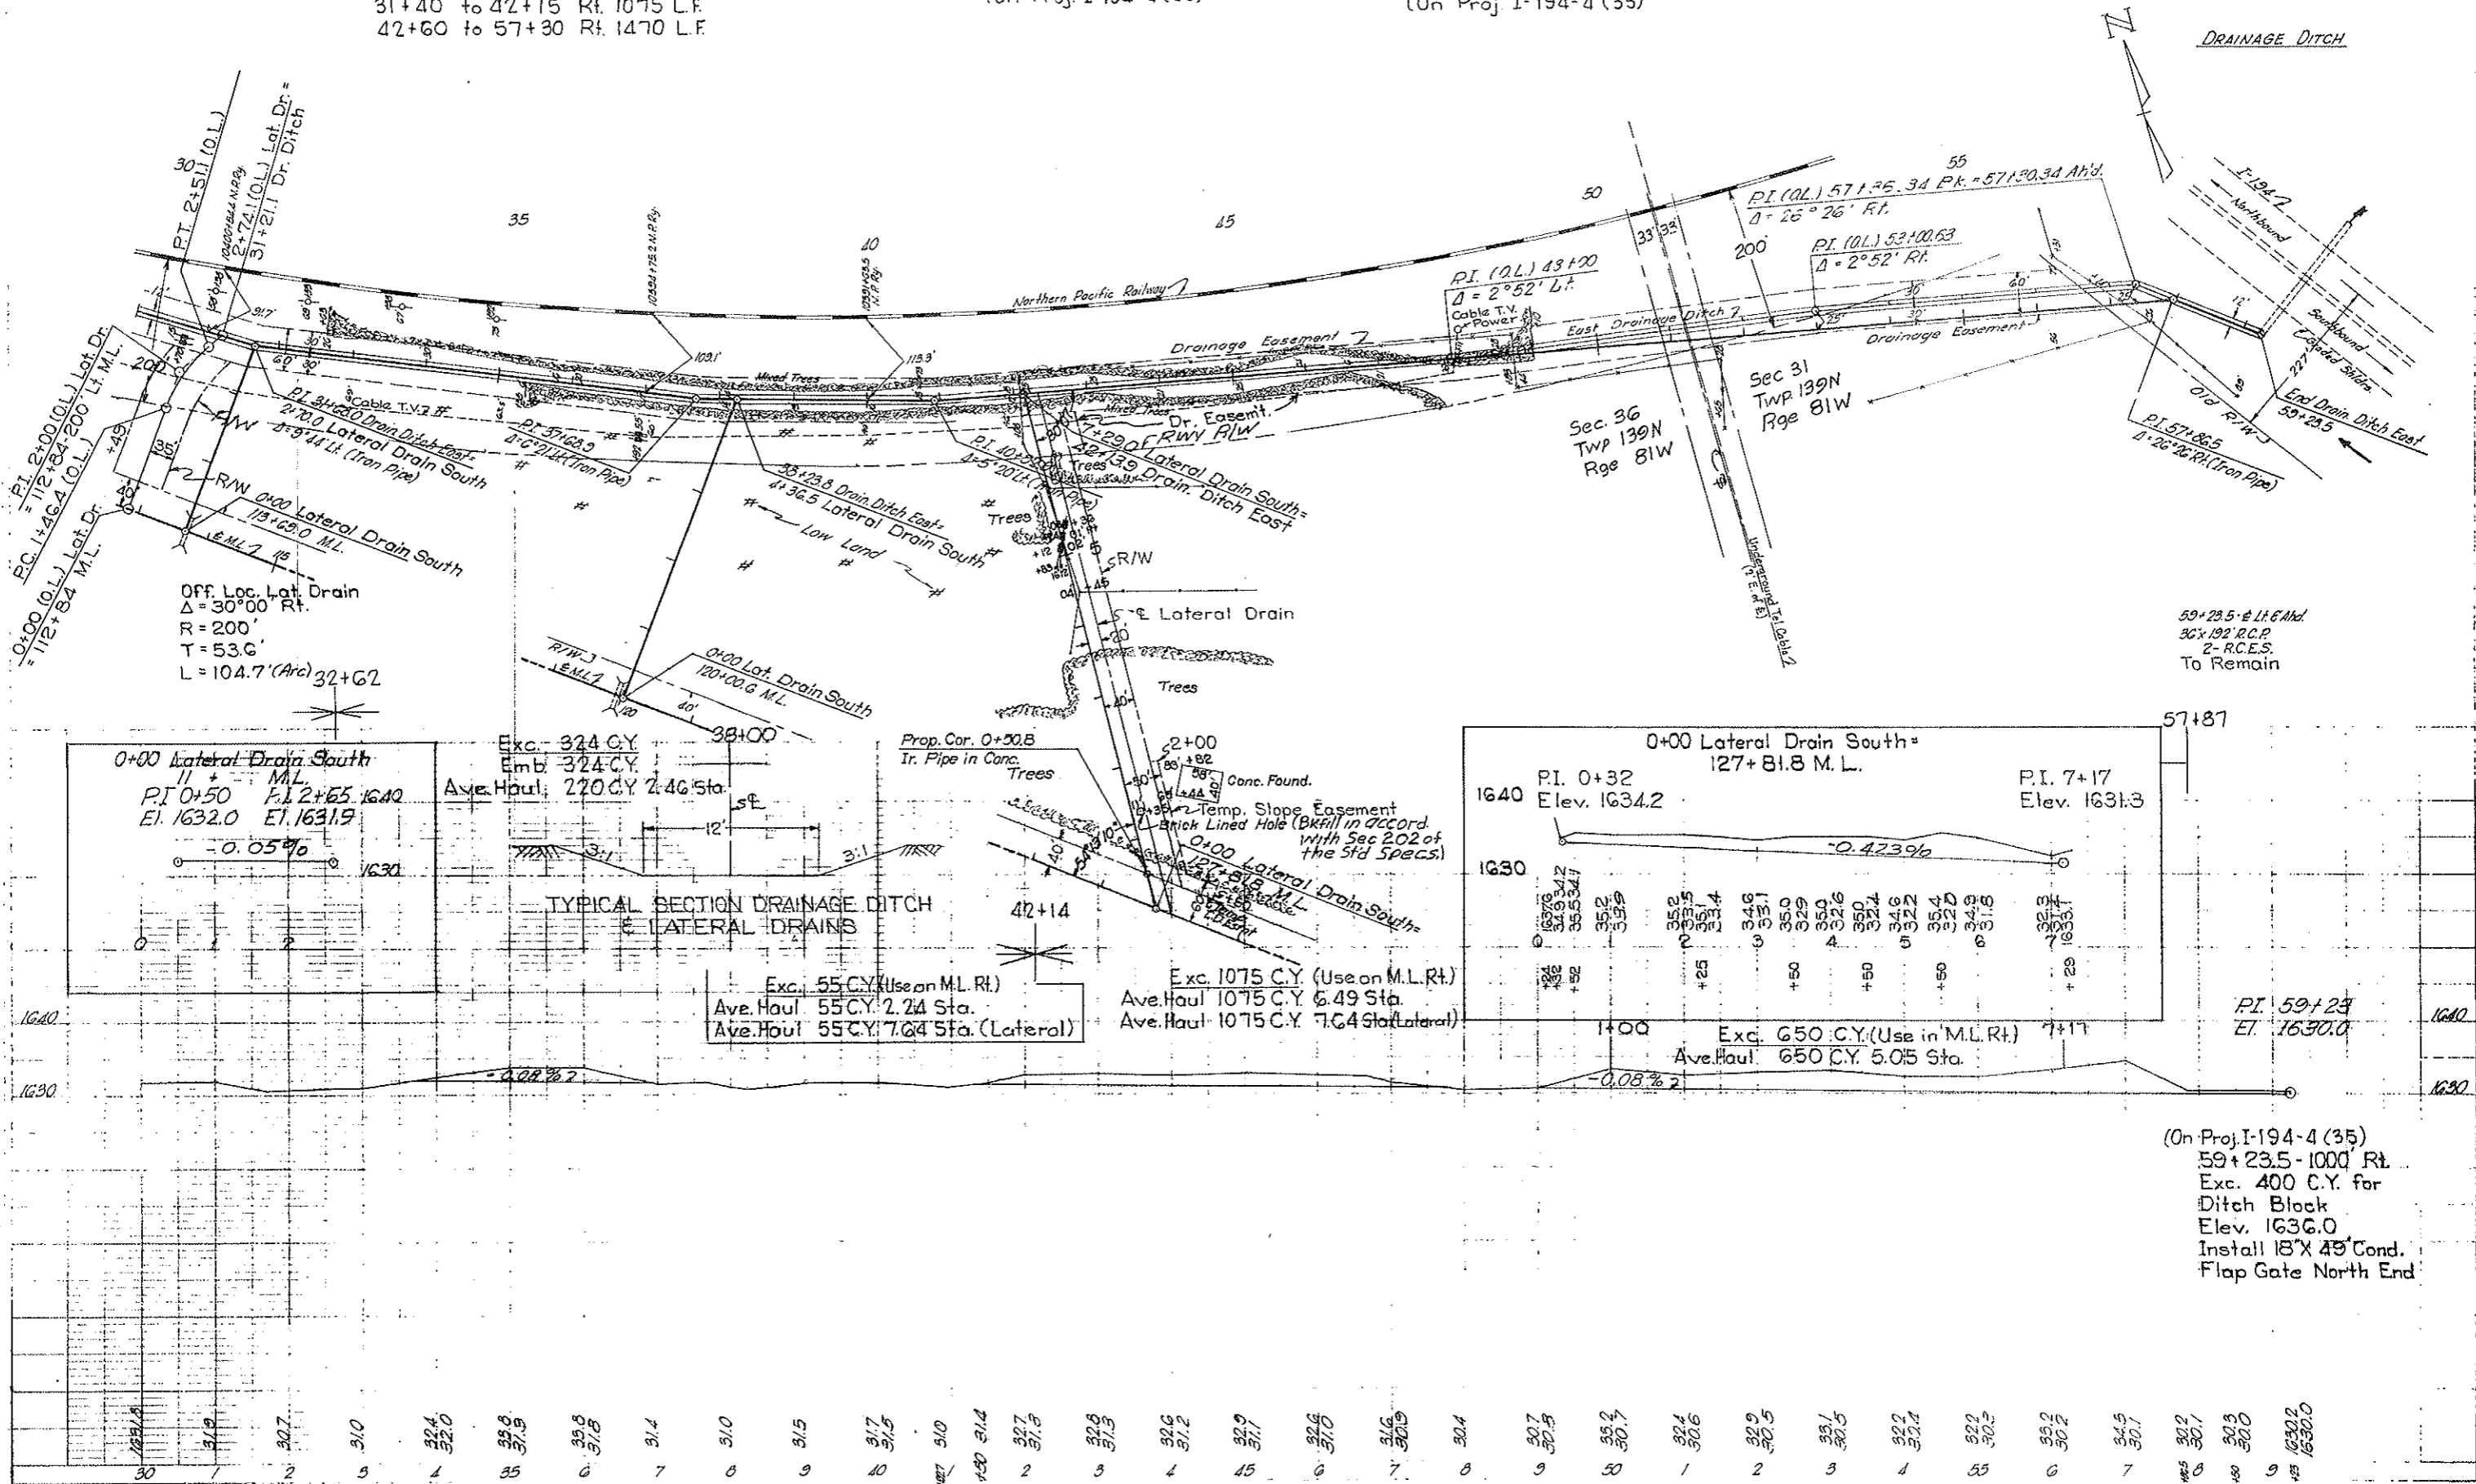

(On Proj. I-194-4 (35))  
 59+23.5-1000' Rt.  
 Exc. 400 C.Y. for  
 Ditch Block  
 Elev. 1636.0  
 Install 18" X 49" Cond.  
 Flap Gate North End