


FHWA REGION	STATE	FED. AID PROJ. NO.	SHEET NO.
8	N.D.	RRS-1-006(005)066	143

① Revised 1-18-91

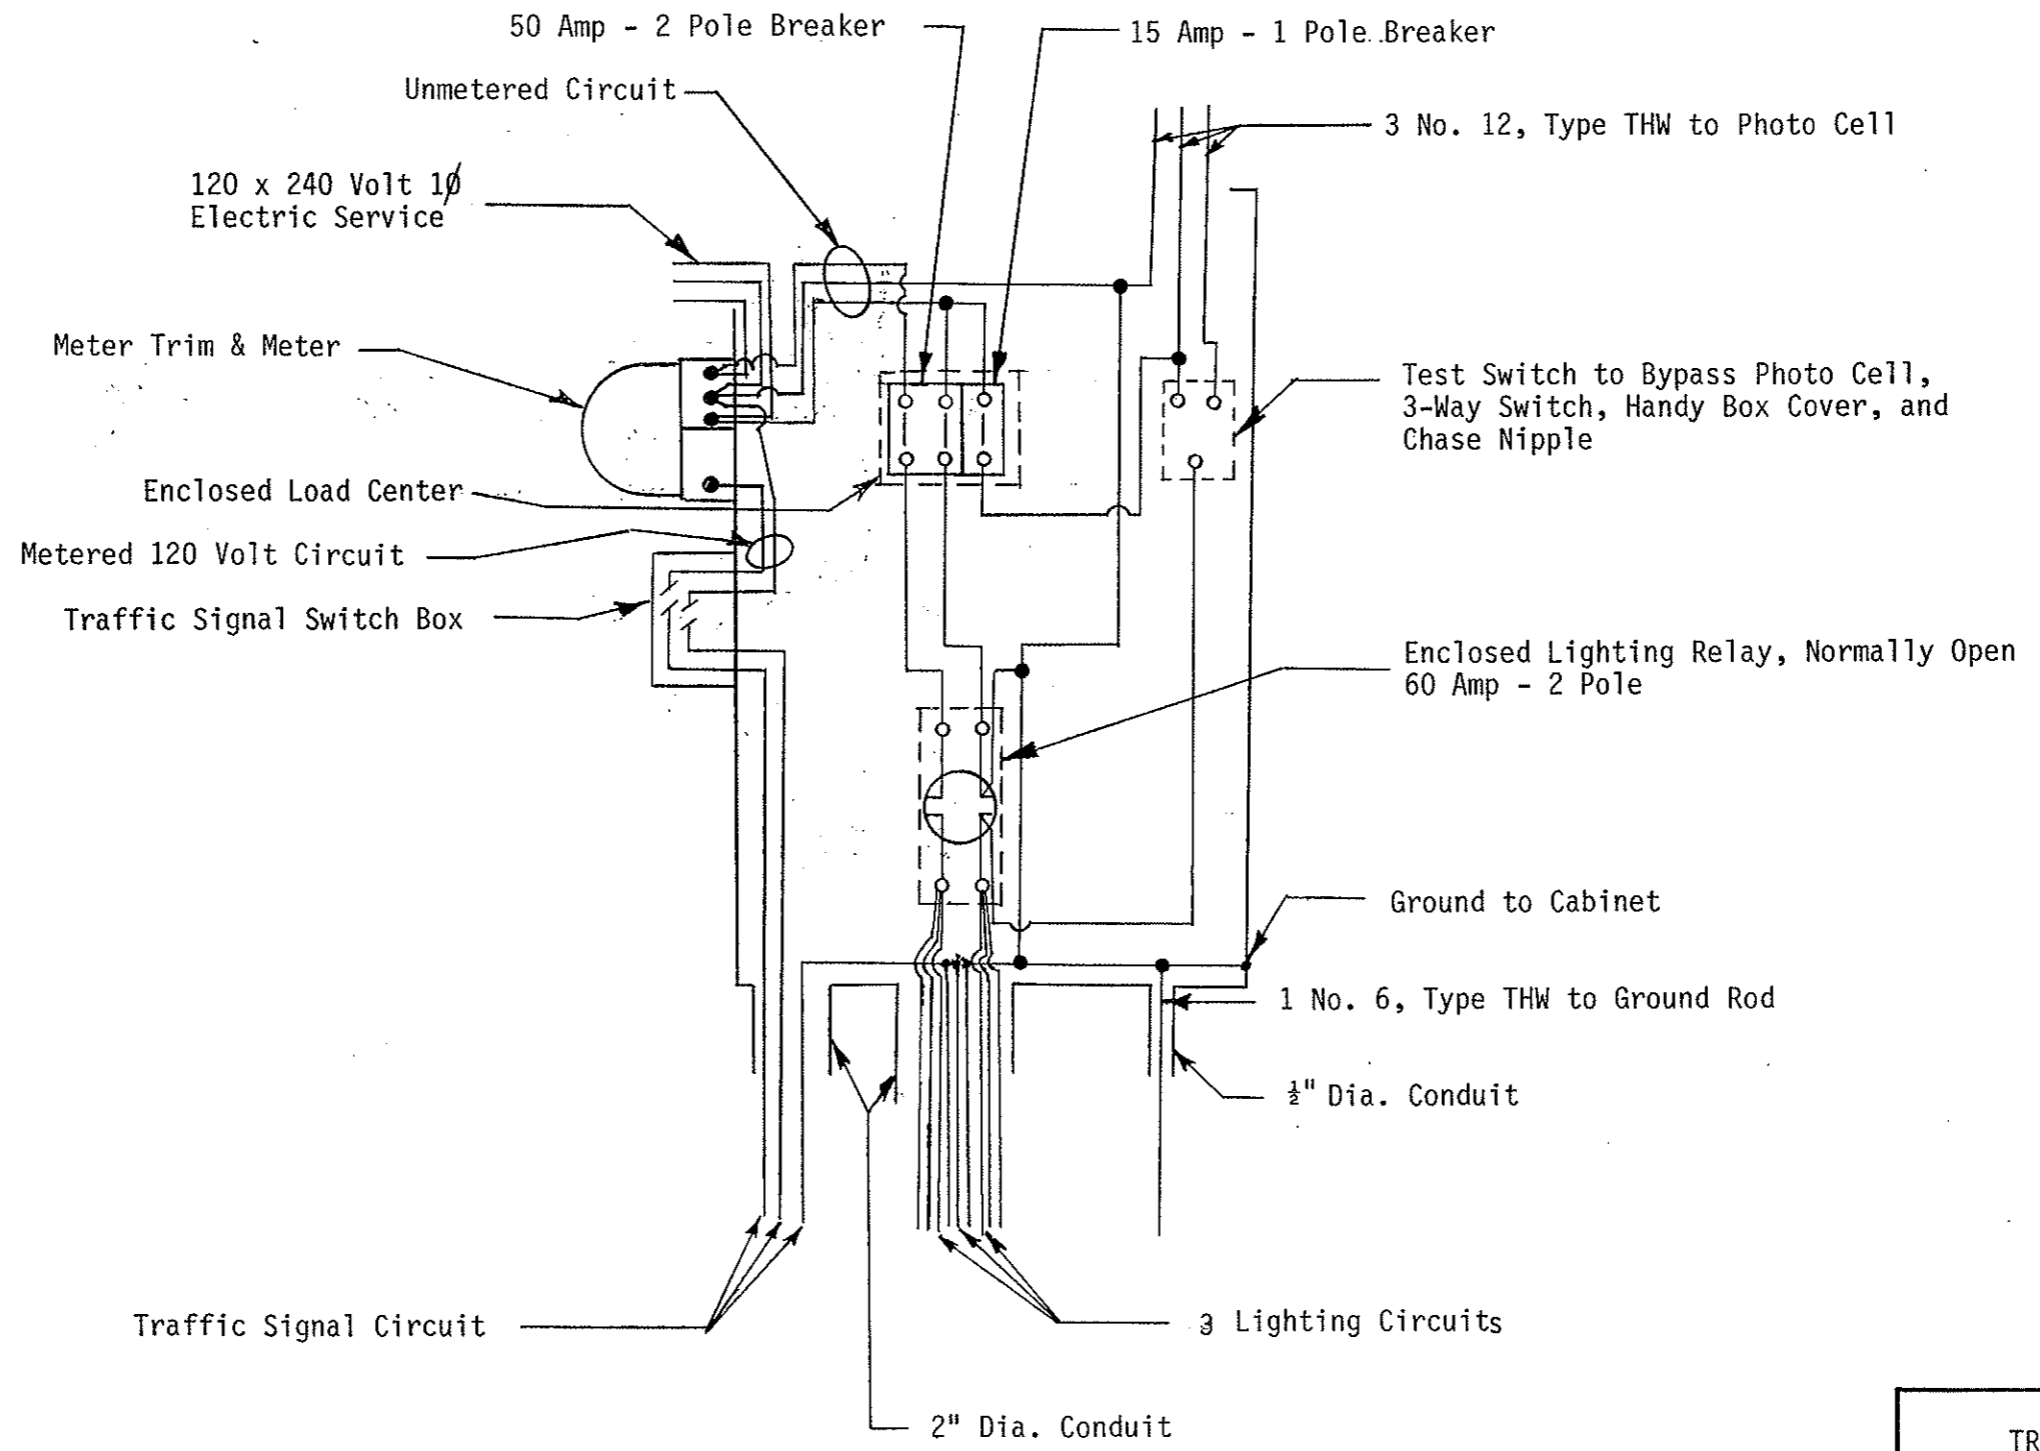

TRAFFIC CONTROL SYSTEM
 Combination Lighting & Signal
 Pad Mtd. Feed Point Detail
 Sta. 737+45-46' Rt.