

DISTRICT	STATE	FED. AID PROJ. NO.	SHEET NO.
8	N.D.	M-1-988(02)000	25

INSTALL CURB & GUTTER, TYPE-I
 39+76.6 TO 40+00 P.T. 60.0 L.F.
 39+76.6 TO 40+00 P.T. 60.0 L.F.

INSTALL REINFORCING PIPE SEWER
 39+76.6 TO 40+00 P.T. 24"x21" R.C.P.S. CI. III

INSTALL 60" MANHOLE
 39+76.6 ~ 12' RT. 1 Ea.



INSTALL MANHOLE RISER
 39+76.6 ~ 12' RT. 60"x8.06'

ADJUST MANHOLE
 39+57 1 Ea.

ADJUST UTILITY APPURTENANCE
 37+67 ~ 26.5' RT. CW.S.V. 1 Ea.

RELOCATE HYDRANT
 37+67 ~ 58' RT. 1 Ea.

INSTALL CONCRETE DRIVEWAY
 39+69 ~ 22' RT. 24' 18 S.Y.

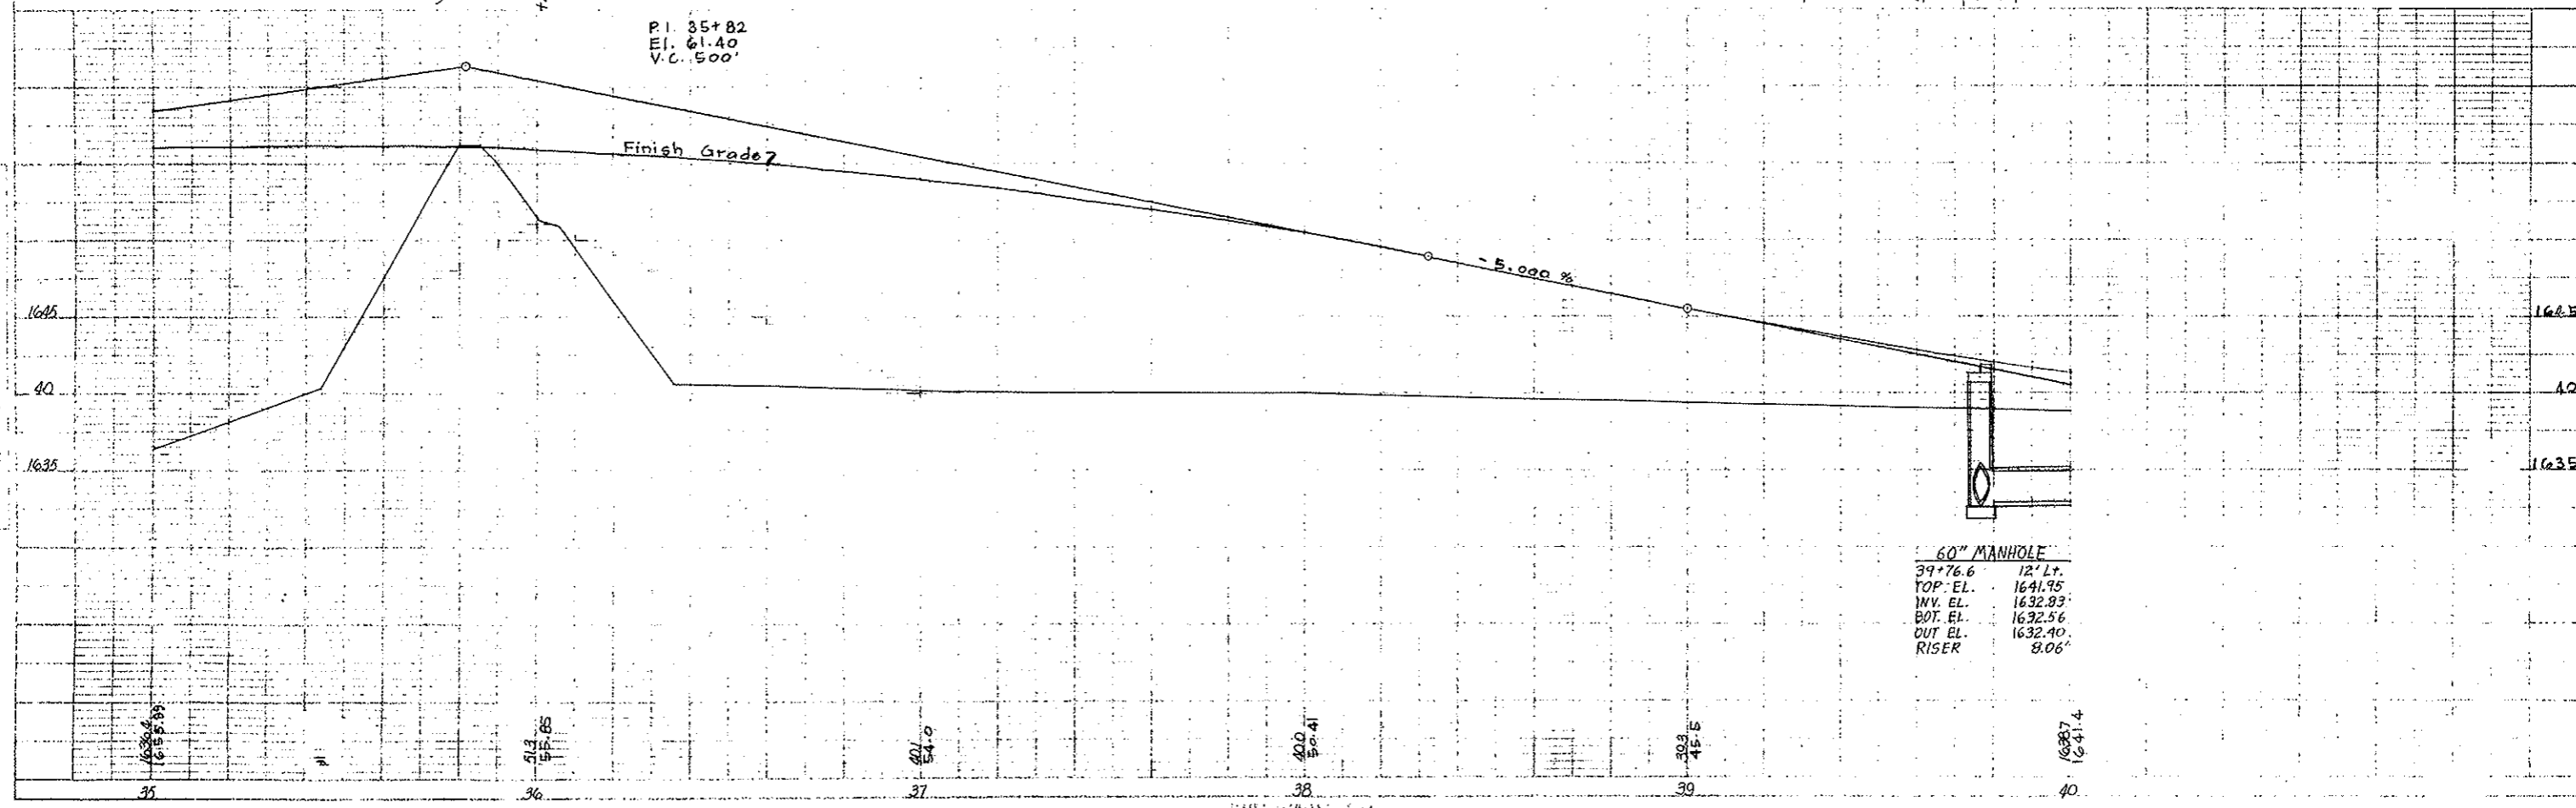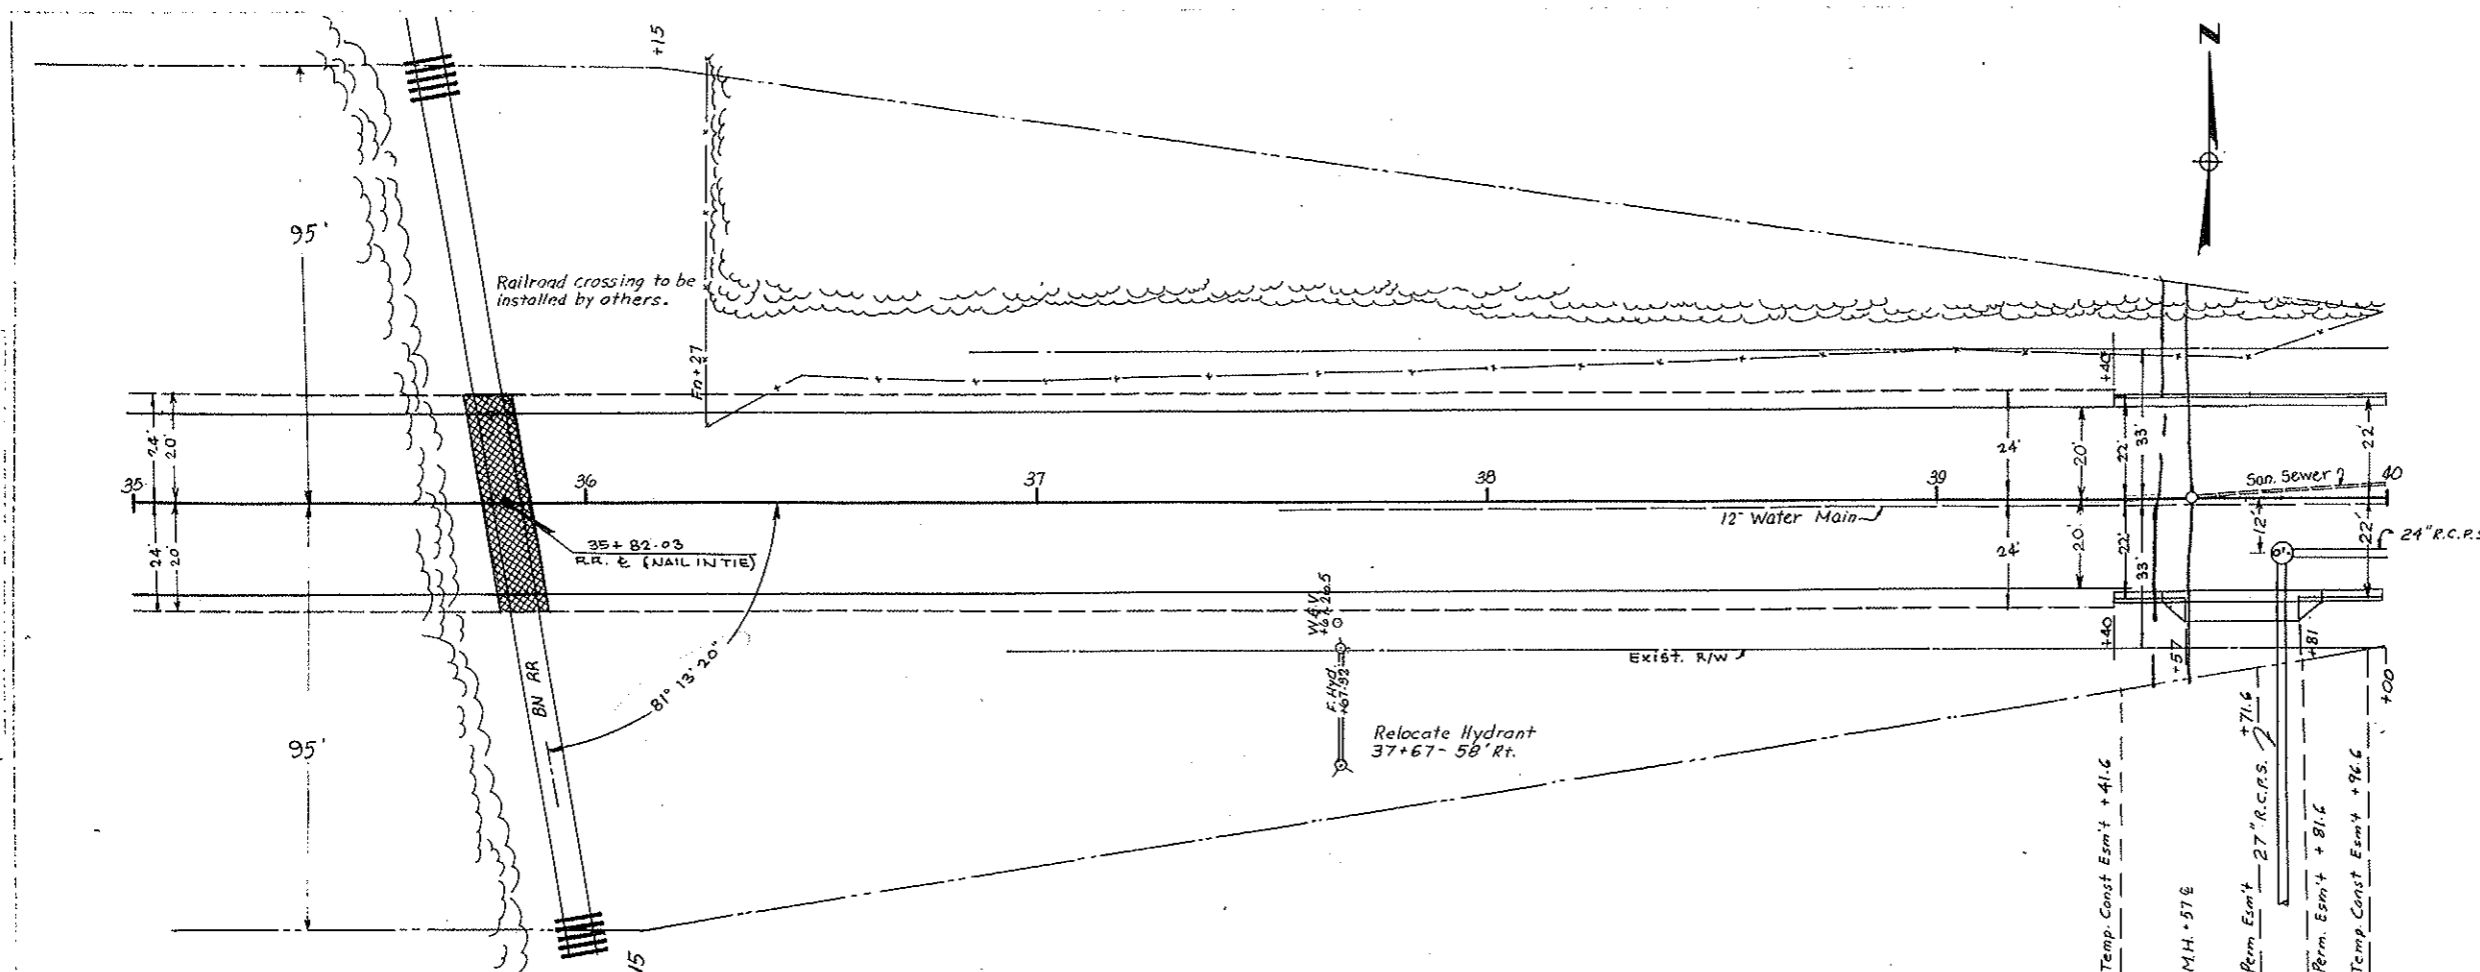

PLAN
 SHOWS
 THE
 LOCATION
 OF
 THE
 SEWER
 AND
 MANHOLE