

CONSTRUCTION PLANS FOR:

MEADOWS 2ND ADDITION STREET IMPROVEMENT PROJECT 2005-28 DIST. NO. 137 - AREA B CITY OF MANDAN, NORTH DAKOTA

MAY 2006

SHEET INDEX

1. COVER SHEET
- 2-3. DETAILS
4. GENERAL AREA LAYOUT
5. 34TH AVENUE PLAN AND PROFILE
6. 37TH AVENUE PLAN AND PROFILE
7. 37TH AVENUE PLAN AND PROFILE
8. 45TH STREET PLAN AND PROFILE
9. STORM SEWER PLAN AND PROFILE

CERTIFICATION

I HEREBY CERTIFY THAT THESE PLANS AND SPECIFICATIONS WERE PREPARED BY ME OR UNDER MY DIRECT SUPERVISION, AND THAT I AM A DULY REGISTERED ENGINEER IN THE STATE OF NORTH DAKOTA.


Brian Eiseman DATE 4-25-07 REG. NO. 4077
Brian Eiseman, P.E.



APPROVAL OF CITY ENGINEER


I, THOMAS LITTLE, CITY ENGINEER FOR THE CITY OF MANDAN, NORTH DAKOTA HEREBY APPROVE THESE PLANS FOR WATER & SEWER AS SHOWN ON THE ACCOMPANYING PLANS.

DATE _____
Thomas Little, P.E. - City Engineer

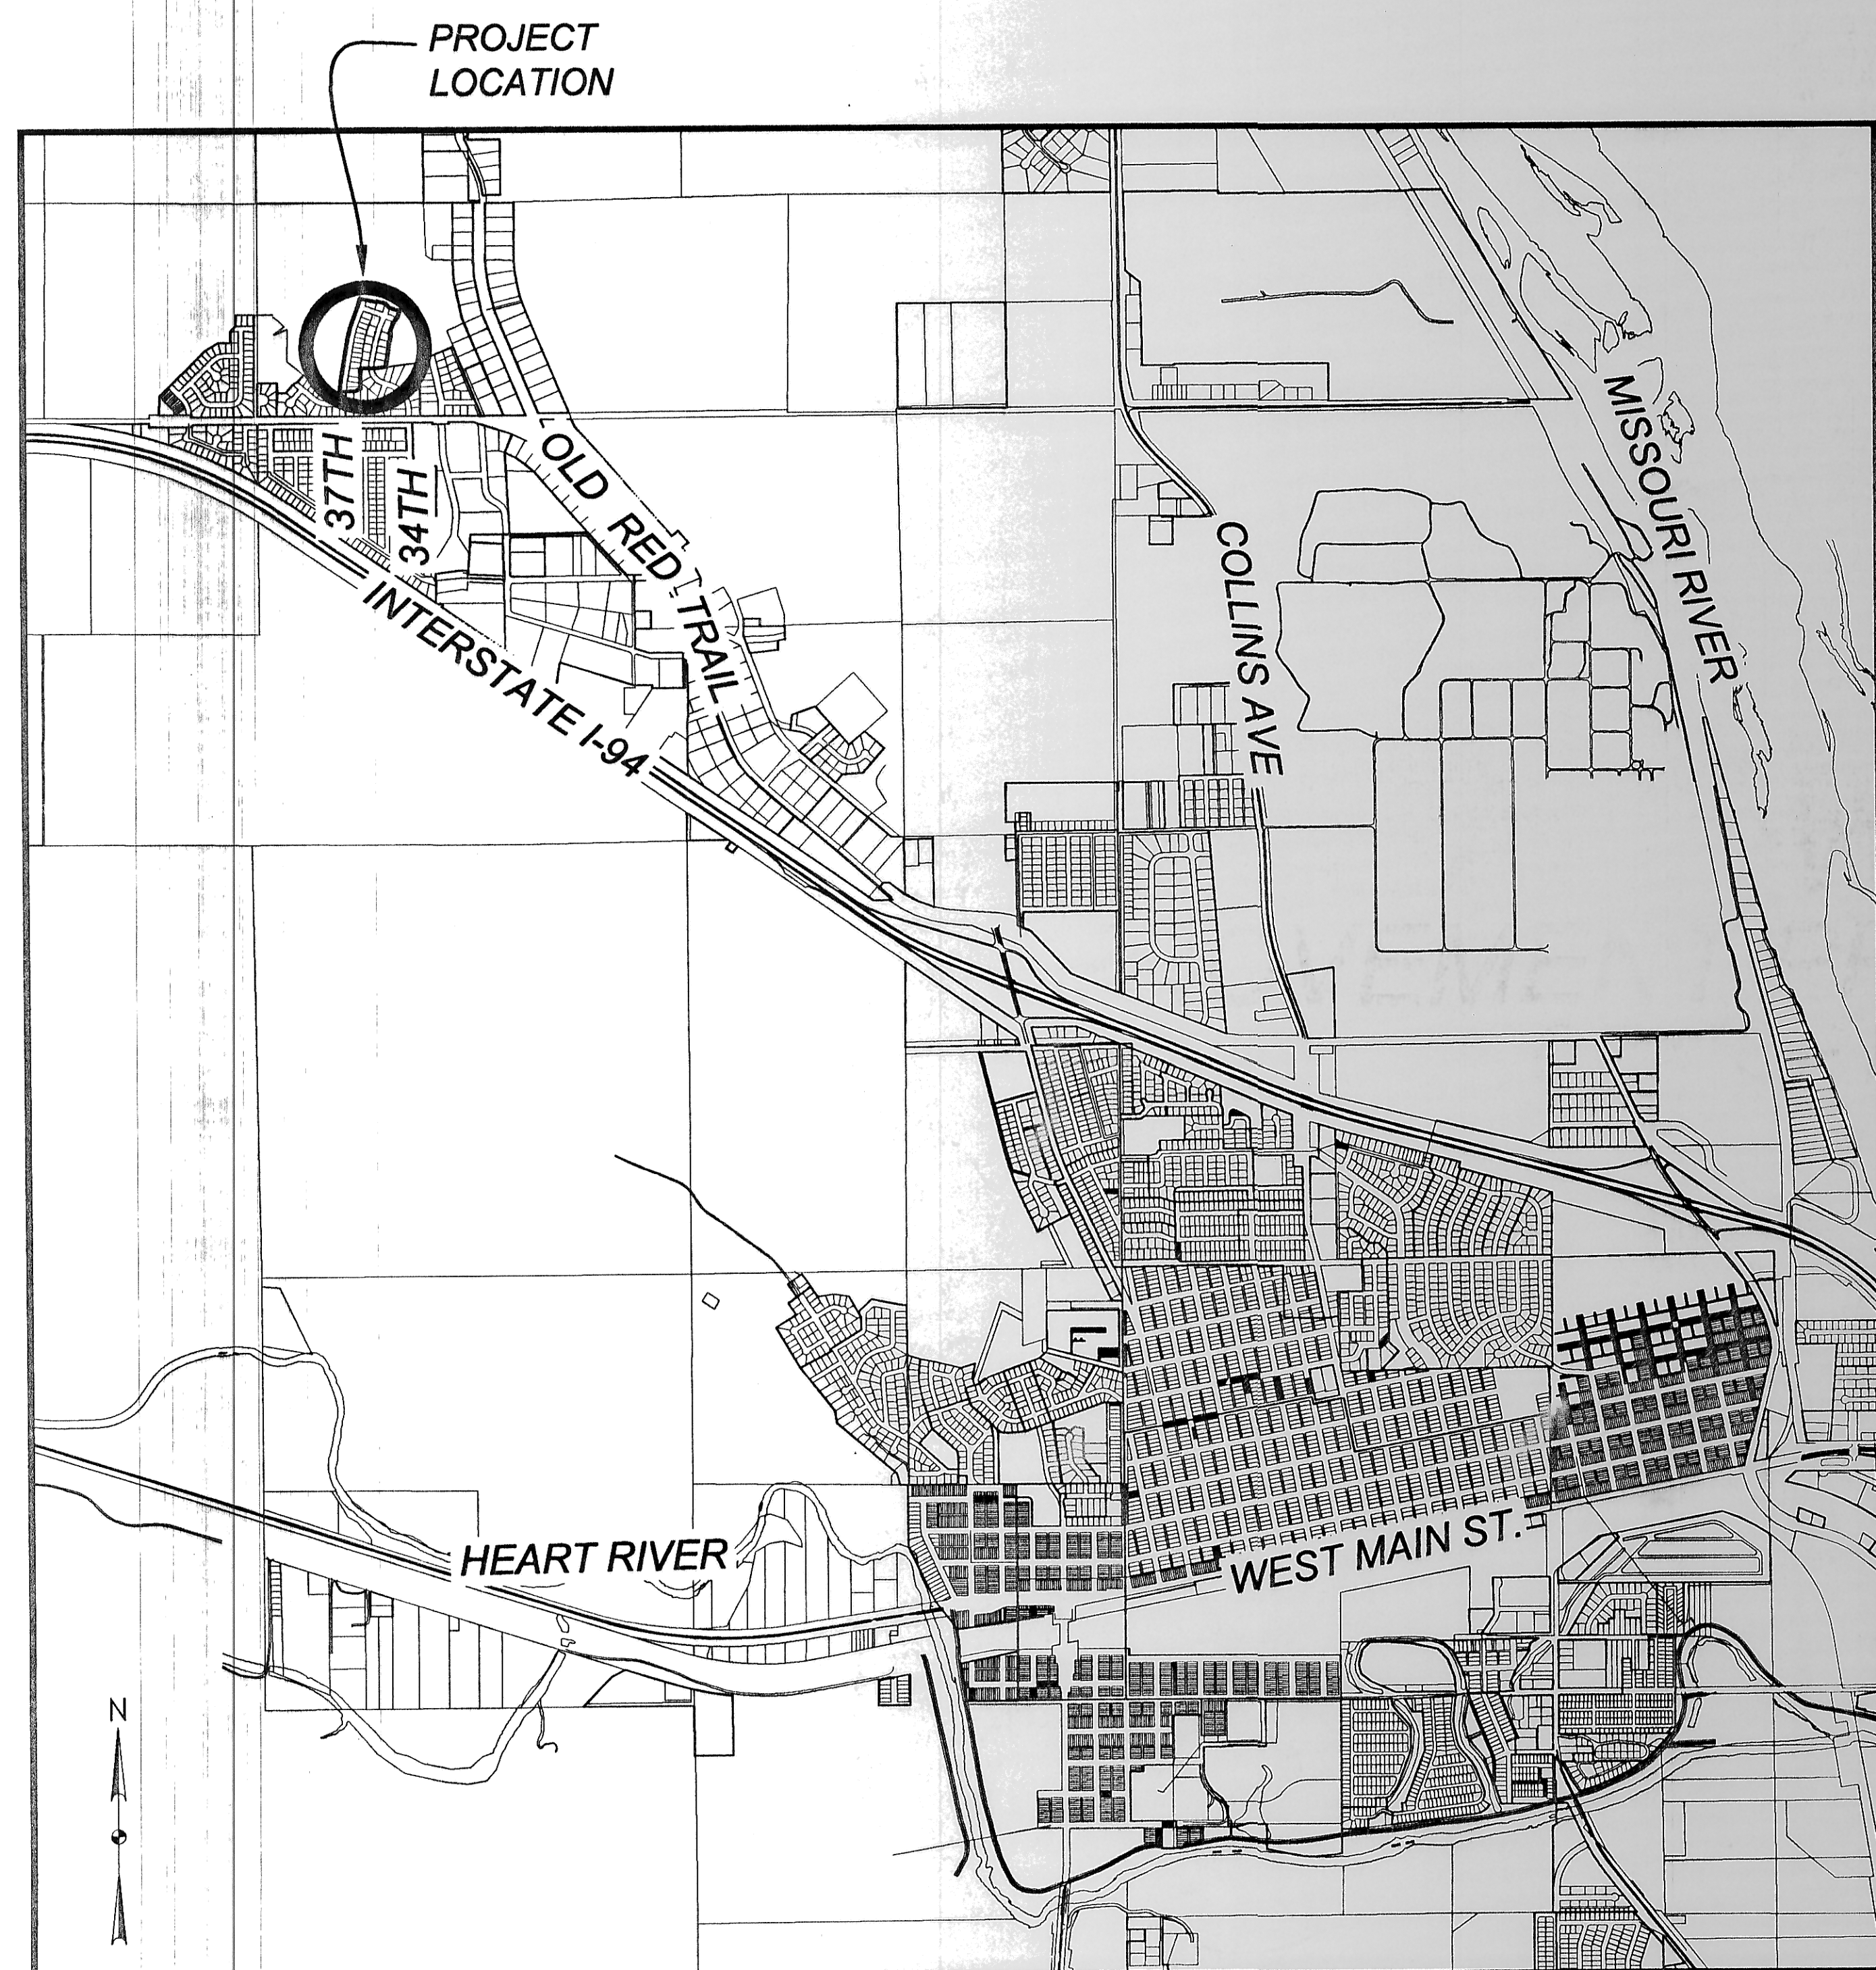

NO SCALE

PROJECT AREA

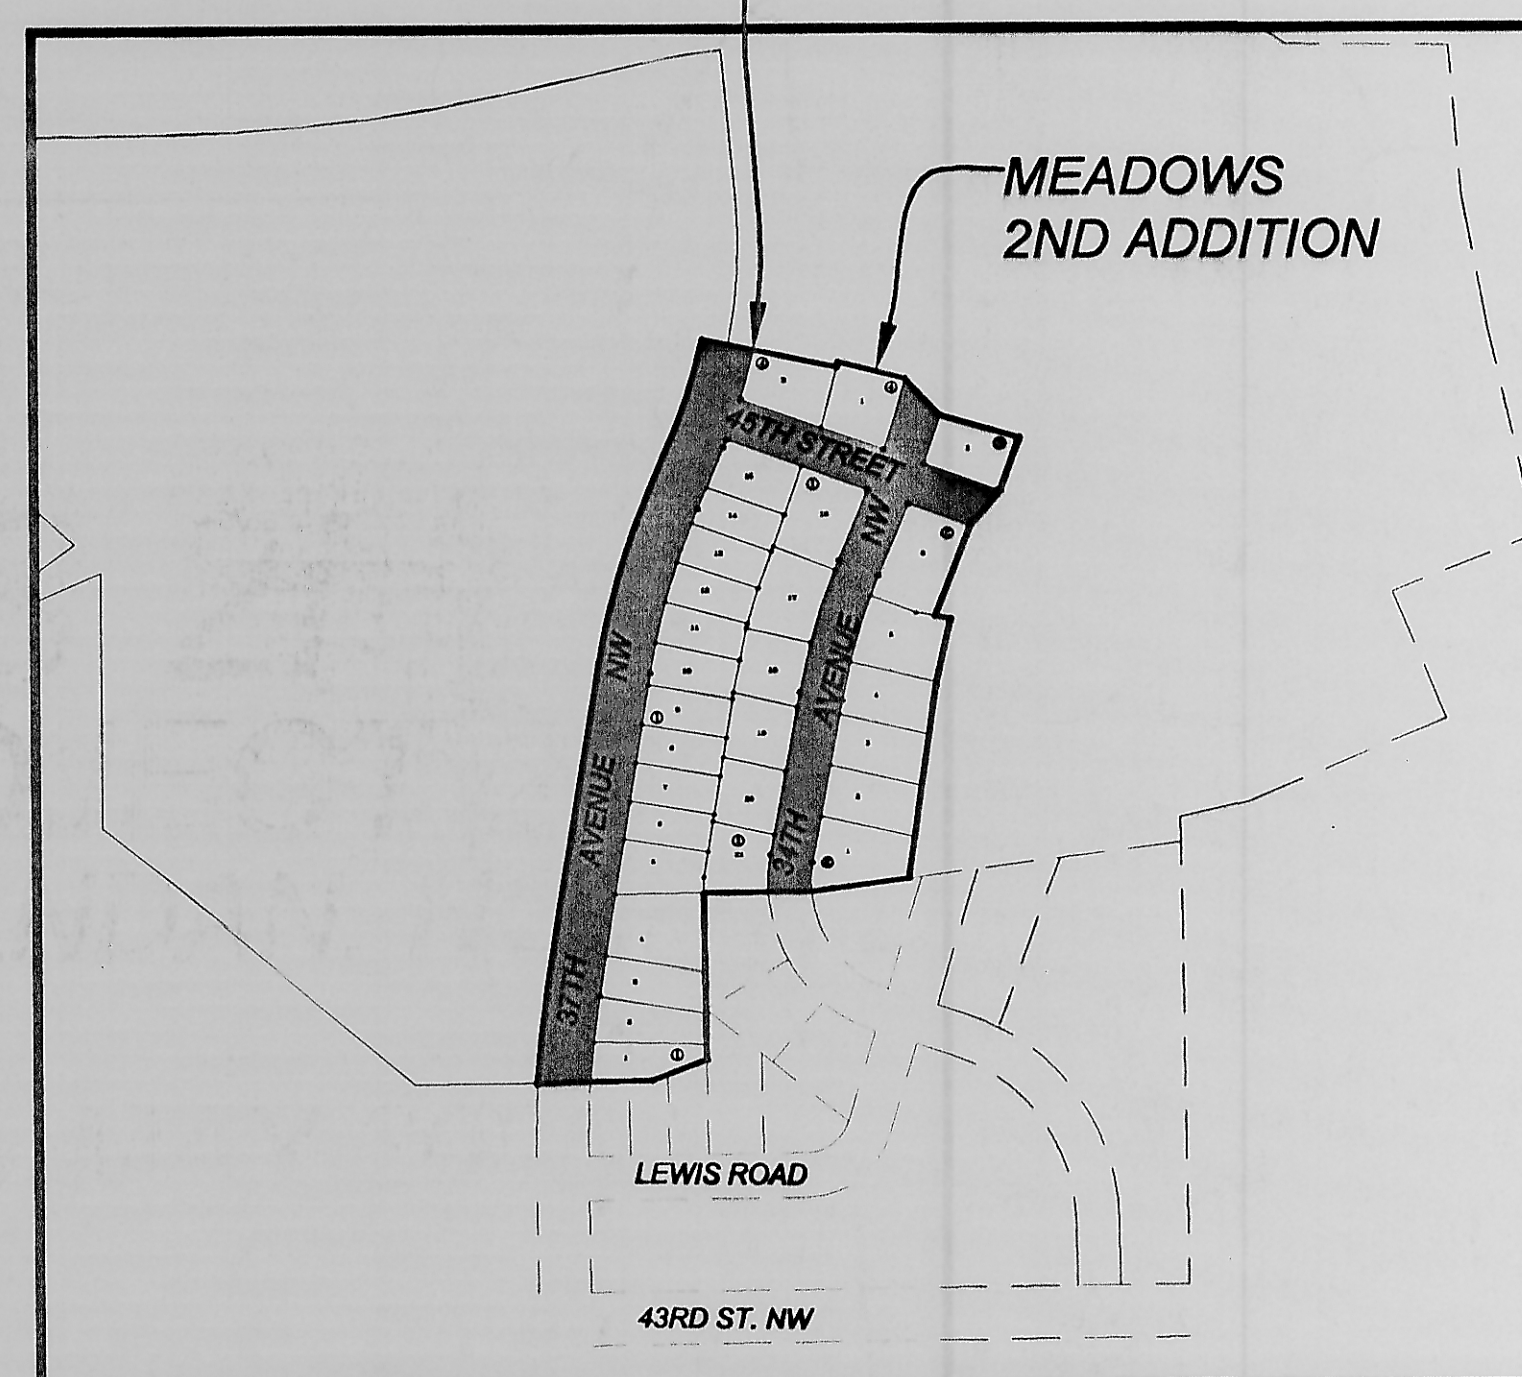

NO SCALE

RECORD DRAWING

prepared for:
CITY OF MANDAN

prepared by:
KADRMAS, LEE & JACKSON, INC.
128 Soo Line Drive
Box 1157
Bismarck, ND 58502
Ph. (701) 355-8400

**Kadmas
Lee &
Jackson**
Engineers Surveyors
Planners