

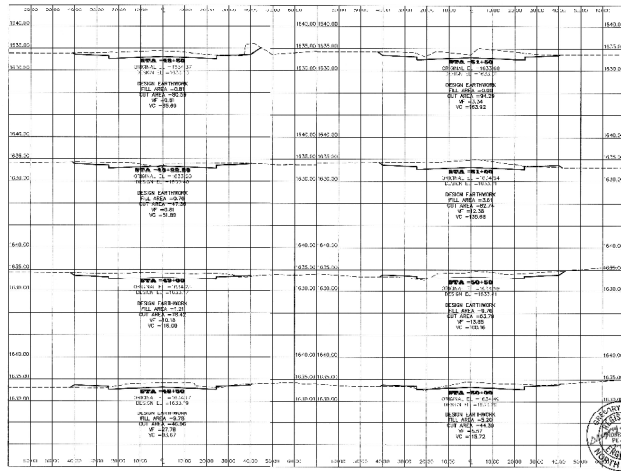
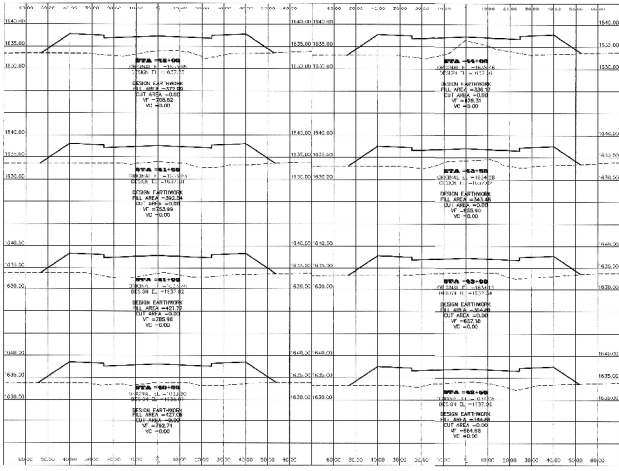


CROSS SECTIONS ON 40TH AVENUE SE
DISTRICT 133 PROJECT 2005-16

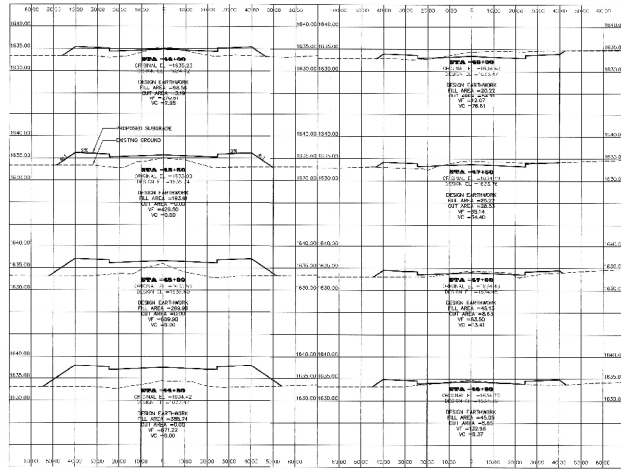

ISSUED BY: NEW
CHECK BY: JES/DF
DATE: 08-10-05
FILE: 050516
PWA
COMPUTER FILE:
SHEET FILE:

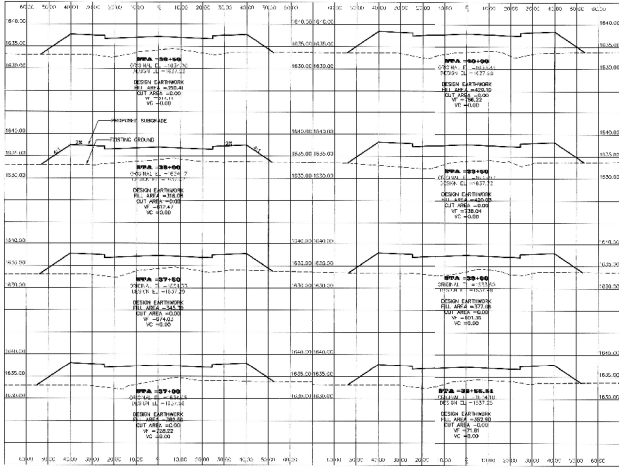

SHEET
C16
OF 18

Record Drawing

\\p01011\drawings\2005\133\40th\11\110516.dwg, 07/29/07 11:48:07 AM