

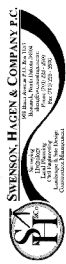
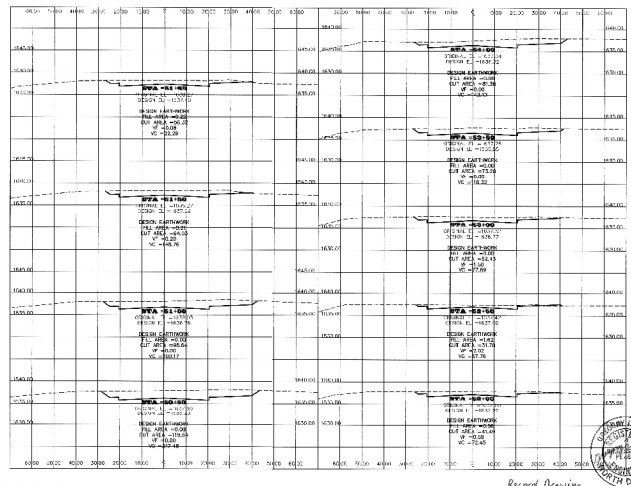
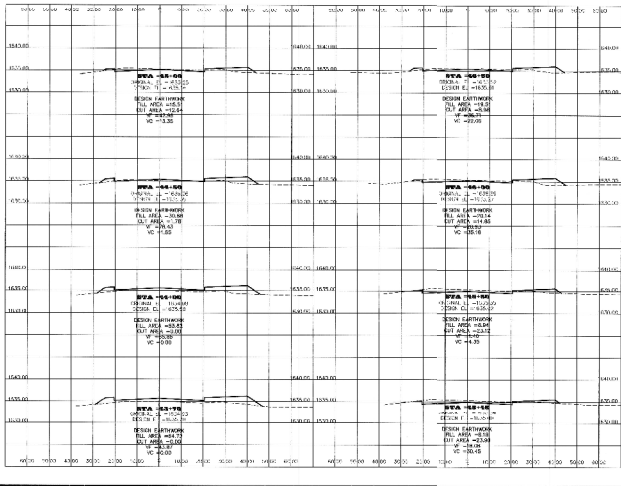


CROSS SECTIONS ON 19TH STREET SE
DISTRICT 133 PROJECT 2005-16

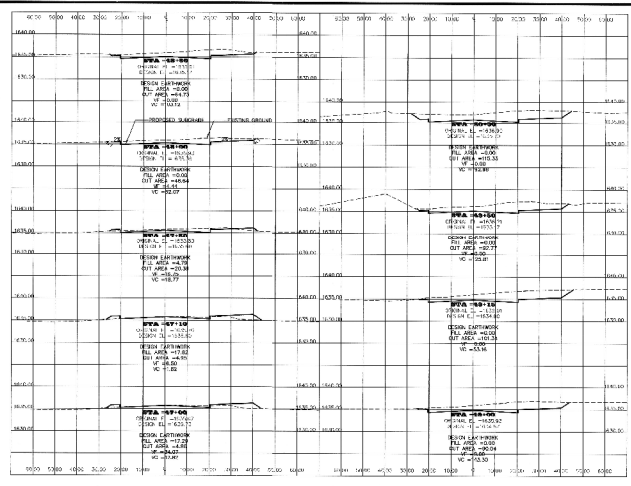

DRAWN BY: JPL
CHECK BY: JRS/SL
DATE: 05-10-05
FILE NO: 133-0000
COMPUTER FILE:
SUNNY FILE:

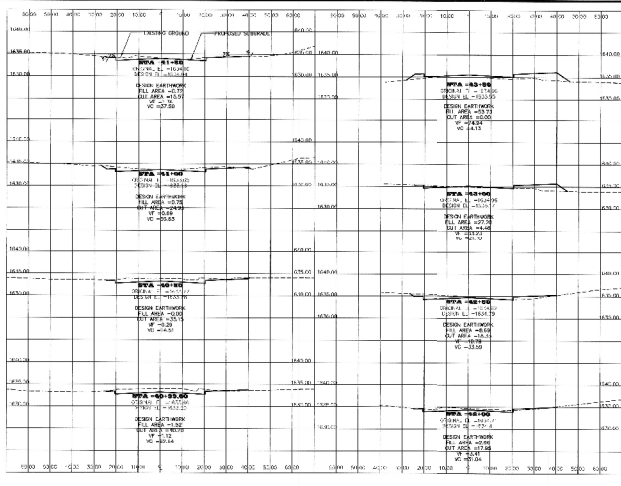

SHEET
C17
OF 19

Revised Accuracy

F:\Projects\2005\133\133-0000\133-0000.dwg, 05/10/05 11:13:16 AM