
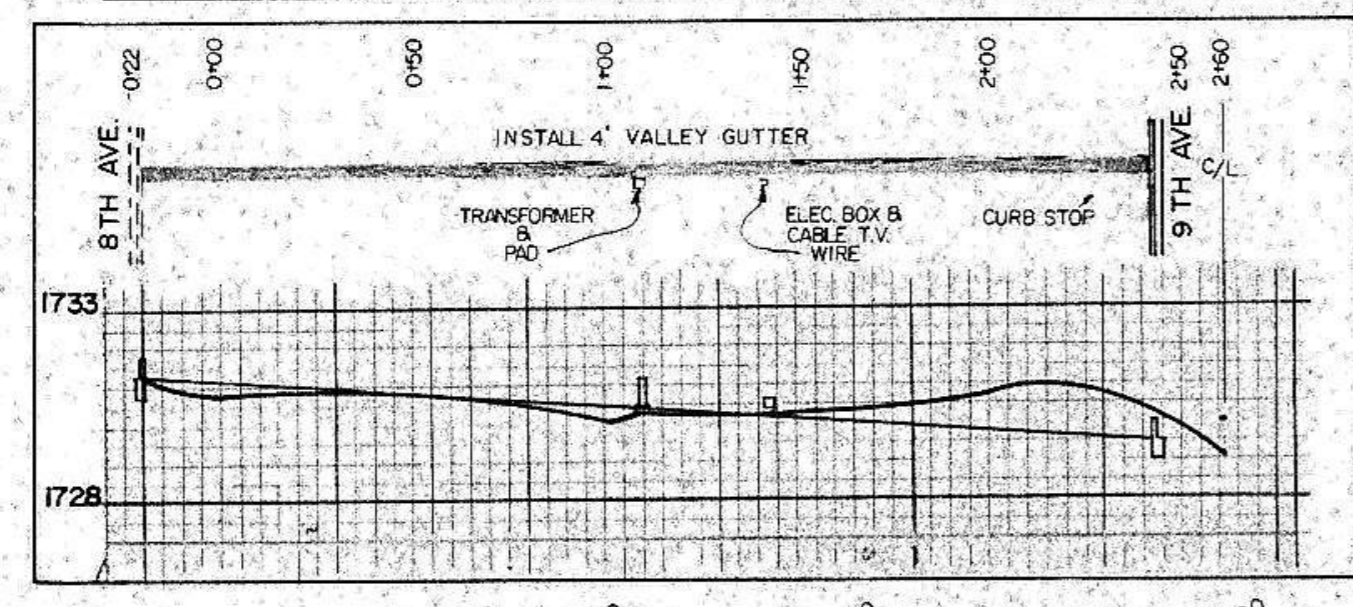




PLAN
 SURVEYED BY: _____
 DATE: _____
 NOTE BOOK NO.: _____
 DRAWING CHECKED BY: _____
 DATE: _____

PROFILE
 SURVEYED BY: _____
 DATE: _____
 NOTE BOOK NO.: _____
 DRAWING CHECKED BY: _____
 DATE: _____

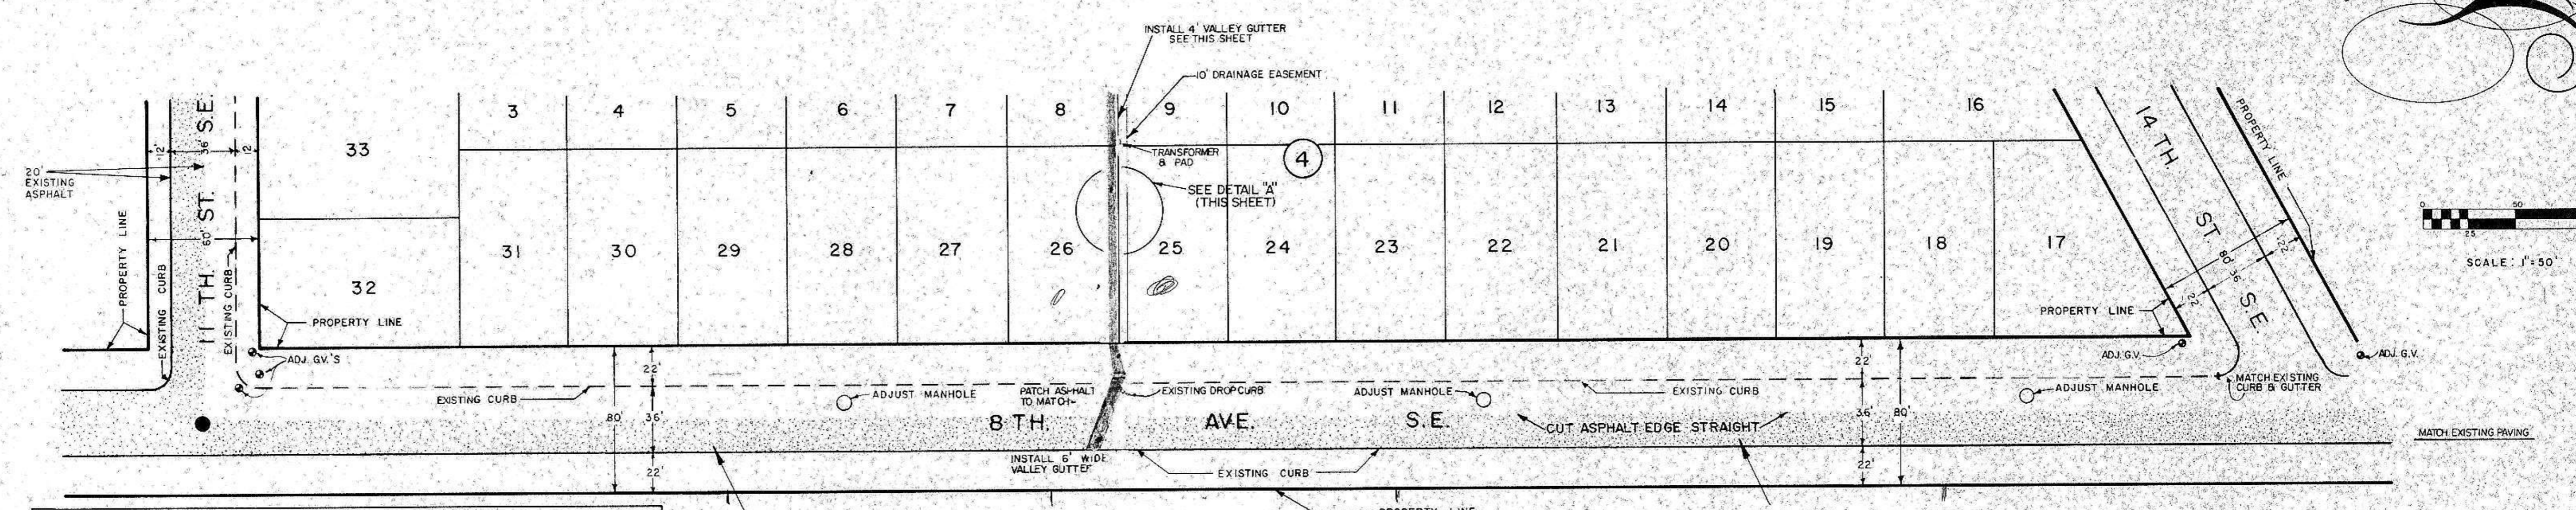

NOTE: ALL RADII 12' UNLESS OTHERWISE NOTED.

NOTE: All streets on this sheet are cut or filled to within 6" of proposed street grade.

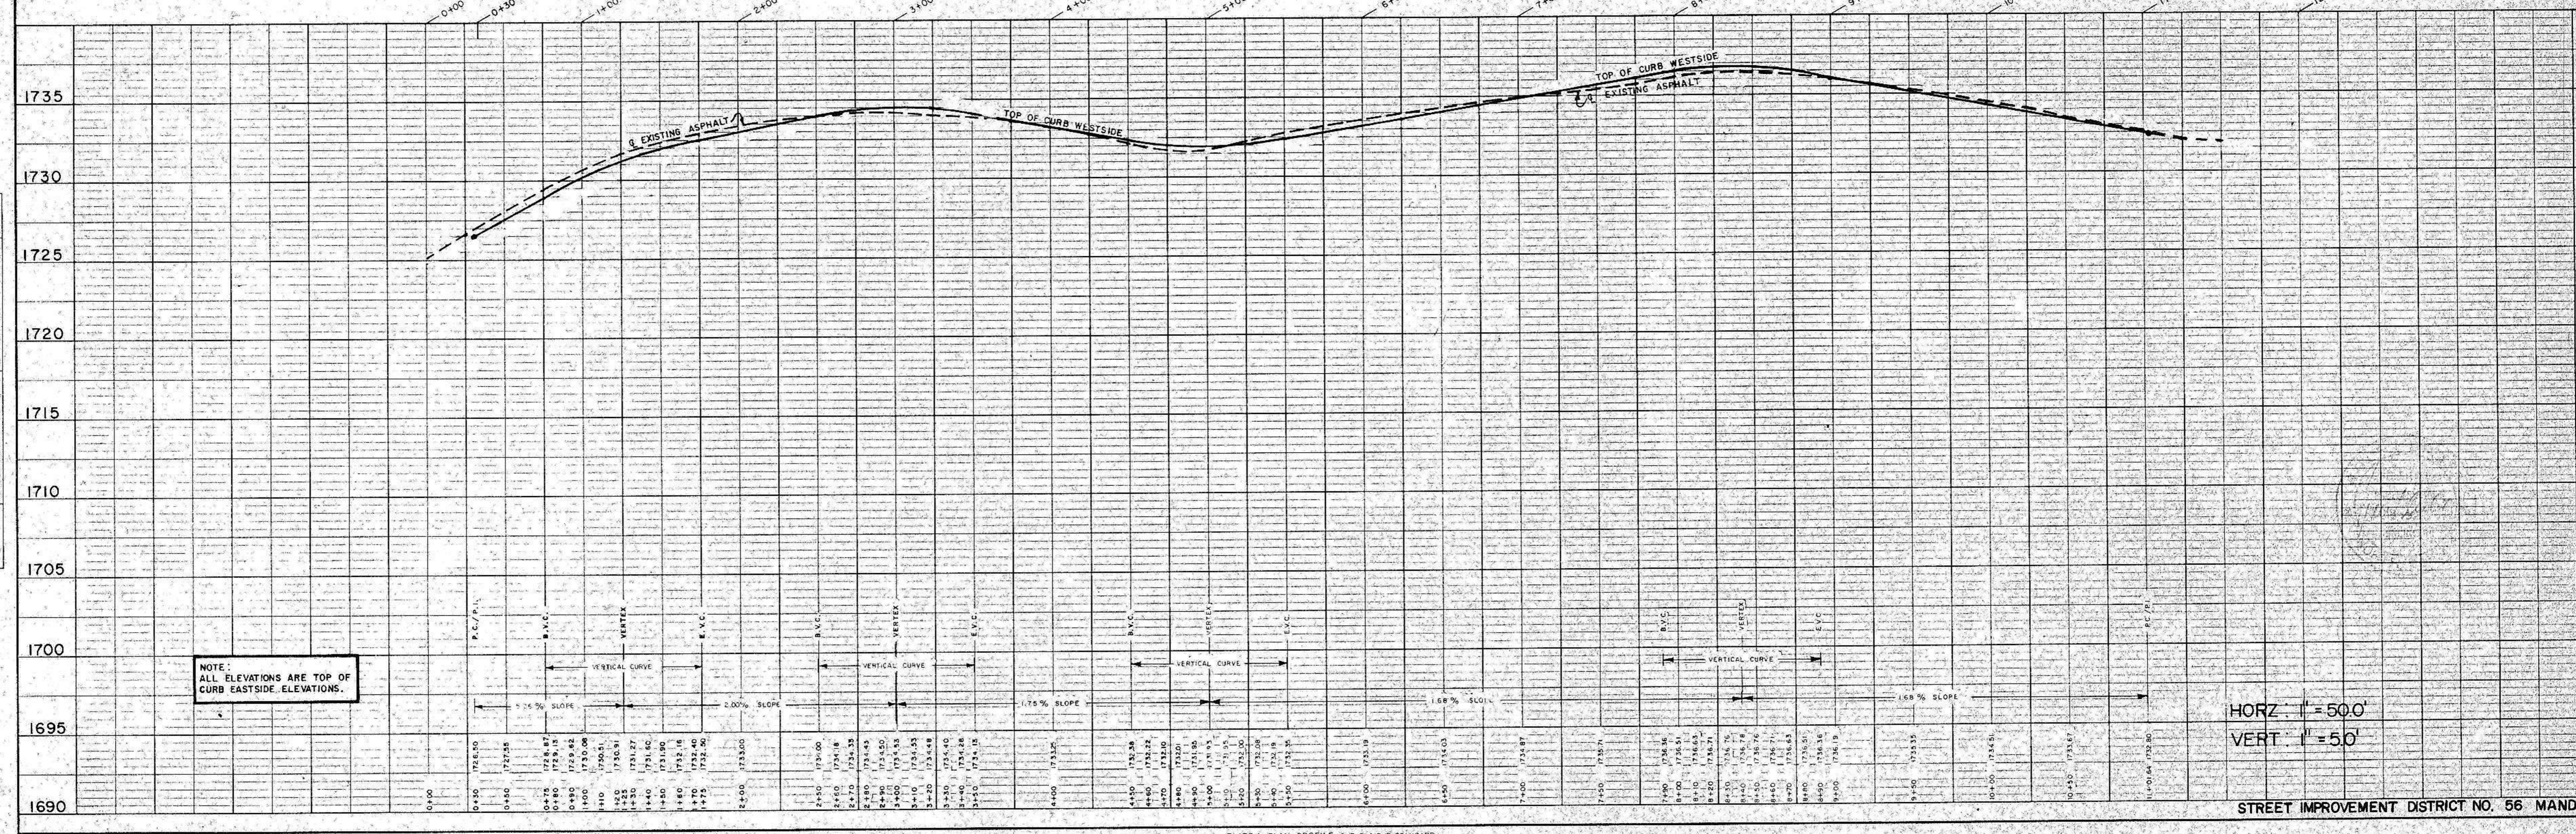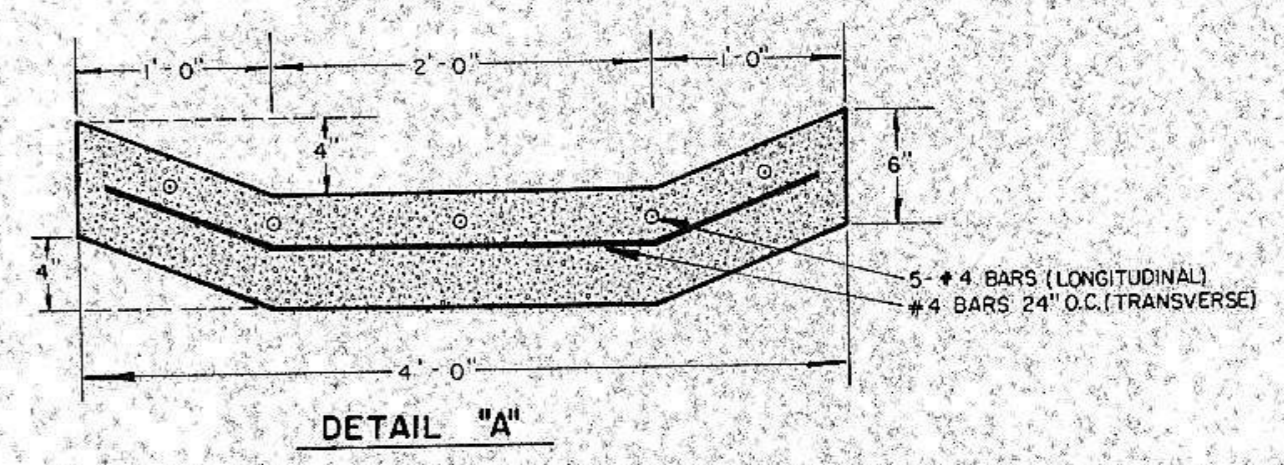

NOTE: ALL ELEVATIONS ARE TOP OF CURB EASTSIDE ELEVATIONS.

HORIZ. 1" = 50.0'
 VERT. 1" = 5.0'