


PLAN
 DATE: _____
 BY: _____
 CHECKED: _____
 NO. _____

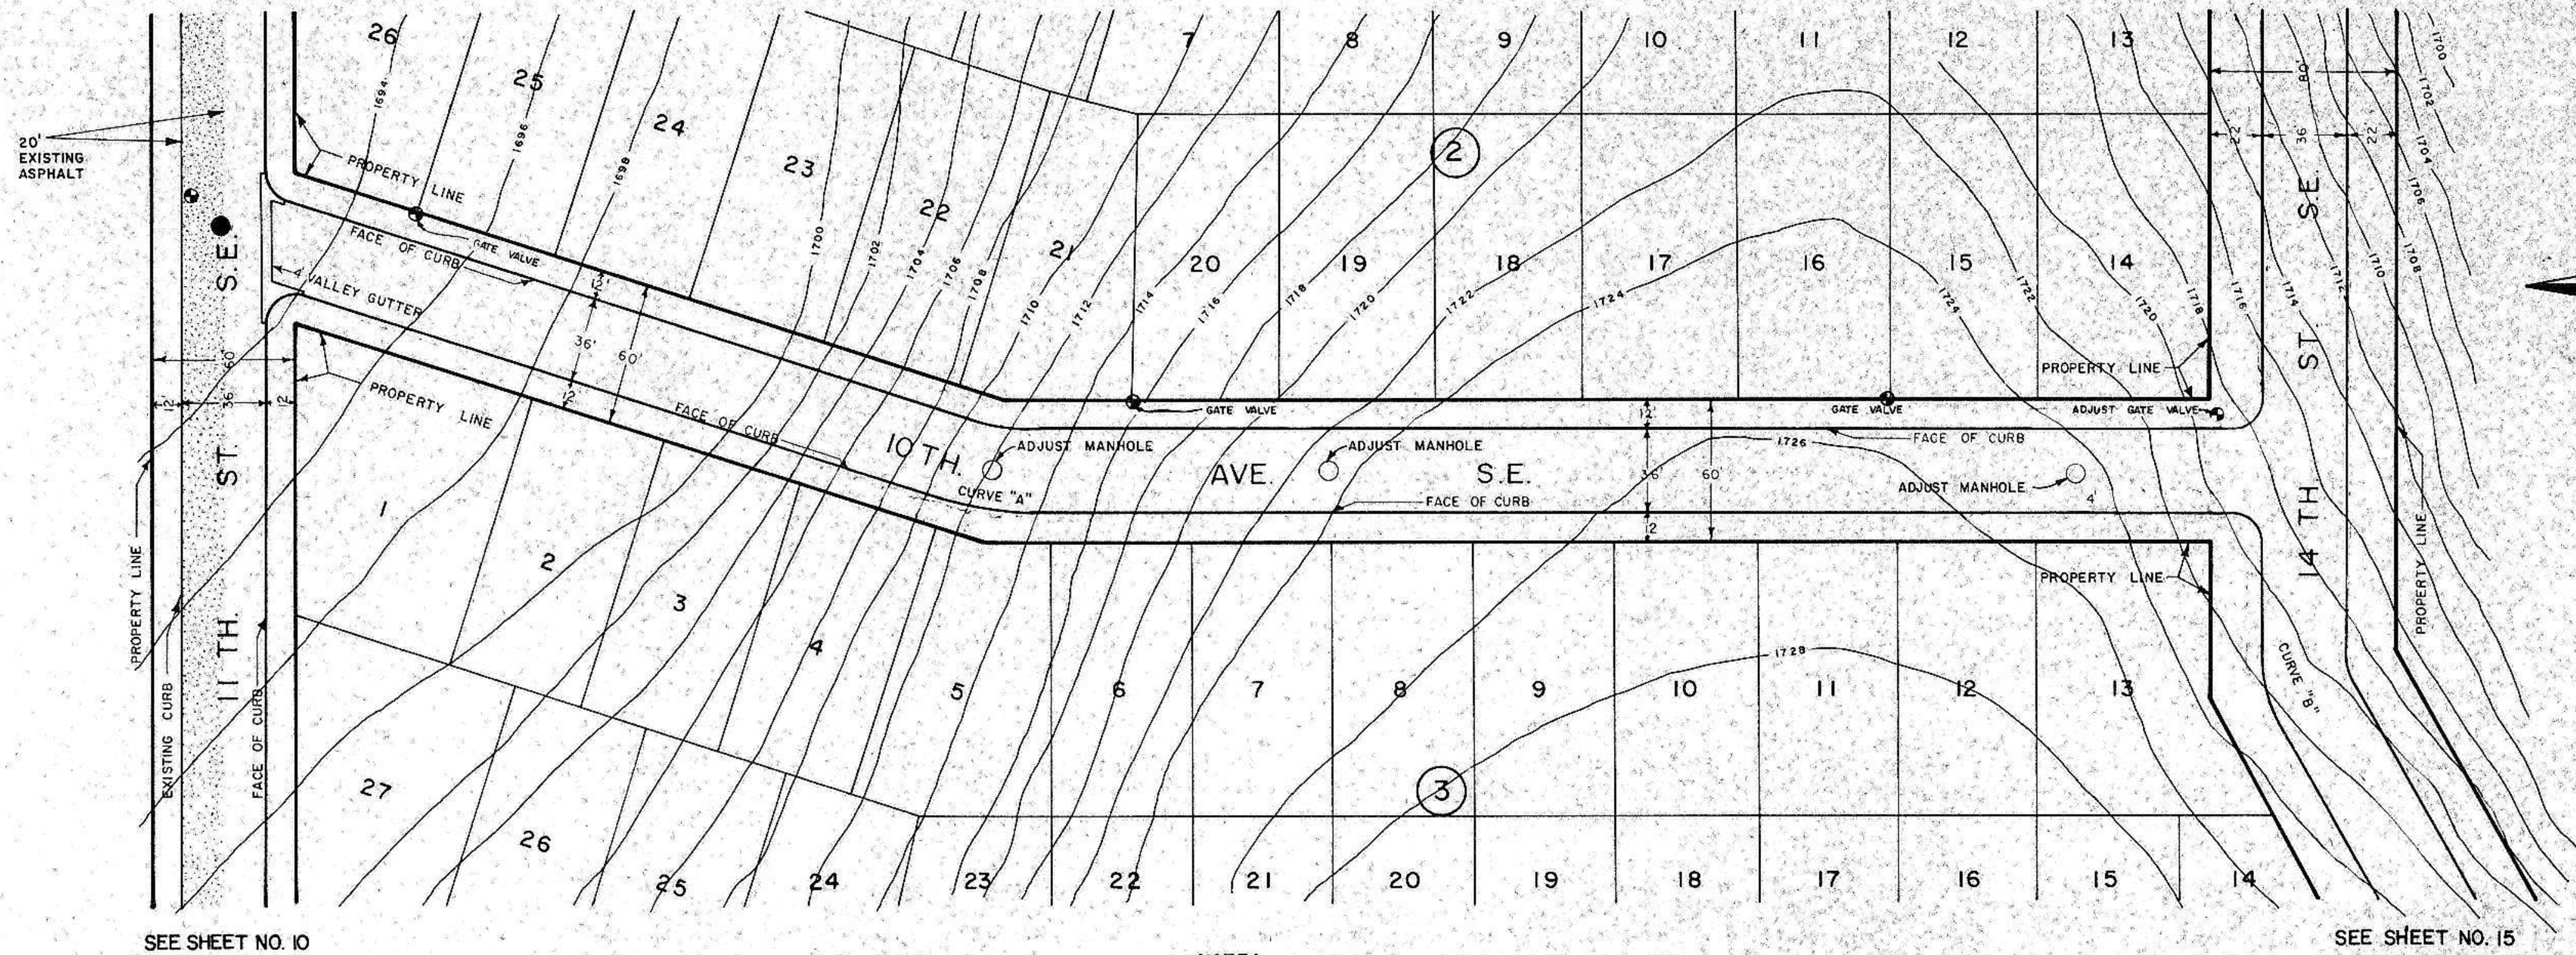

SEE SHEET NO. 10


NOTE: All streets on this sheet are cut or filled to within 6"± of proposed street grade.

NOTE: ALL RADII 12' UNLESS OTHERWISE NOTE.
 9th, 10th, 11th, AVENUES TO HAVE SURMOUNTABLE CURB.

CURVE "A" - ∞ 100' RADIUS
 CURVE "B" - ∞ 40' RADIUS

SEE SHEET NO. 15

PROFILE
 DATE: _____
 BY: _____
 CHECKED: _____
 NO. _____

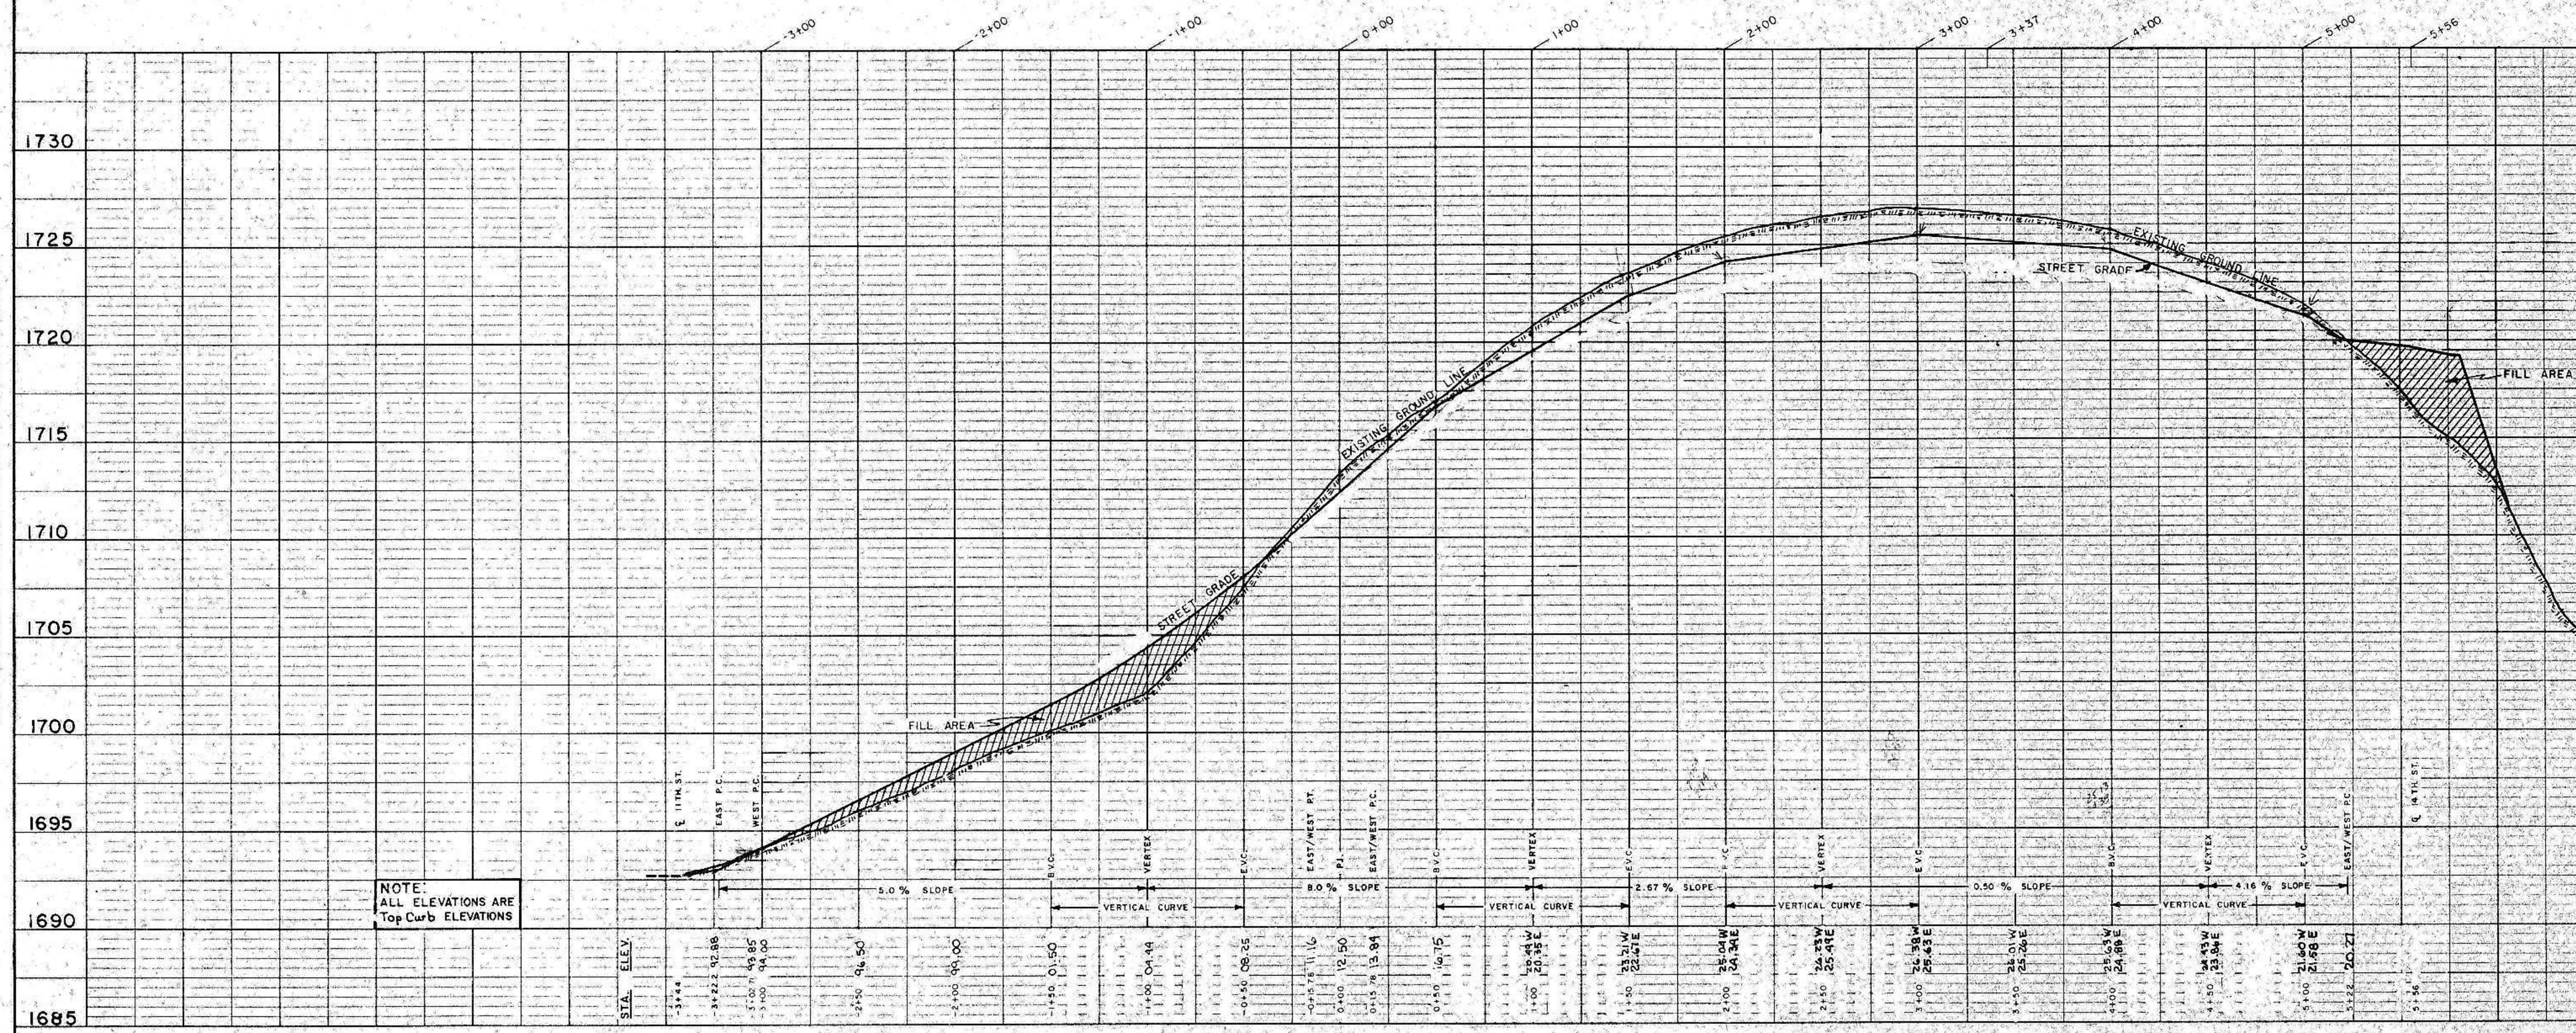

NOTE: ALL ELEVATIONS ARE Top Curb ELEVATIONS

HORZ. 1"=50.0'
 VERT. 1"=5.0'

STREET IMPROVEMENT DISTRICT NO. 56 MANDAN

PLATE 1-PLAN-PROFILE (O.P.R. & R.E. STANDARD)
 KEUFFEL & ESSER CO., NEW YORK

ASBUILT CONSTRUCTION DRAWINGS

SHEET NO. 13 OF 23 SHEETS

K. & E. Co. No. 347-IR ARRAVAL, ILL. MADE IN U.S.A. 2409