
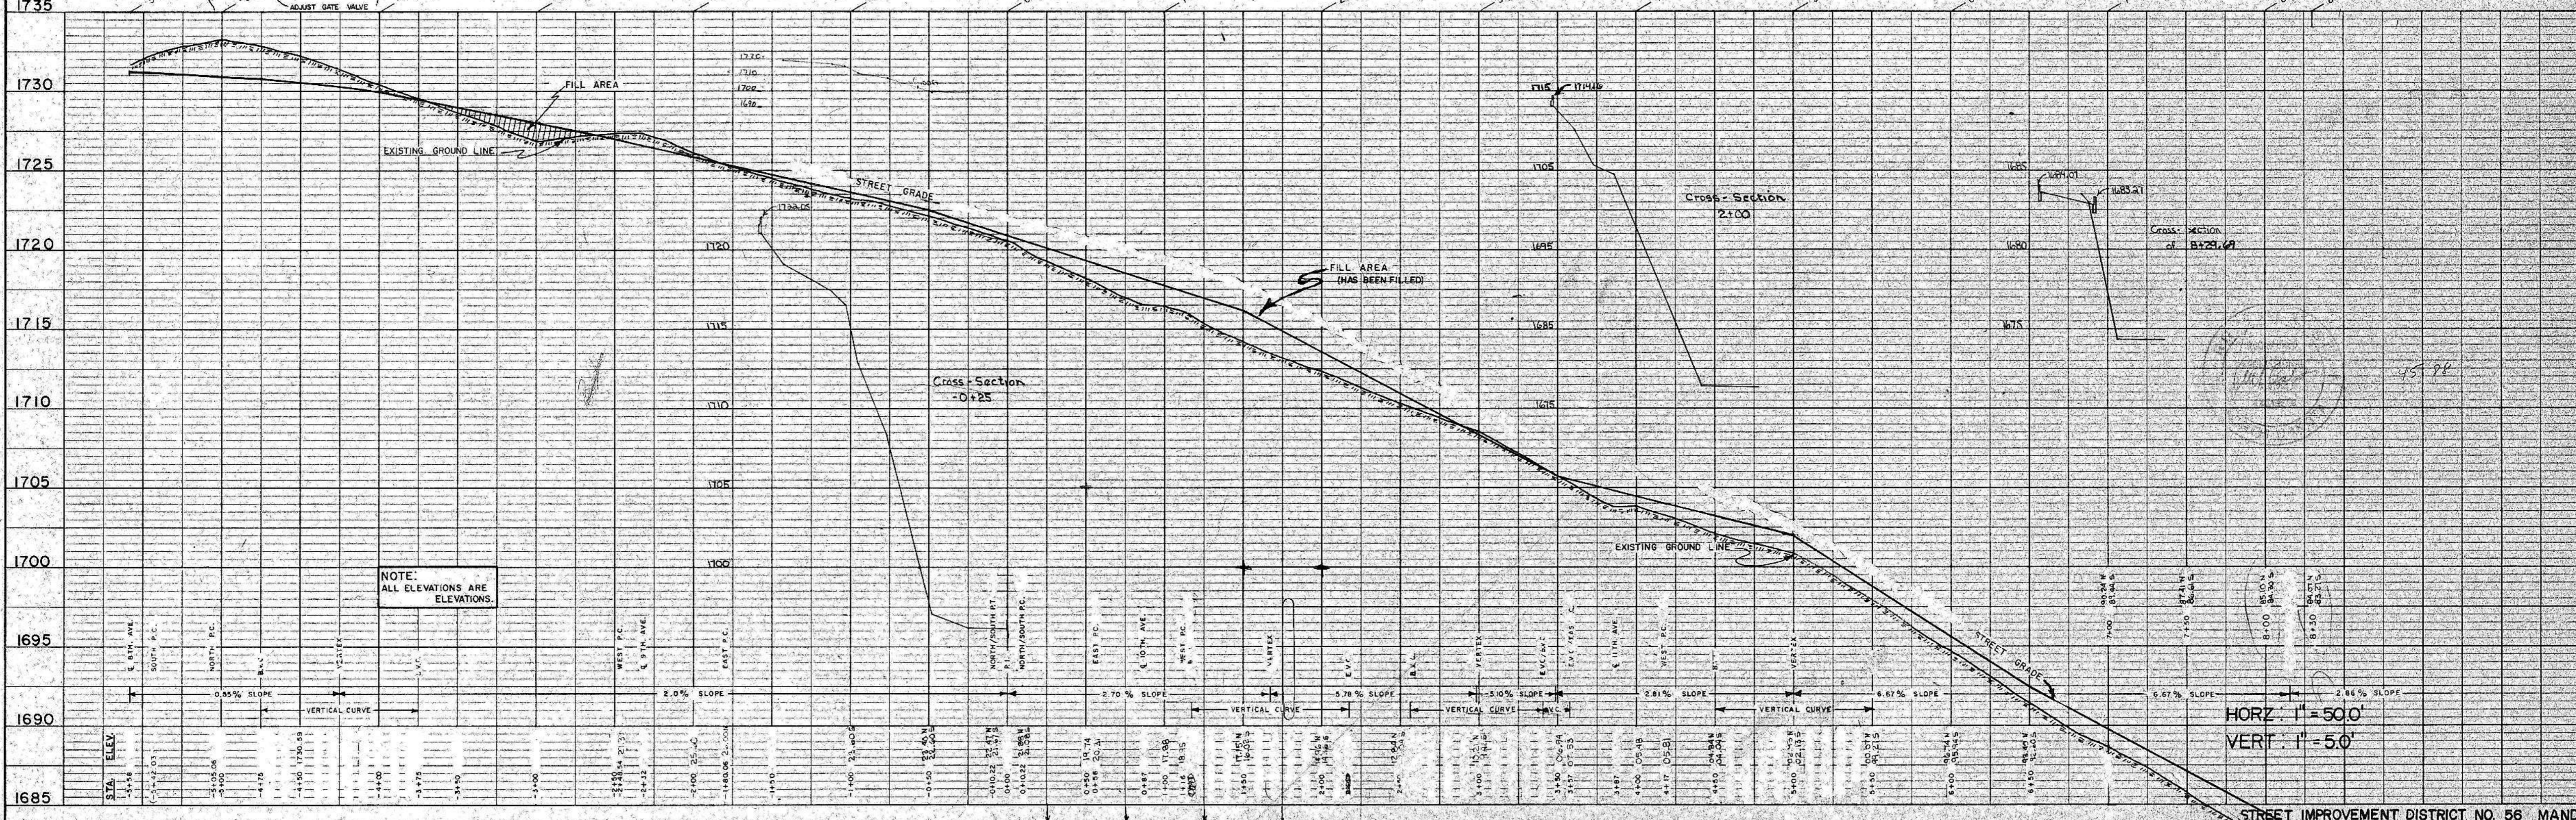


PLAN
 SURVEYED BY _____ DATE _____
 NOTE BOOK ALIGNMENT CHECKED _____
 NO. _____ RT. OF WAY CHECKED _____

PROFILE
 SURVEYED BY _____ DATE _____
 NOTE BOOK GRADES CHECKED _____
 NO. _____ STRUCTURE NOTATION CHECKED _____

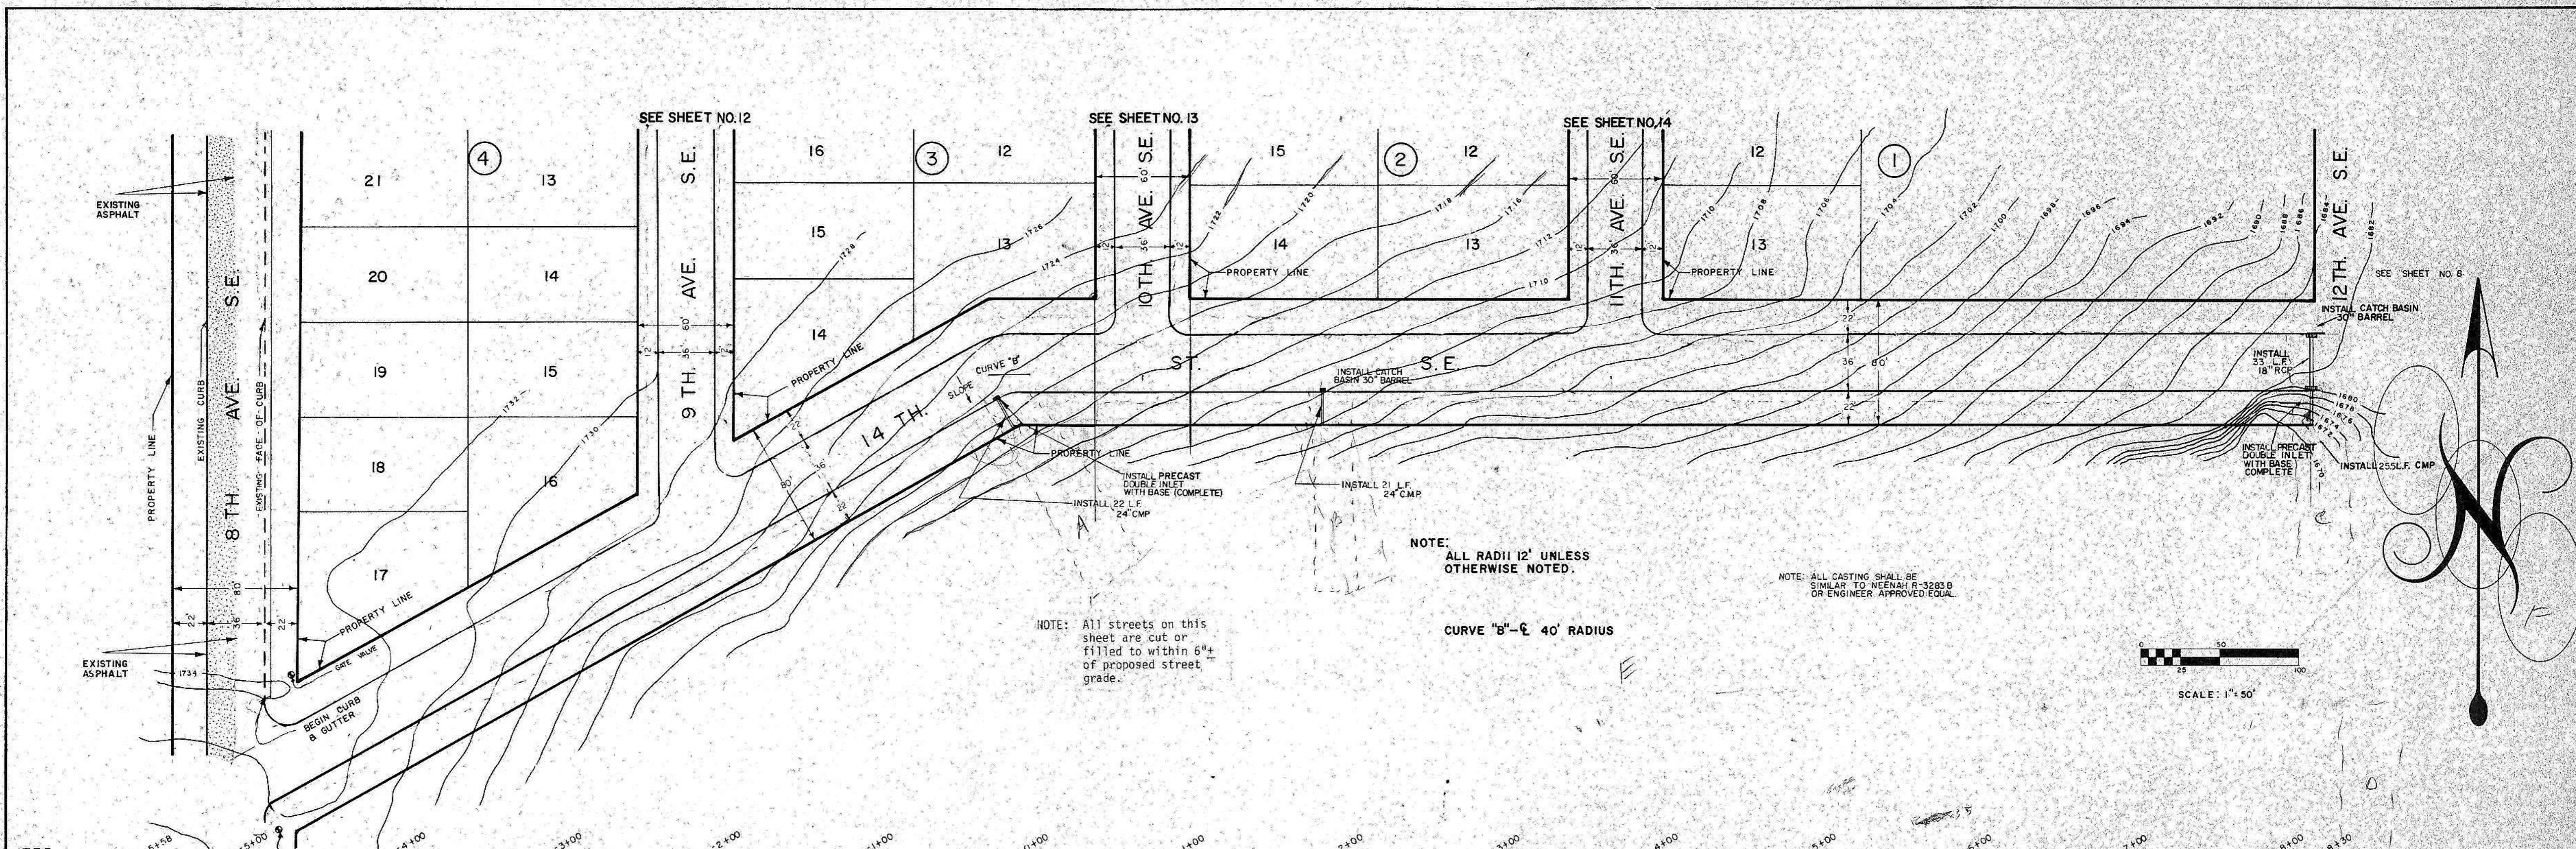

NOTE: All streets on this sheet are cut or filled to within 6"± of proposed street grade.

NOTE: ALL RADII 12' UNLESS OTHERWISE NOTED.

CURVE "B" - R 40' RADIUS

NOTE: ALL CASTING SHALL BE SIMILAR TO NEENAH R-3283 B OR ENGINEER APPROVED/EQUAL

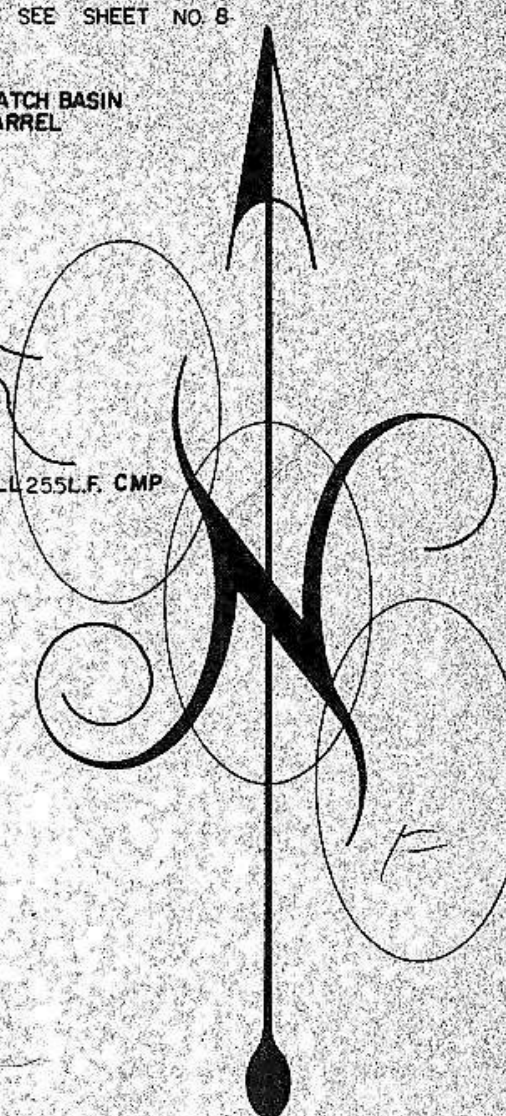
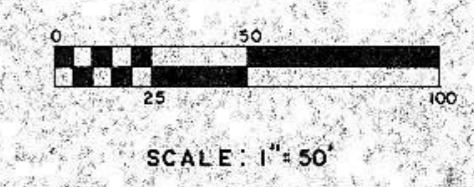


PLATE 1 - PLAN - PROFILE - P. R. & E. STANDARD
 KEUFFEL & ESSER CO., NEW YORK

SHEET NO. 15 OF 23 SHEETS

ASBUILT CONSTRUCTION DRAWINGS

STREET IMPROVEMENT DISTRICT NO. 56 - MANDALAY