

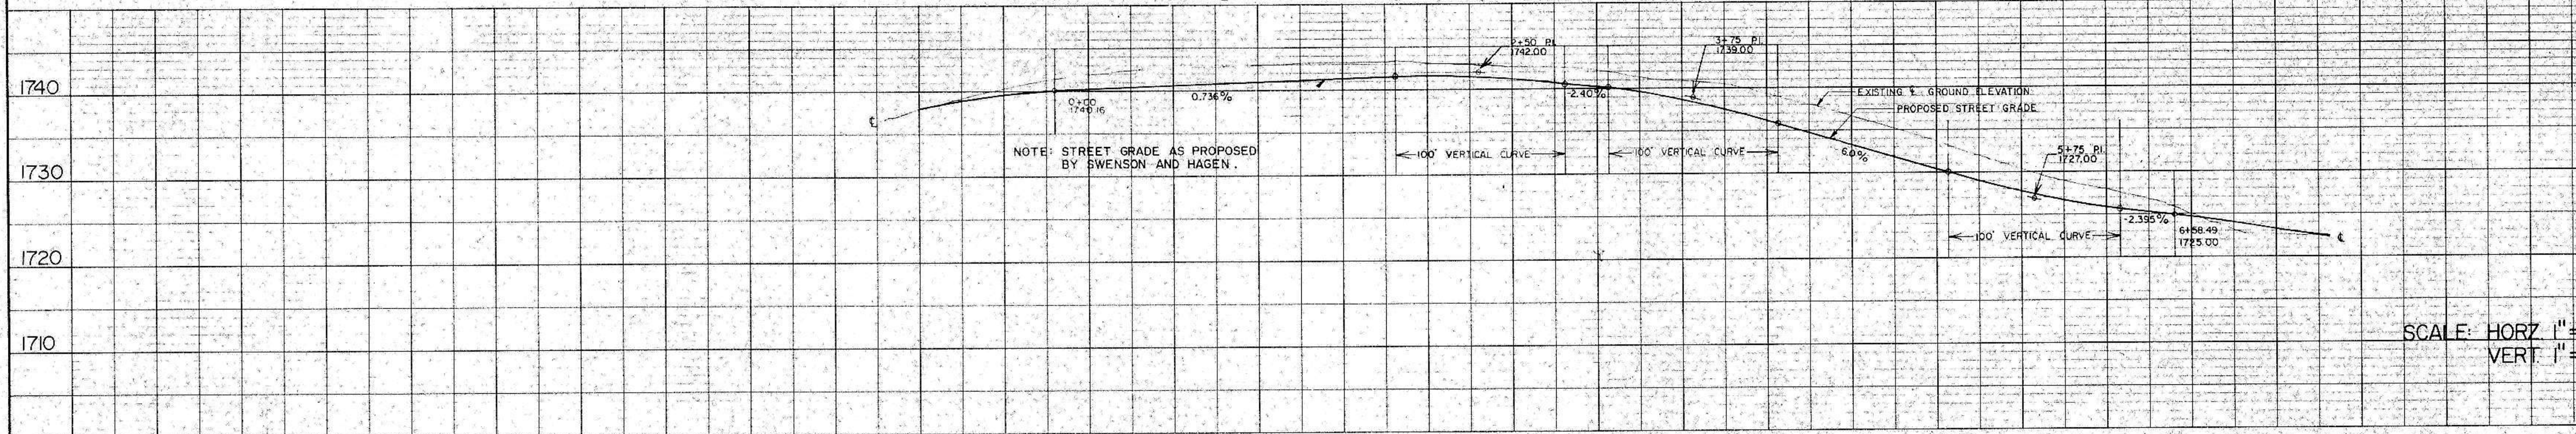
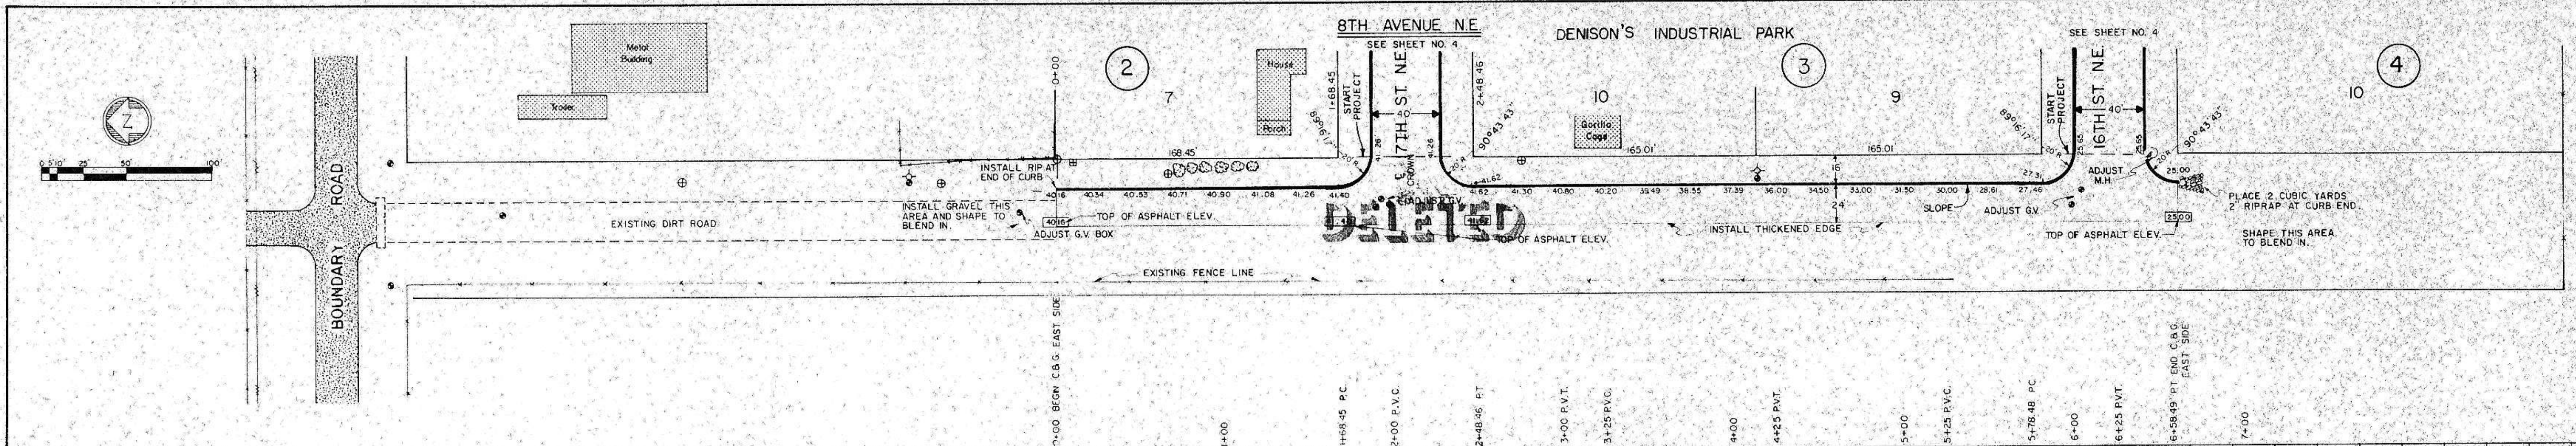


PLAN
 SURVEYED: _____
 PLOTTED: _____
 NOTE BOOK: _____
 NO. _____

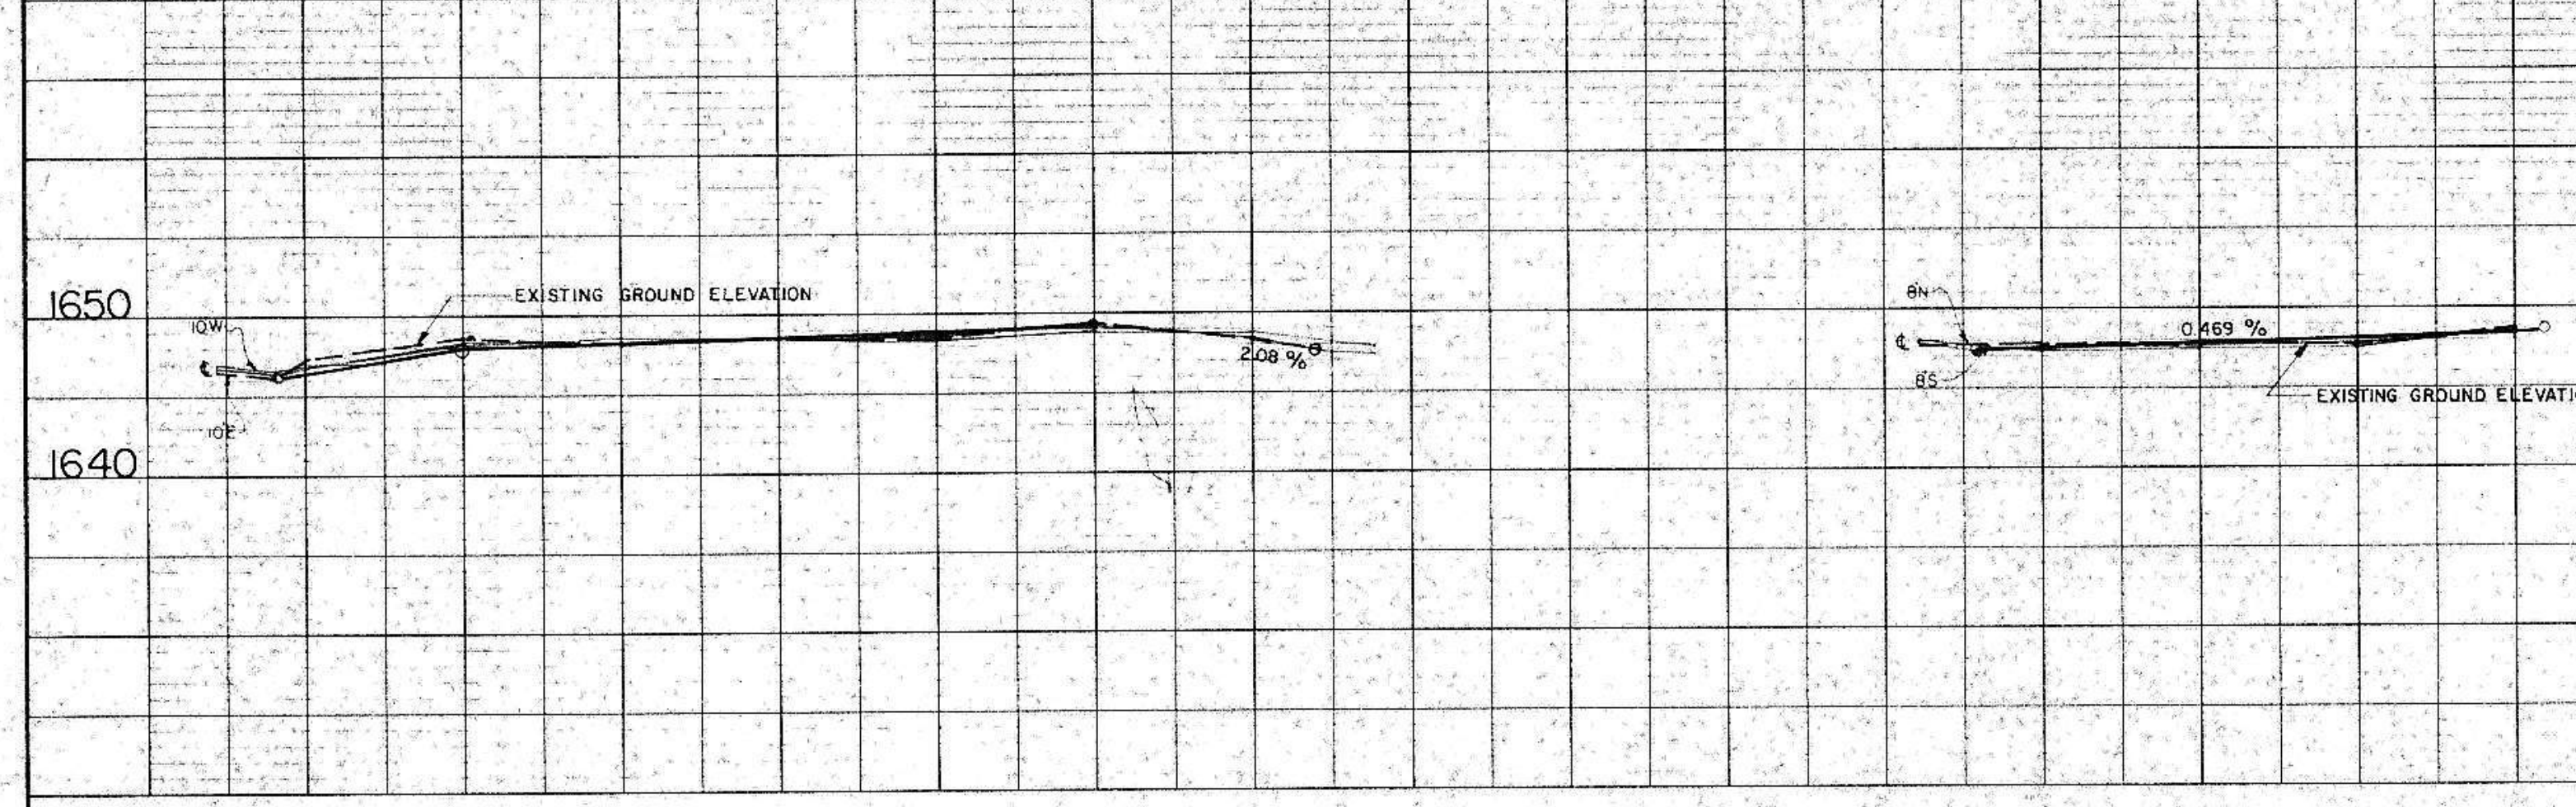

SCALE: HORIZ 1"=50'
 VERT 1"=10'

PROFILE
 SURVEYED: _____
 PLOTTED: _____
 NOTE BOOK: _____
 NO. _____

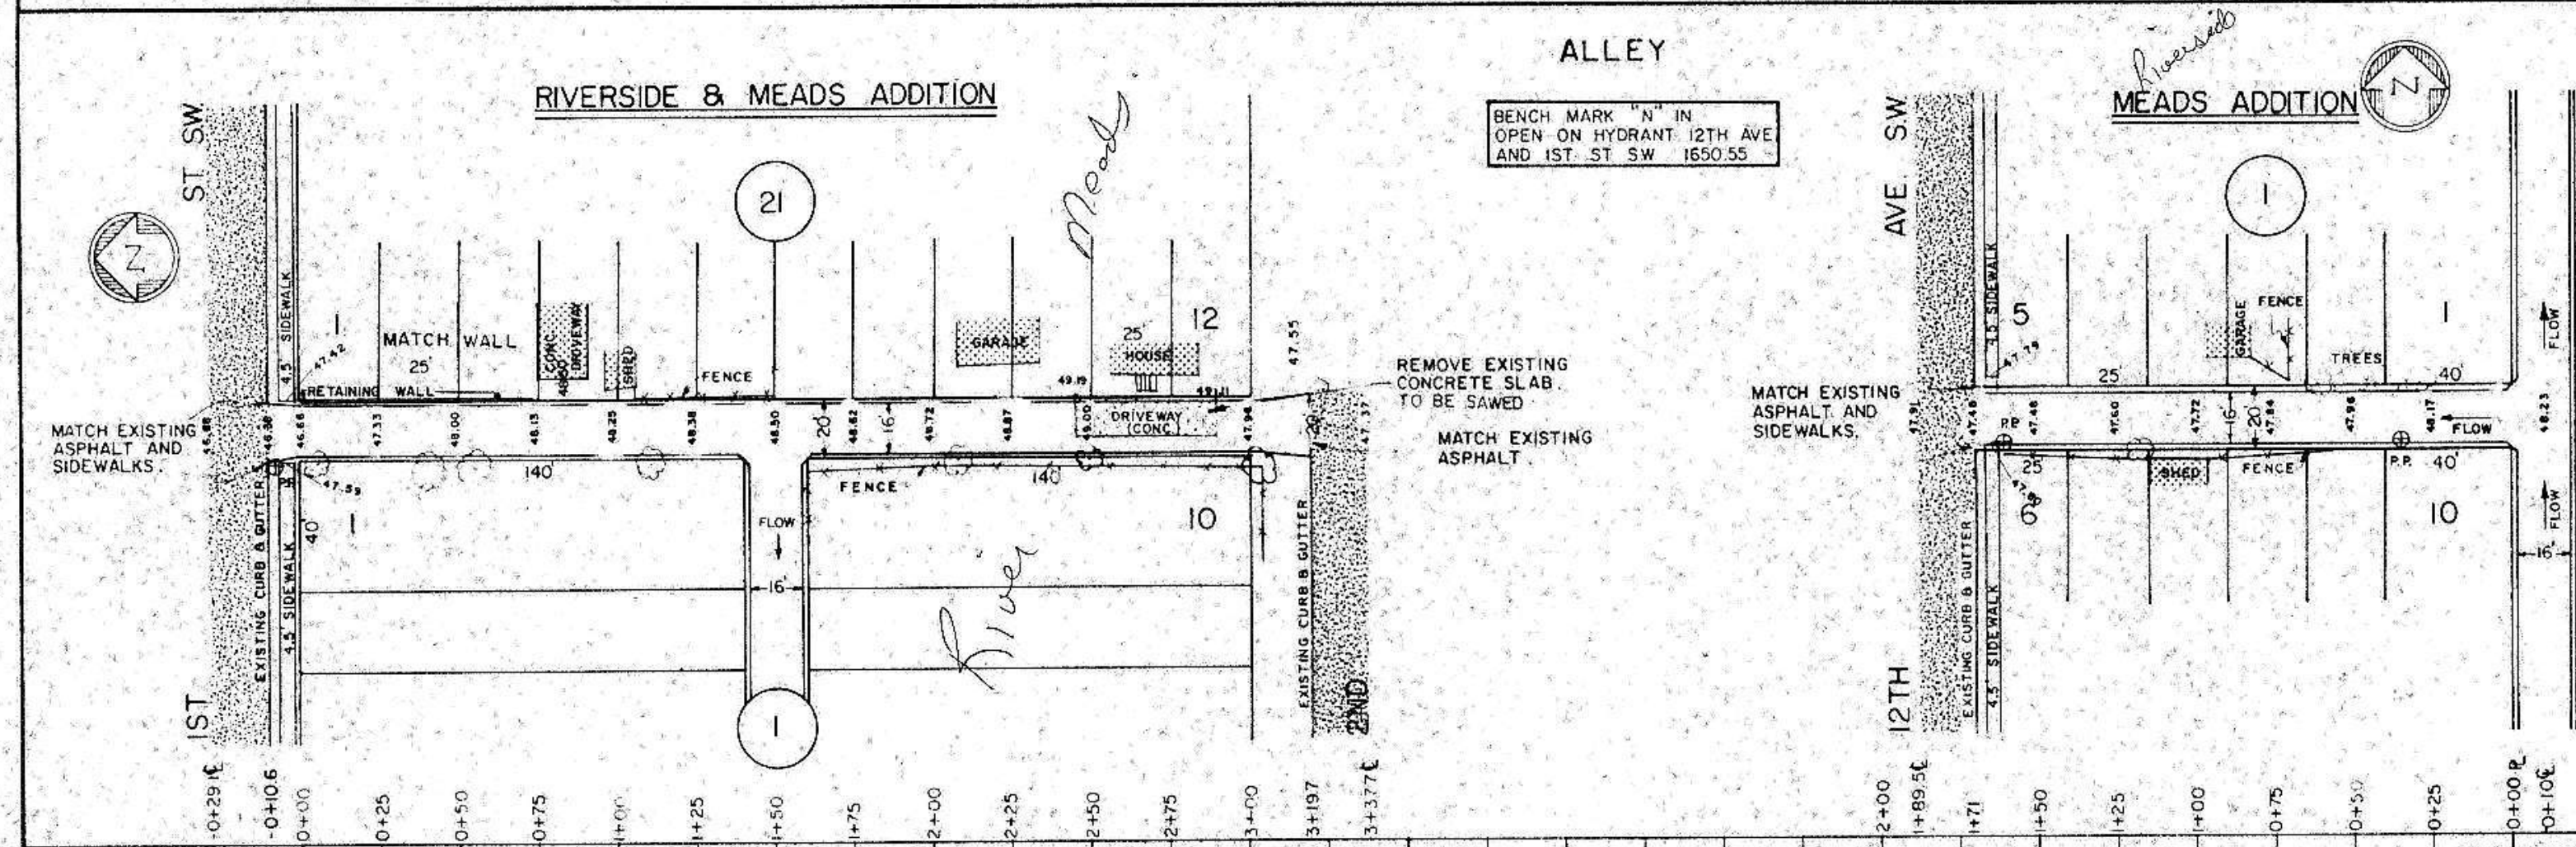

SCALE: HORIZ 1"=50'
 VERT 1"=10'