

DIVISION STREET (AREA 7)

AS-BUILT QUANTITIES

Area 7 (Division Street)


Earth Embankment	2605 C.Y.
Unclassified Earth Excavation	257 C.Y.
3 1/2" A.C. Base	4173 S.Y.
2" A.C. Wearing Course	4295 S.Y.
R.C. 800 Seal Oil	1951 S. Gal.
Chips at 30 Lbs./S.Y.	6505 S.Y.
Adjust Gate Valve	1 Each
Total	100 ACRES
Asphalt Removed	245 S.Y.
Curb and Gutter	1367 S.L.F.
6" Reinforced Concrete	502 S.F.
Concrete Removed	160 S.F.

NOTES:

- The remaining unpaved portion of Division Street shall have 3" base course and 2" surface course.
- Areas of existing asphalt on Division Street that are broken and in poor condition shall be patched. (Areas to be designated by engineer.)
- All existing asphalt edges shall be cut and tack oil applied before base course installation.
- The full width of Division Street shall receive a seal coat.

LEGEND

- MANHOLE
- HYDRANT
- VALVE BOX
- ▲ SIGN
- POWER POLE
- STREET LIGHT W/BASE
- GUY WIRE
- STREET LIGHT WIRE
- EXISTING CURB & GUTTER
- EXISTING ASPHALT
- NEW CURB & GUTTER

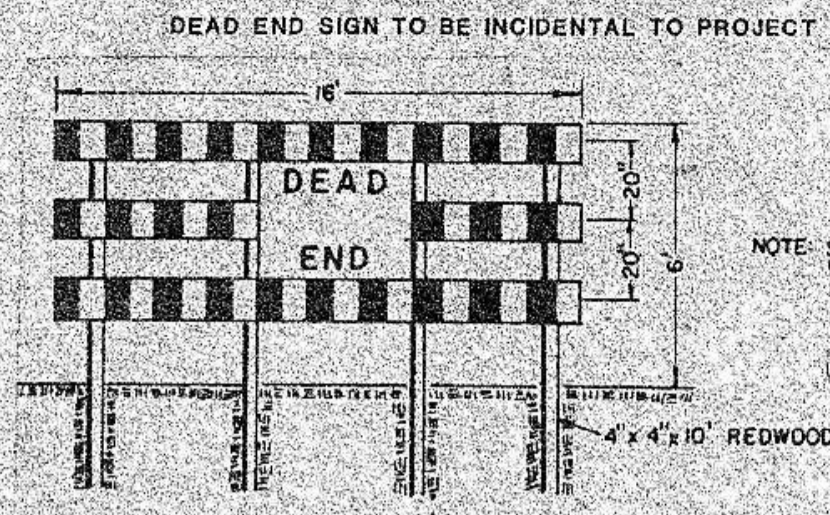

DATE: _____
 BY: _____
 CHECKED: _____
 APPROVED: _____
 TITLE: _____
 NOTE: ALL DIMENSIONS ARE IN FEET UNLESS OTHERWISE NOTED.
 ALL DIMENSIONS ARE TO CENTERLINE UNLESS OTHERWISE NOTED.

DATE: _____
 BY: _____
 CHECKED: _____
 APPROVED: _____
 TITLE: _____
 NOTE: ALL DIMENSIONS ARE IN FEET UNLESS OTHERWISE NOTED.
 ALL DIMENSIONS ARE TO CENTERLINE UNLESS OTHERWISE NOTED.

