

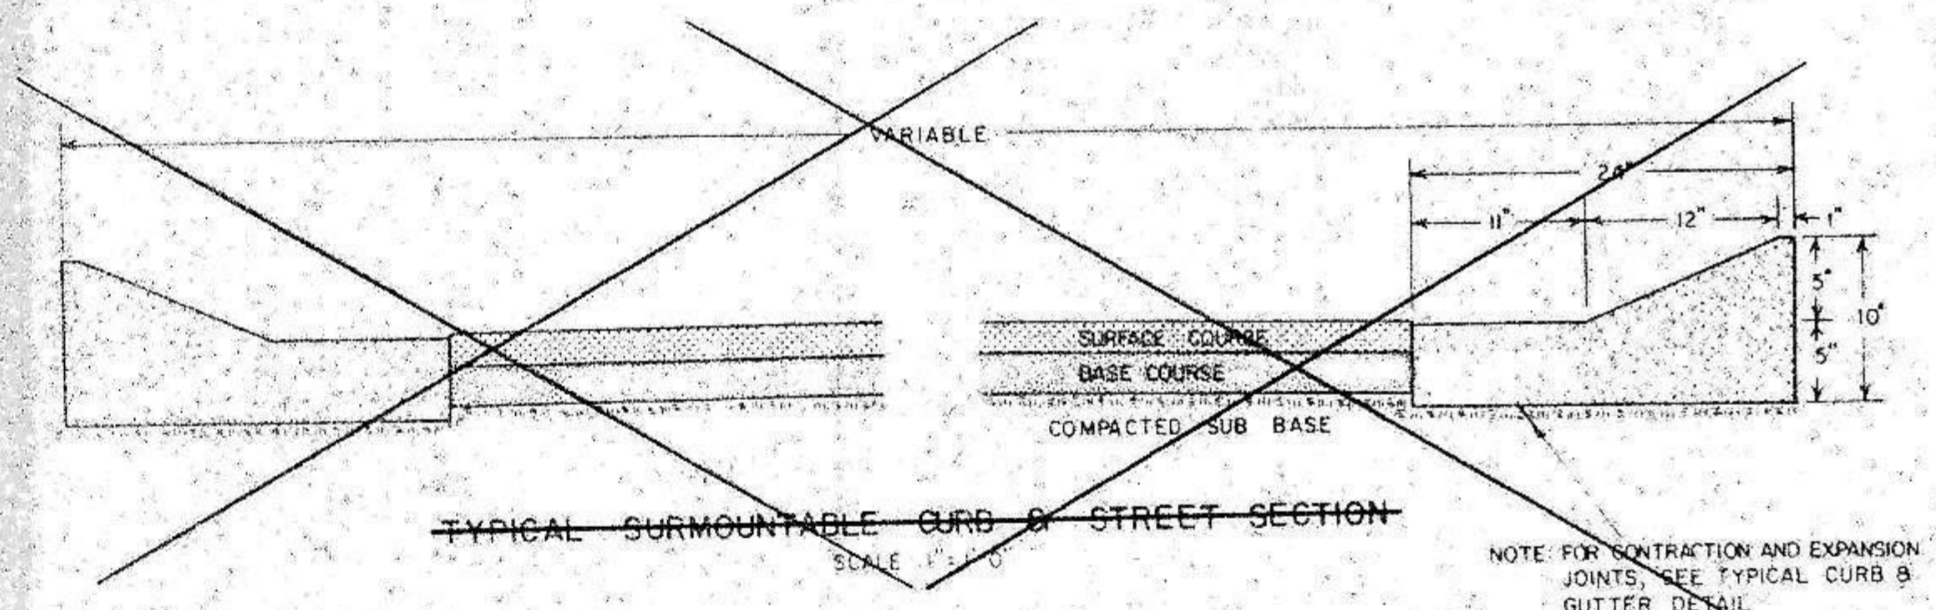
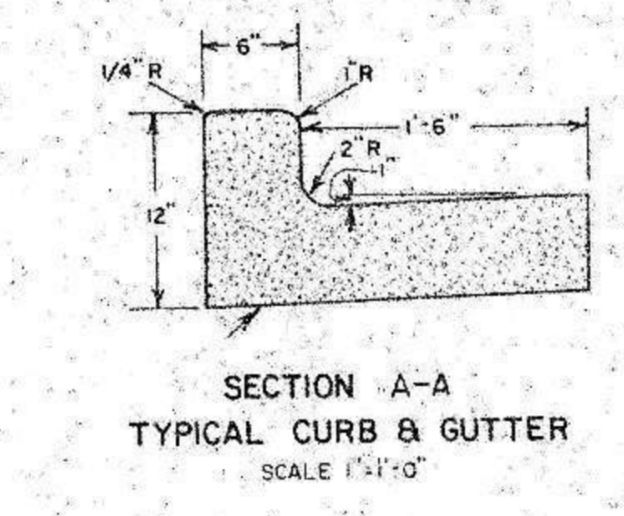
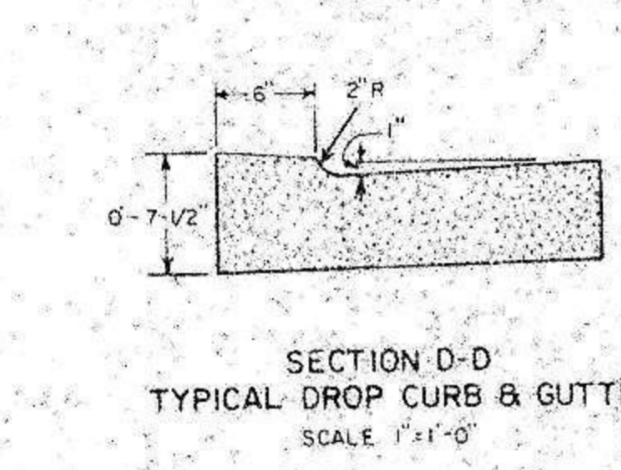
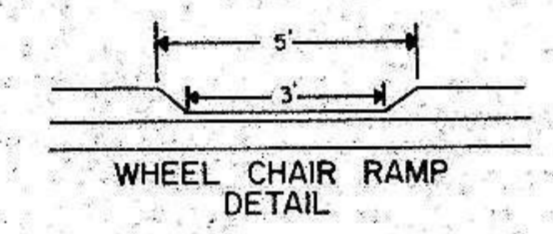
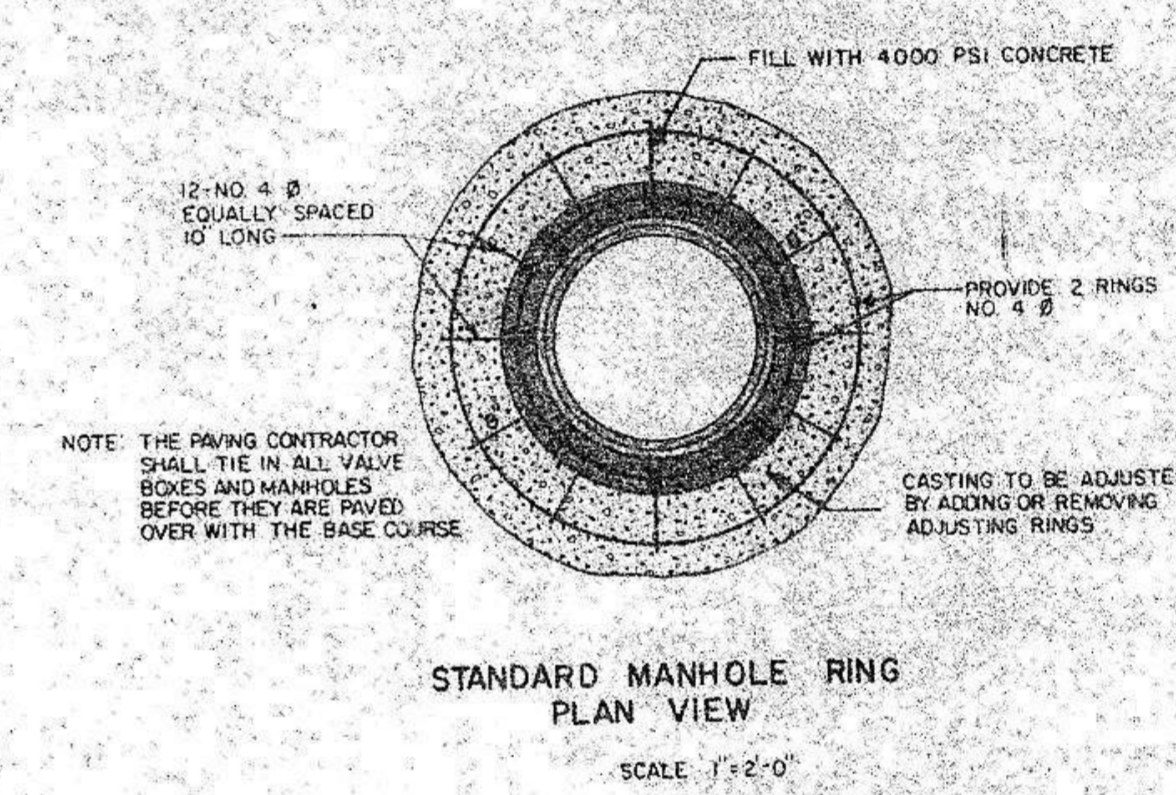
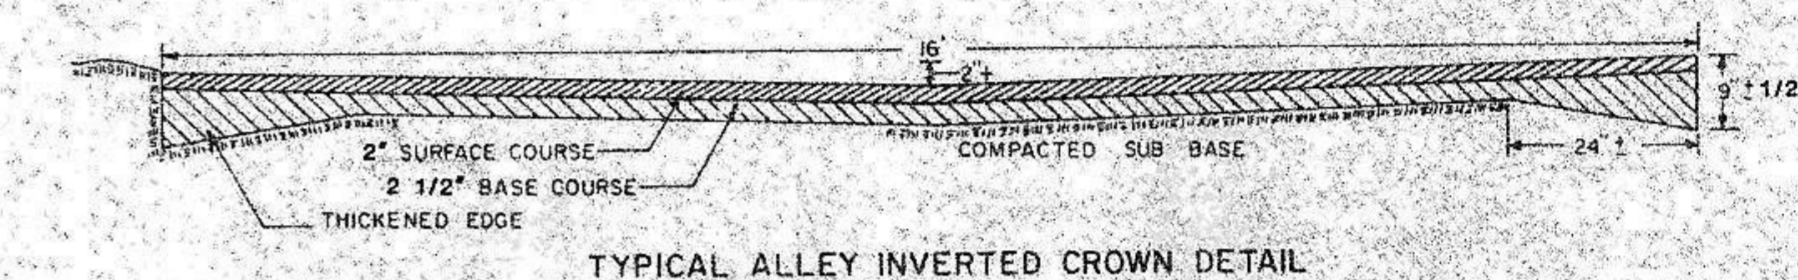
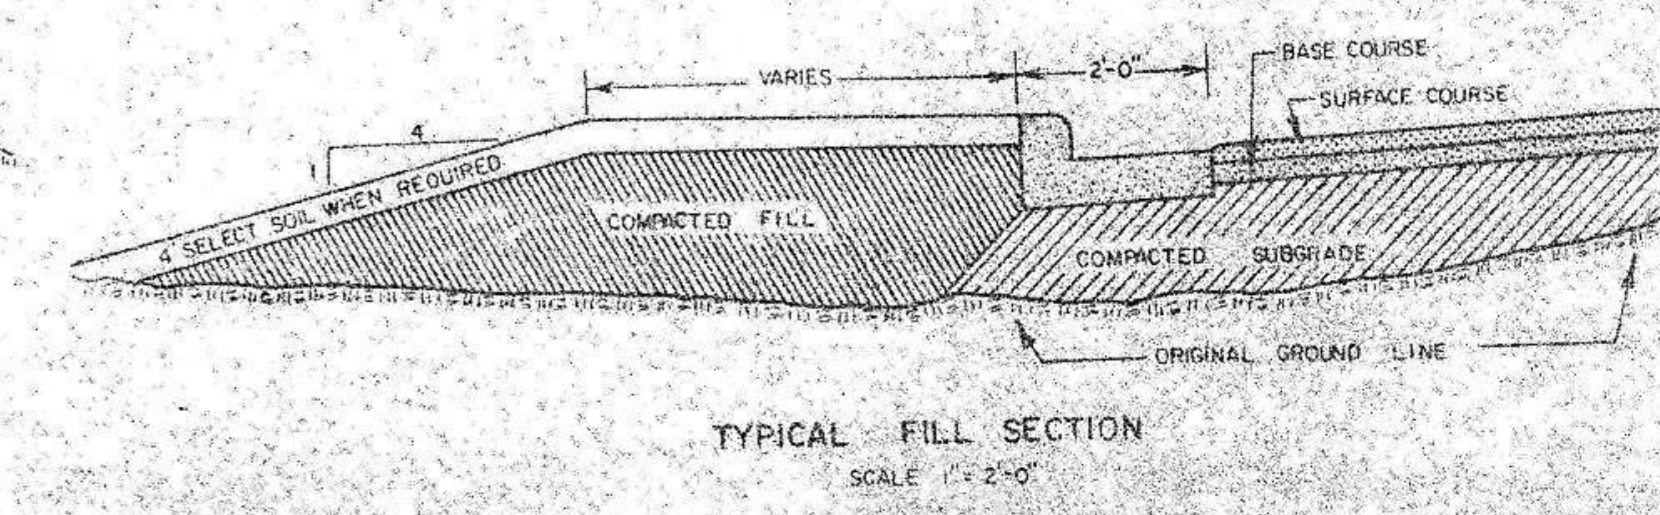
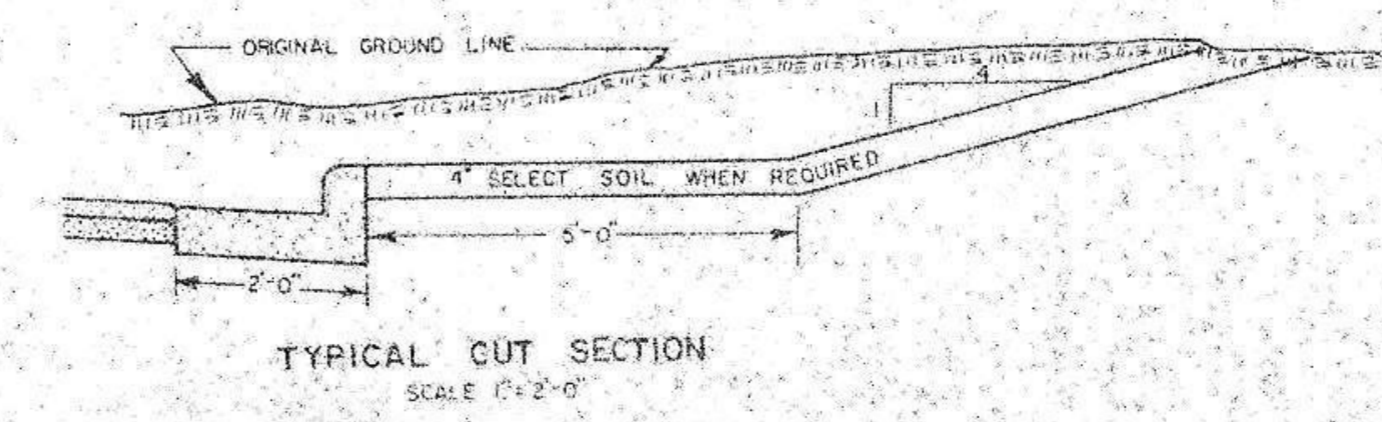
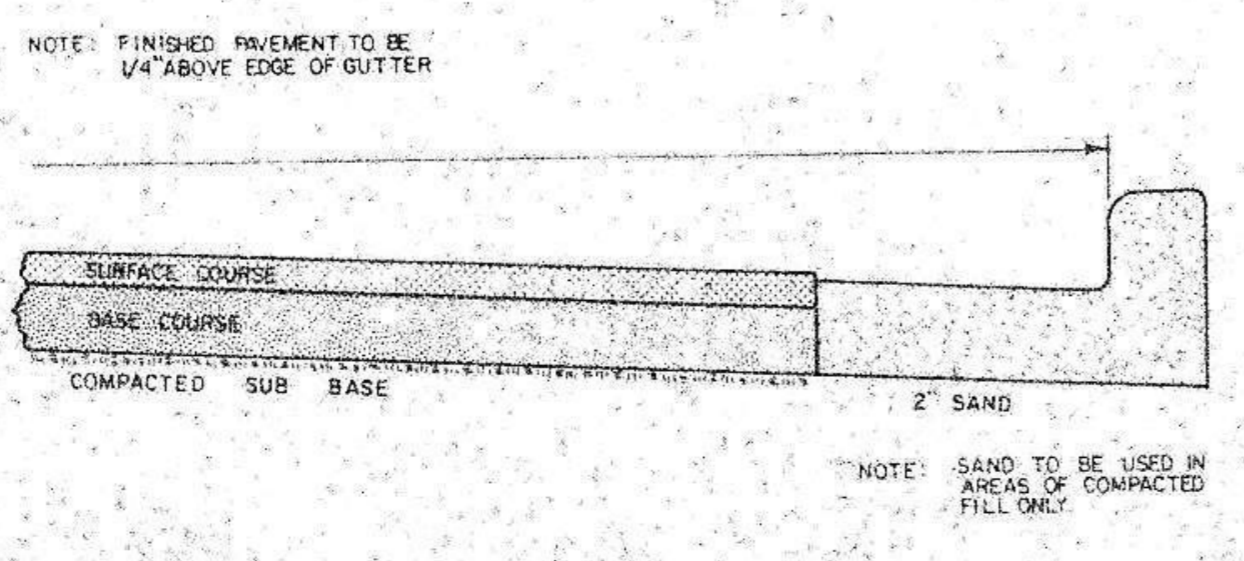
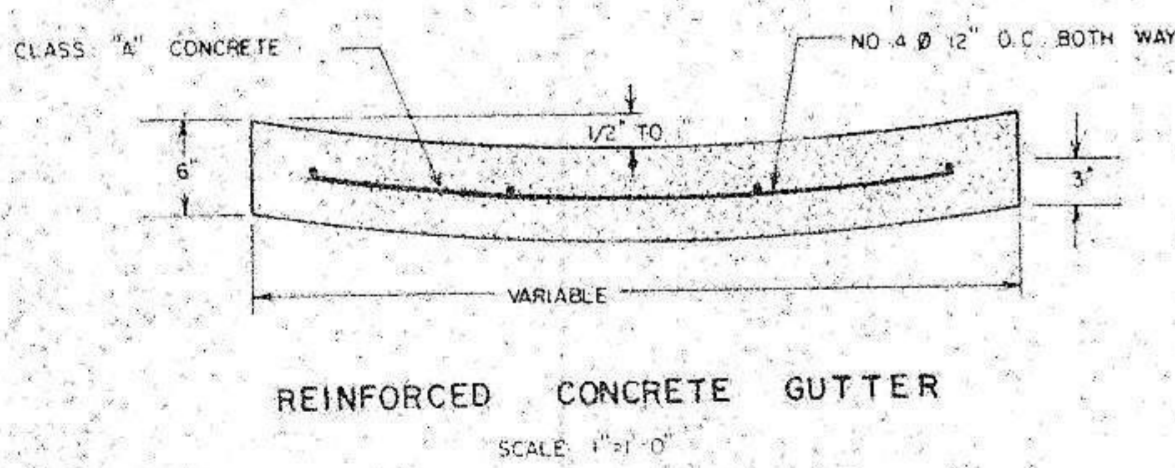
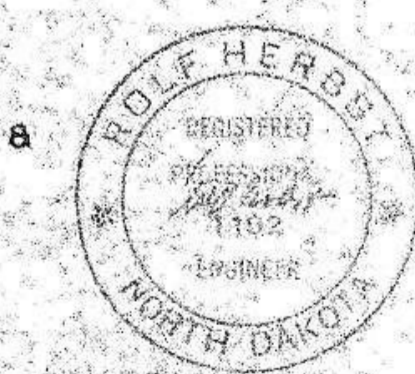
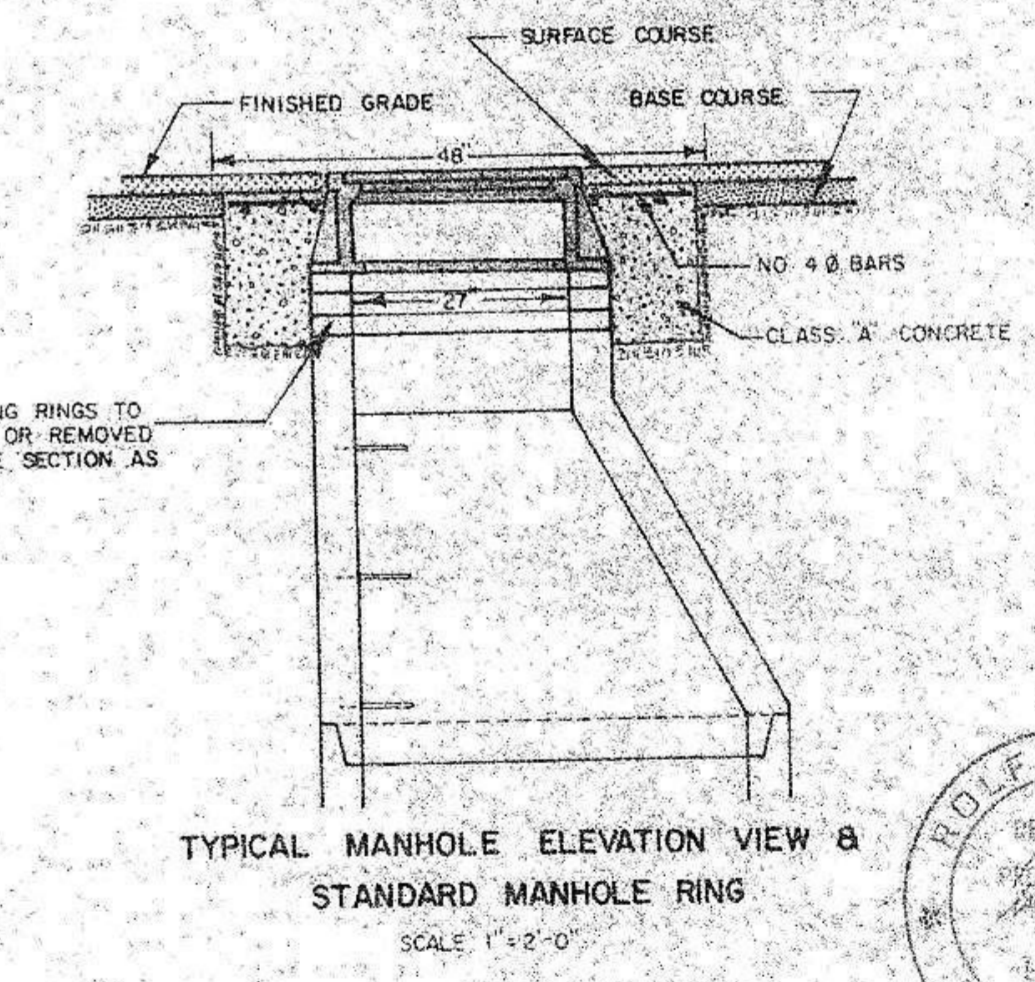


MACHINE CURB & GUTTER WILL BE ALLOWED PROVIDED TEMPLATE IS APPROVED BY ENGINEER.

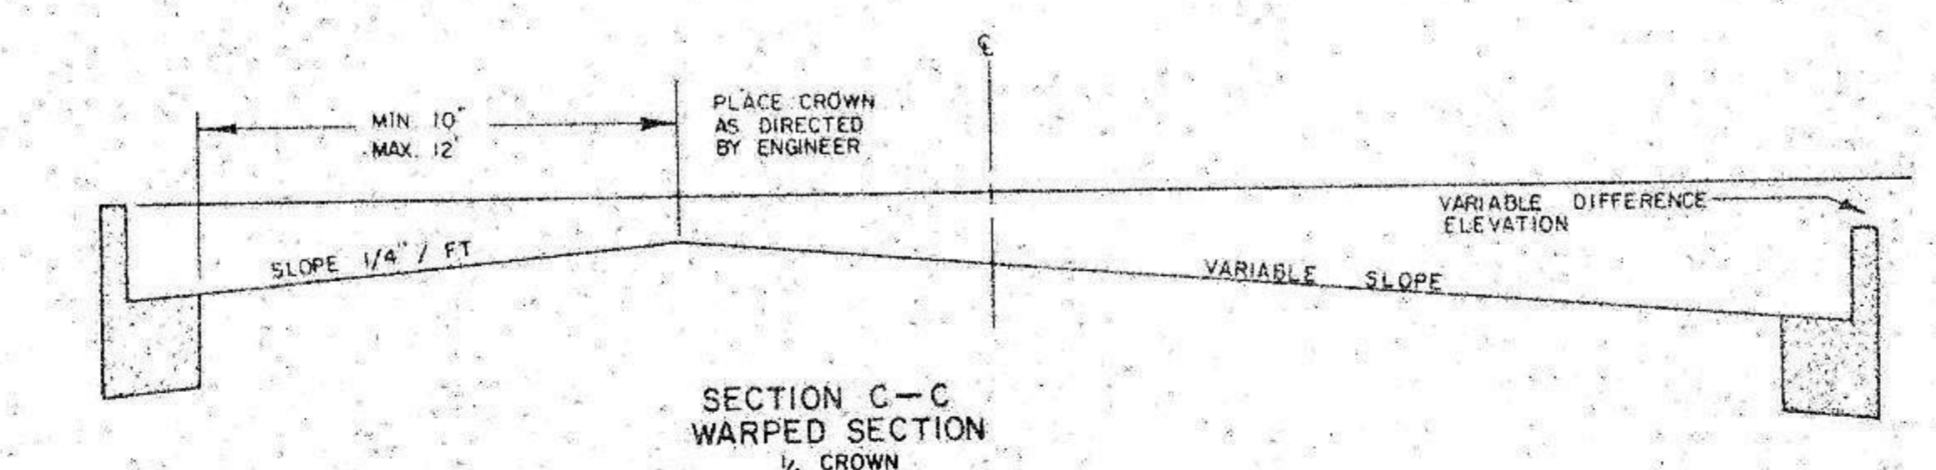

NOTE: TEMPLATE FOR CONCRETE GUTTER SECTION MAY VARY AS DIRECTED BY THE ENGINEER. PROVIDE TEMPLATE TO CONSTRUCT CONTRACTION JOINT 1/8" WIDE AND 3" DEEP AS SHOWN ON CURB AND GUTTER DETAILS.

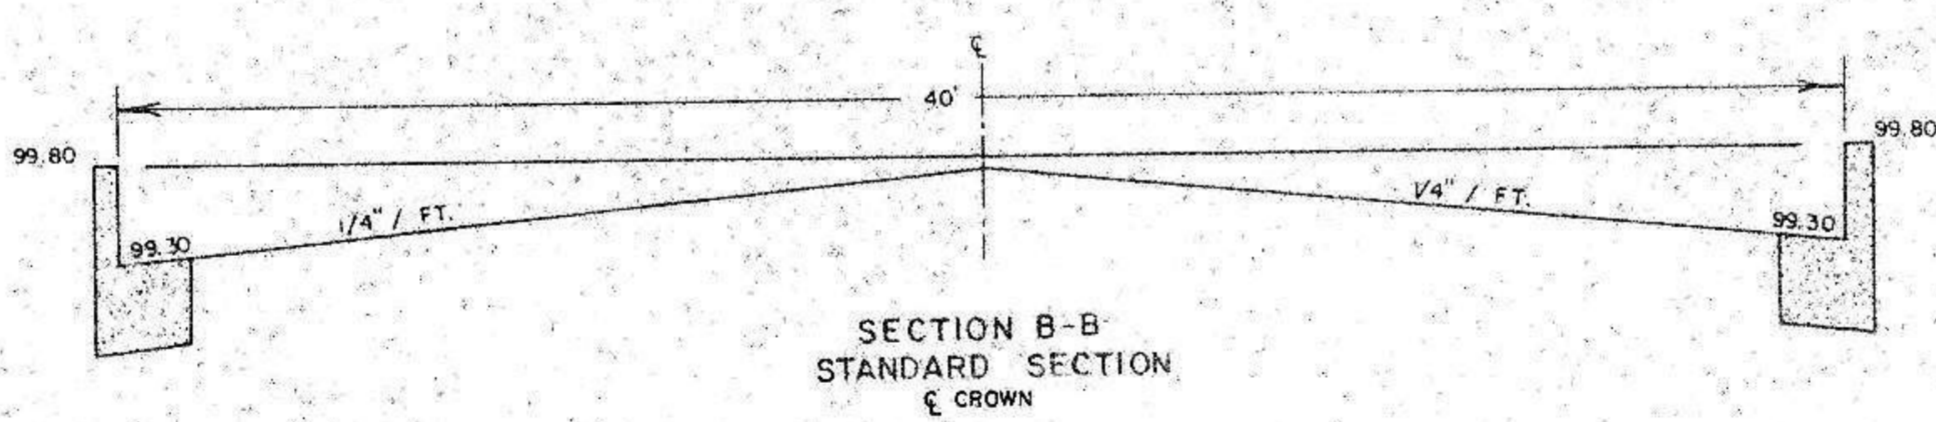

TOMAN ENGINEERING COMPANY  
CIVIL & ENVIRONMENTAL CONSULTANTS  
P.O. BOX 708  
MANDAN, NORTH DAKOTA 58554

DATE	FEBRUARY 1980
CHECKED BY	
DESIGNED BY	
APPROVED BY	
CROWN	
REVISIONS	
TITLE	PAVING DETAILS
SHEET NUMBER	
OF SHEETS	