




HIGHLAND ROAD  
AREA A  
SID 85

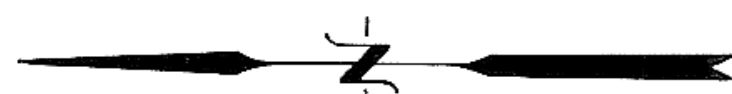

HOR. SCALE 1"=100'  
VERT. SCALE 1"=10'

LEGEND

- UTILITY BOX
- SPRINKLER HEAD
- ▲ GAS LINE
- △ PETROLEUM LINE
- CURB STOP
- GATE VALVE
- ⊕ FIRE HYDRANT
- R/W MARKER
- CULVERT
- CABLE TV LINE
- MDU GAS LINE
- TRAFFIC SIGN
- ▨ GRAVEL
- ▩ CONCRETE
- ▧ EXISTING ASPHALT

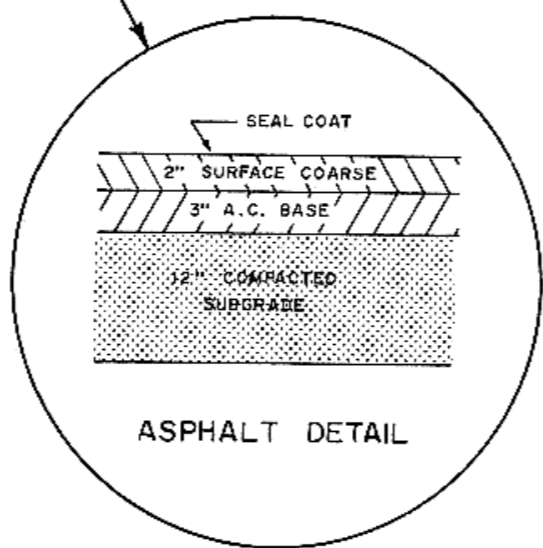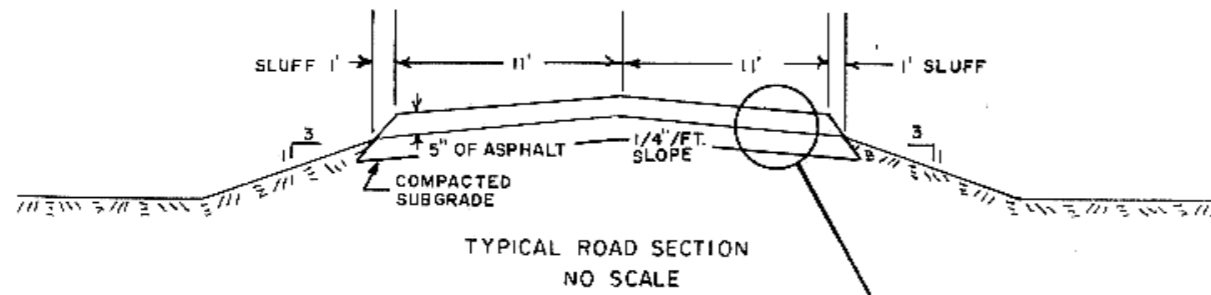

- CONSTRUCTION NOTES
1. TRAFFIC ON HIGHLAND ROAD SHALL BE MAINTAINED AT ALL TIMES.
  2. SIGNING FOR DETOURS & CONSTRUCTION SHALL BE INCIDENTAL TO THE PROJECT.
  3. MAILBOXES TO BE REMOVED AND REPLACED BY OWNERS.
  4. GRAVEL ALL APPROACHES 10' FROM ASPHALT.

