


MANDAN INDUSTRIAL PARK

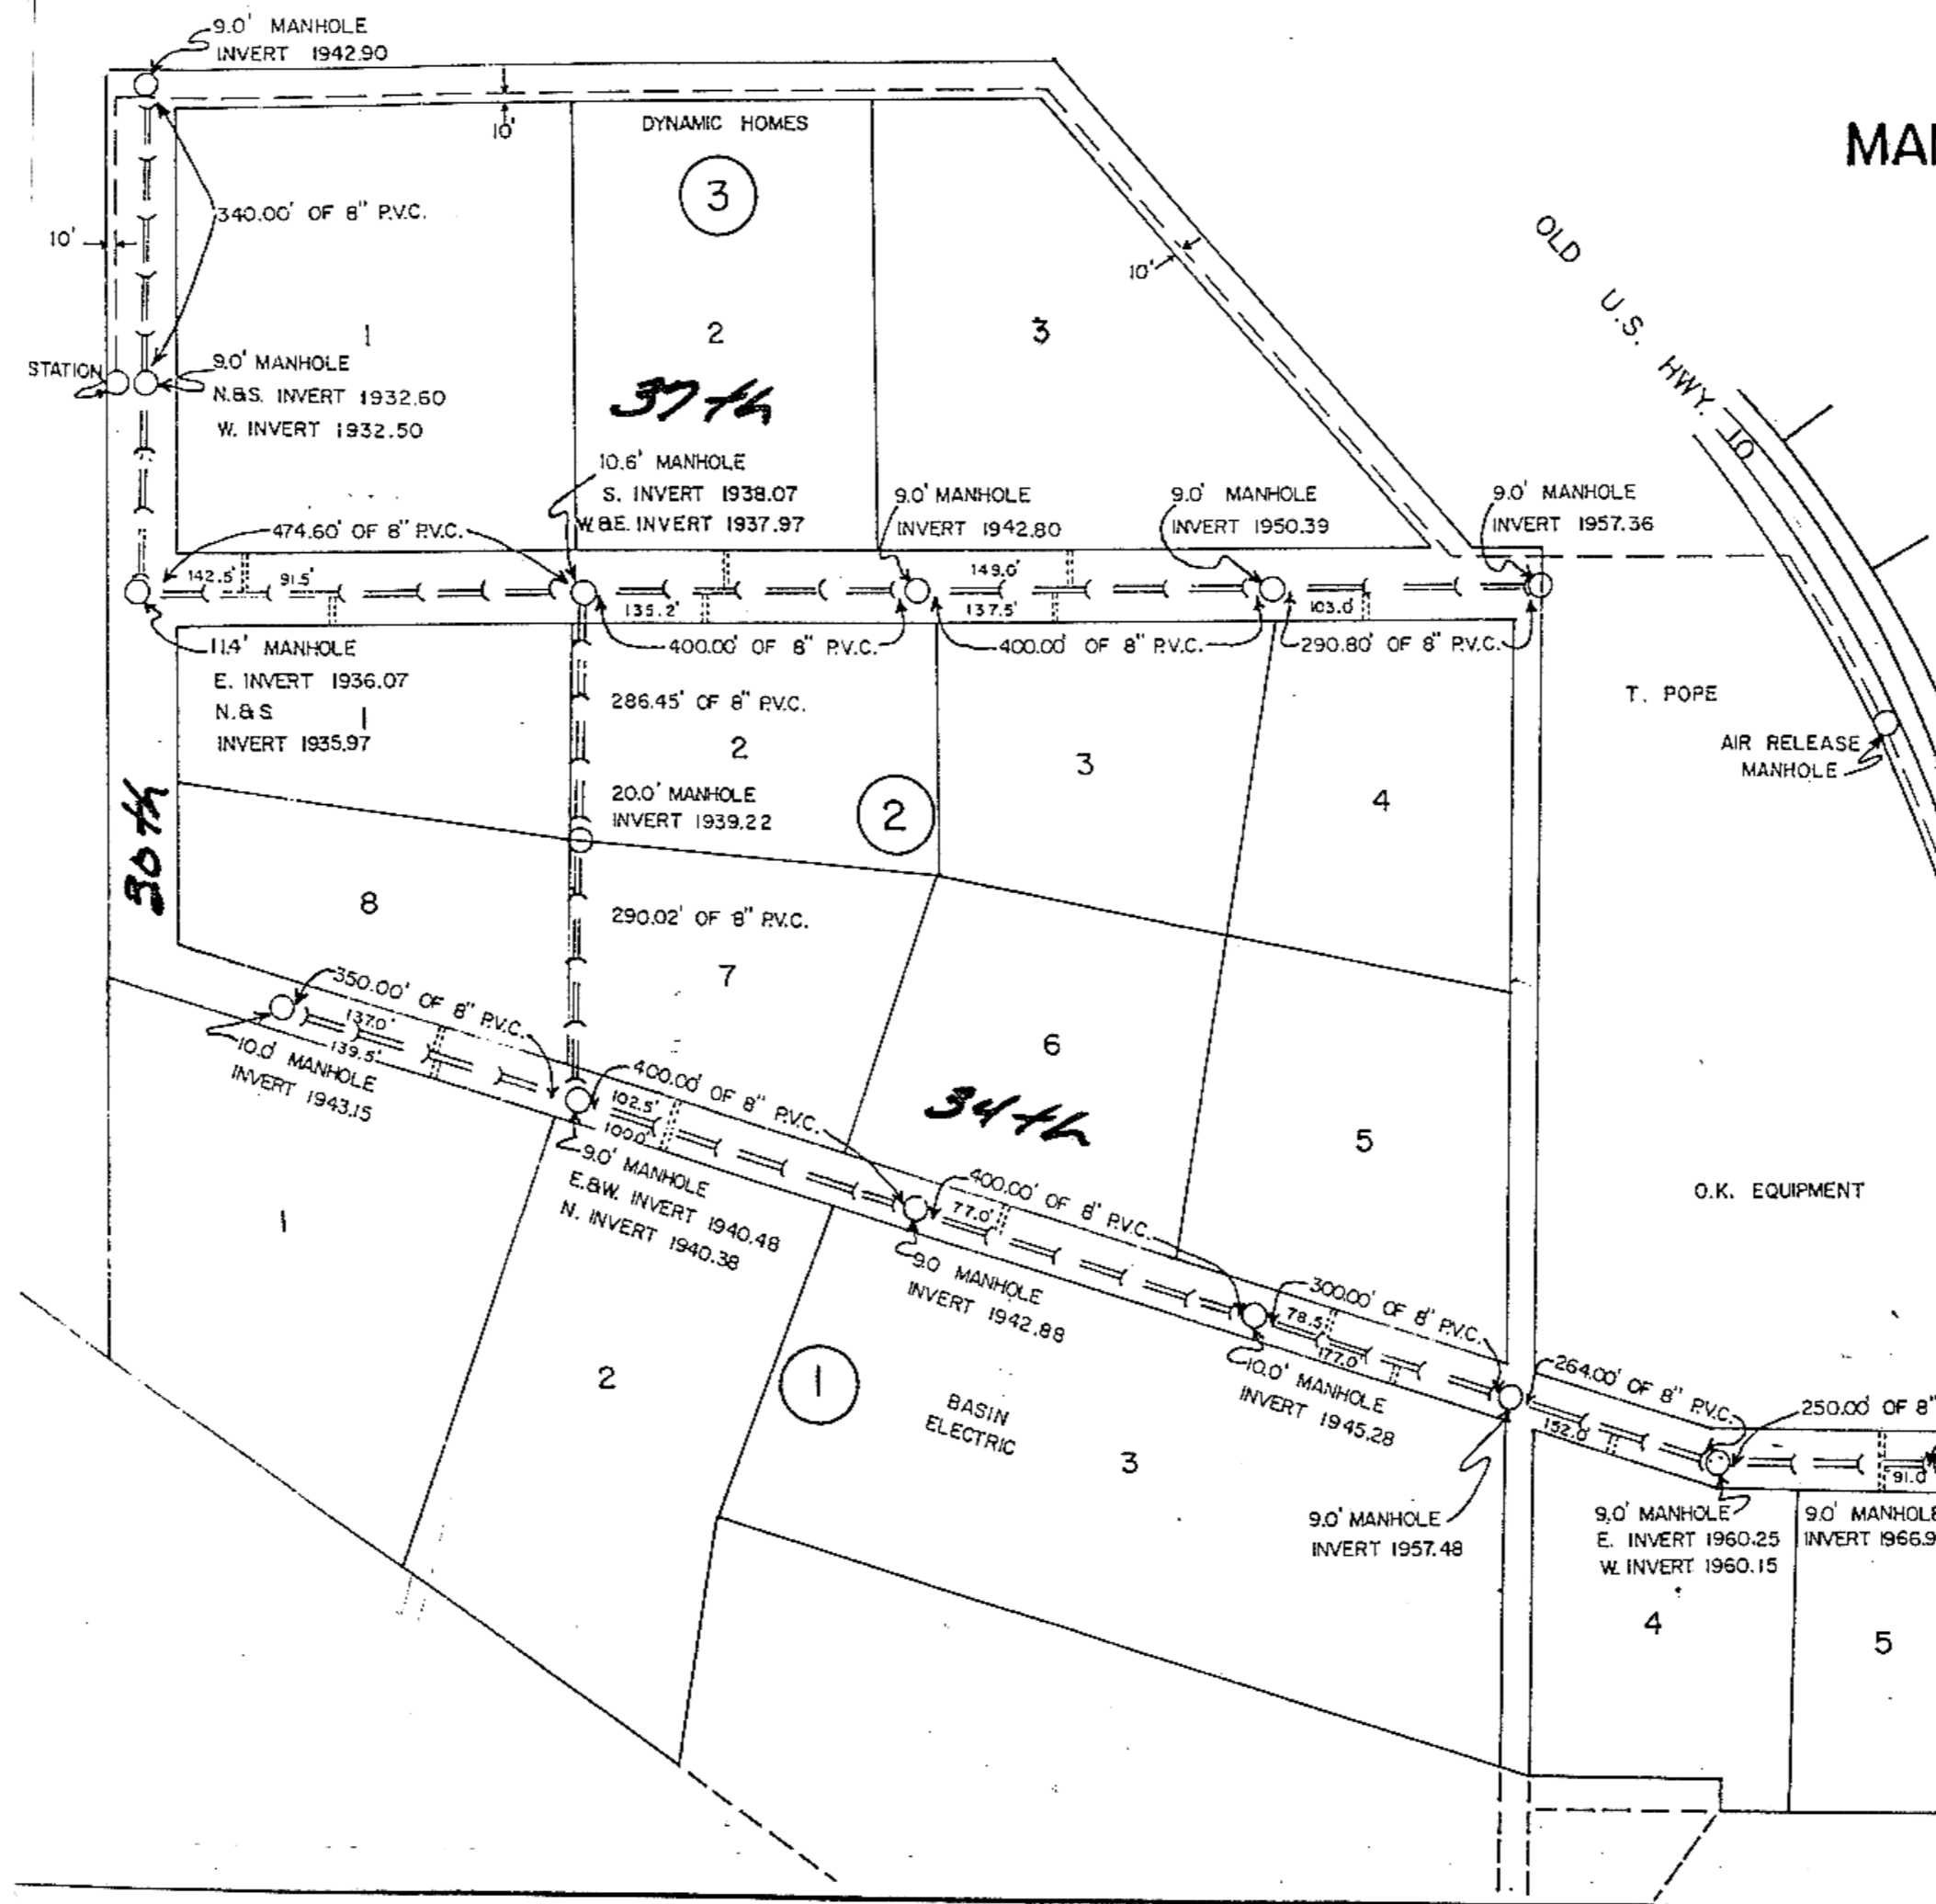

LIFT STATION INFORMATION

- TYPE — SUBMERSIBLE PUMP
- MODEL — PEABODY BARNES SEH752
- H.P. EACH — 7 1/2
- VOLTS — 230
- CYCLE — 60
- PHASE — 3
- SERIAL NO. —
- R.P.M. — 1750
- G.P.M. — 170

LEGEND

- == — 8" P.V.C. SEWER MAIN
- ==○== — MANHOLE
- N. — NORTH
- S. — SOUTH
- — 5" P.V.C. FORCE MAIN
- — SEWER SERVICE

SEE PAGE 84

CONSOLIDATED WATER & SEWER IMP. DIST. NO. 16		
8" SEWER MAINS	SCALE 1" = 200'	DRAWN BY TAS
6" SEWER SERVICES		REVISED
CONTRACTOR — SORNSIN CONST. CO.		
DATE DEC. 1975	APPROVED BY	DRAWING NUMBER