


Lift Station Detail
No Scale



Railroad Crossing Detail
Scale 1"=10'

PROJECT AREA NO. 2

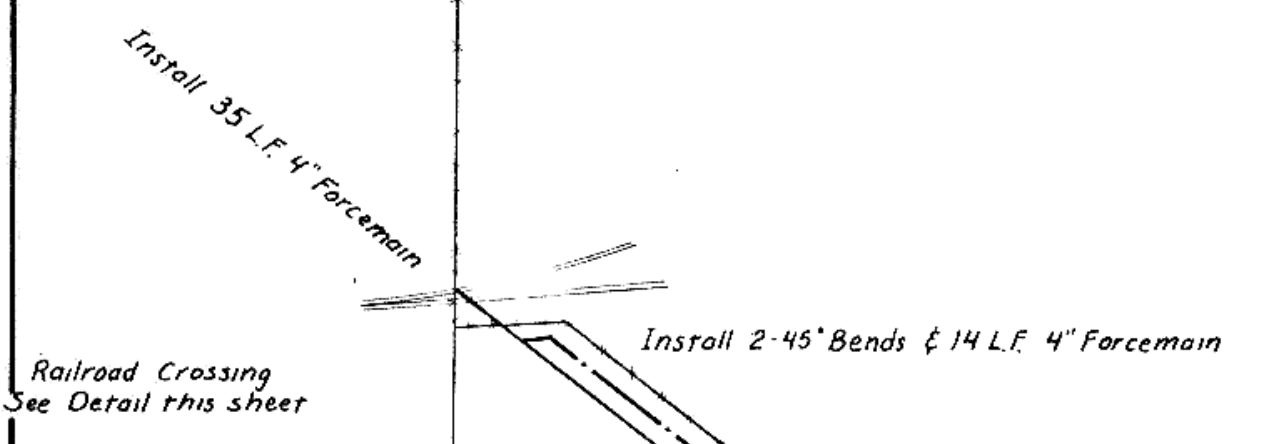