


TWIN CITY INDUSTRIAL SITES

82

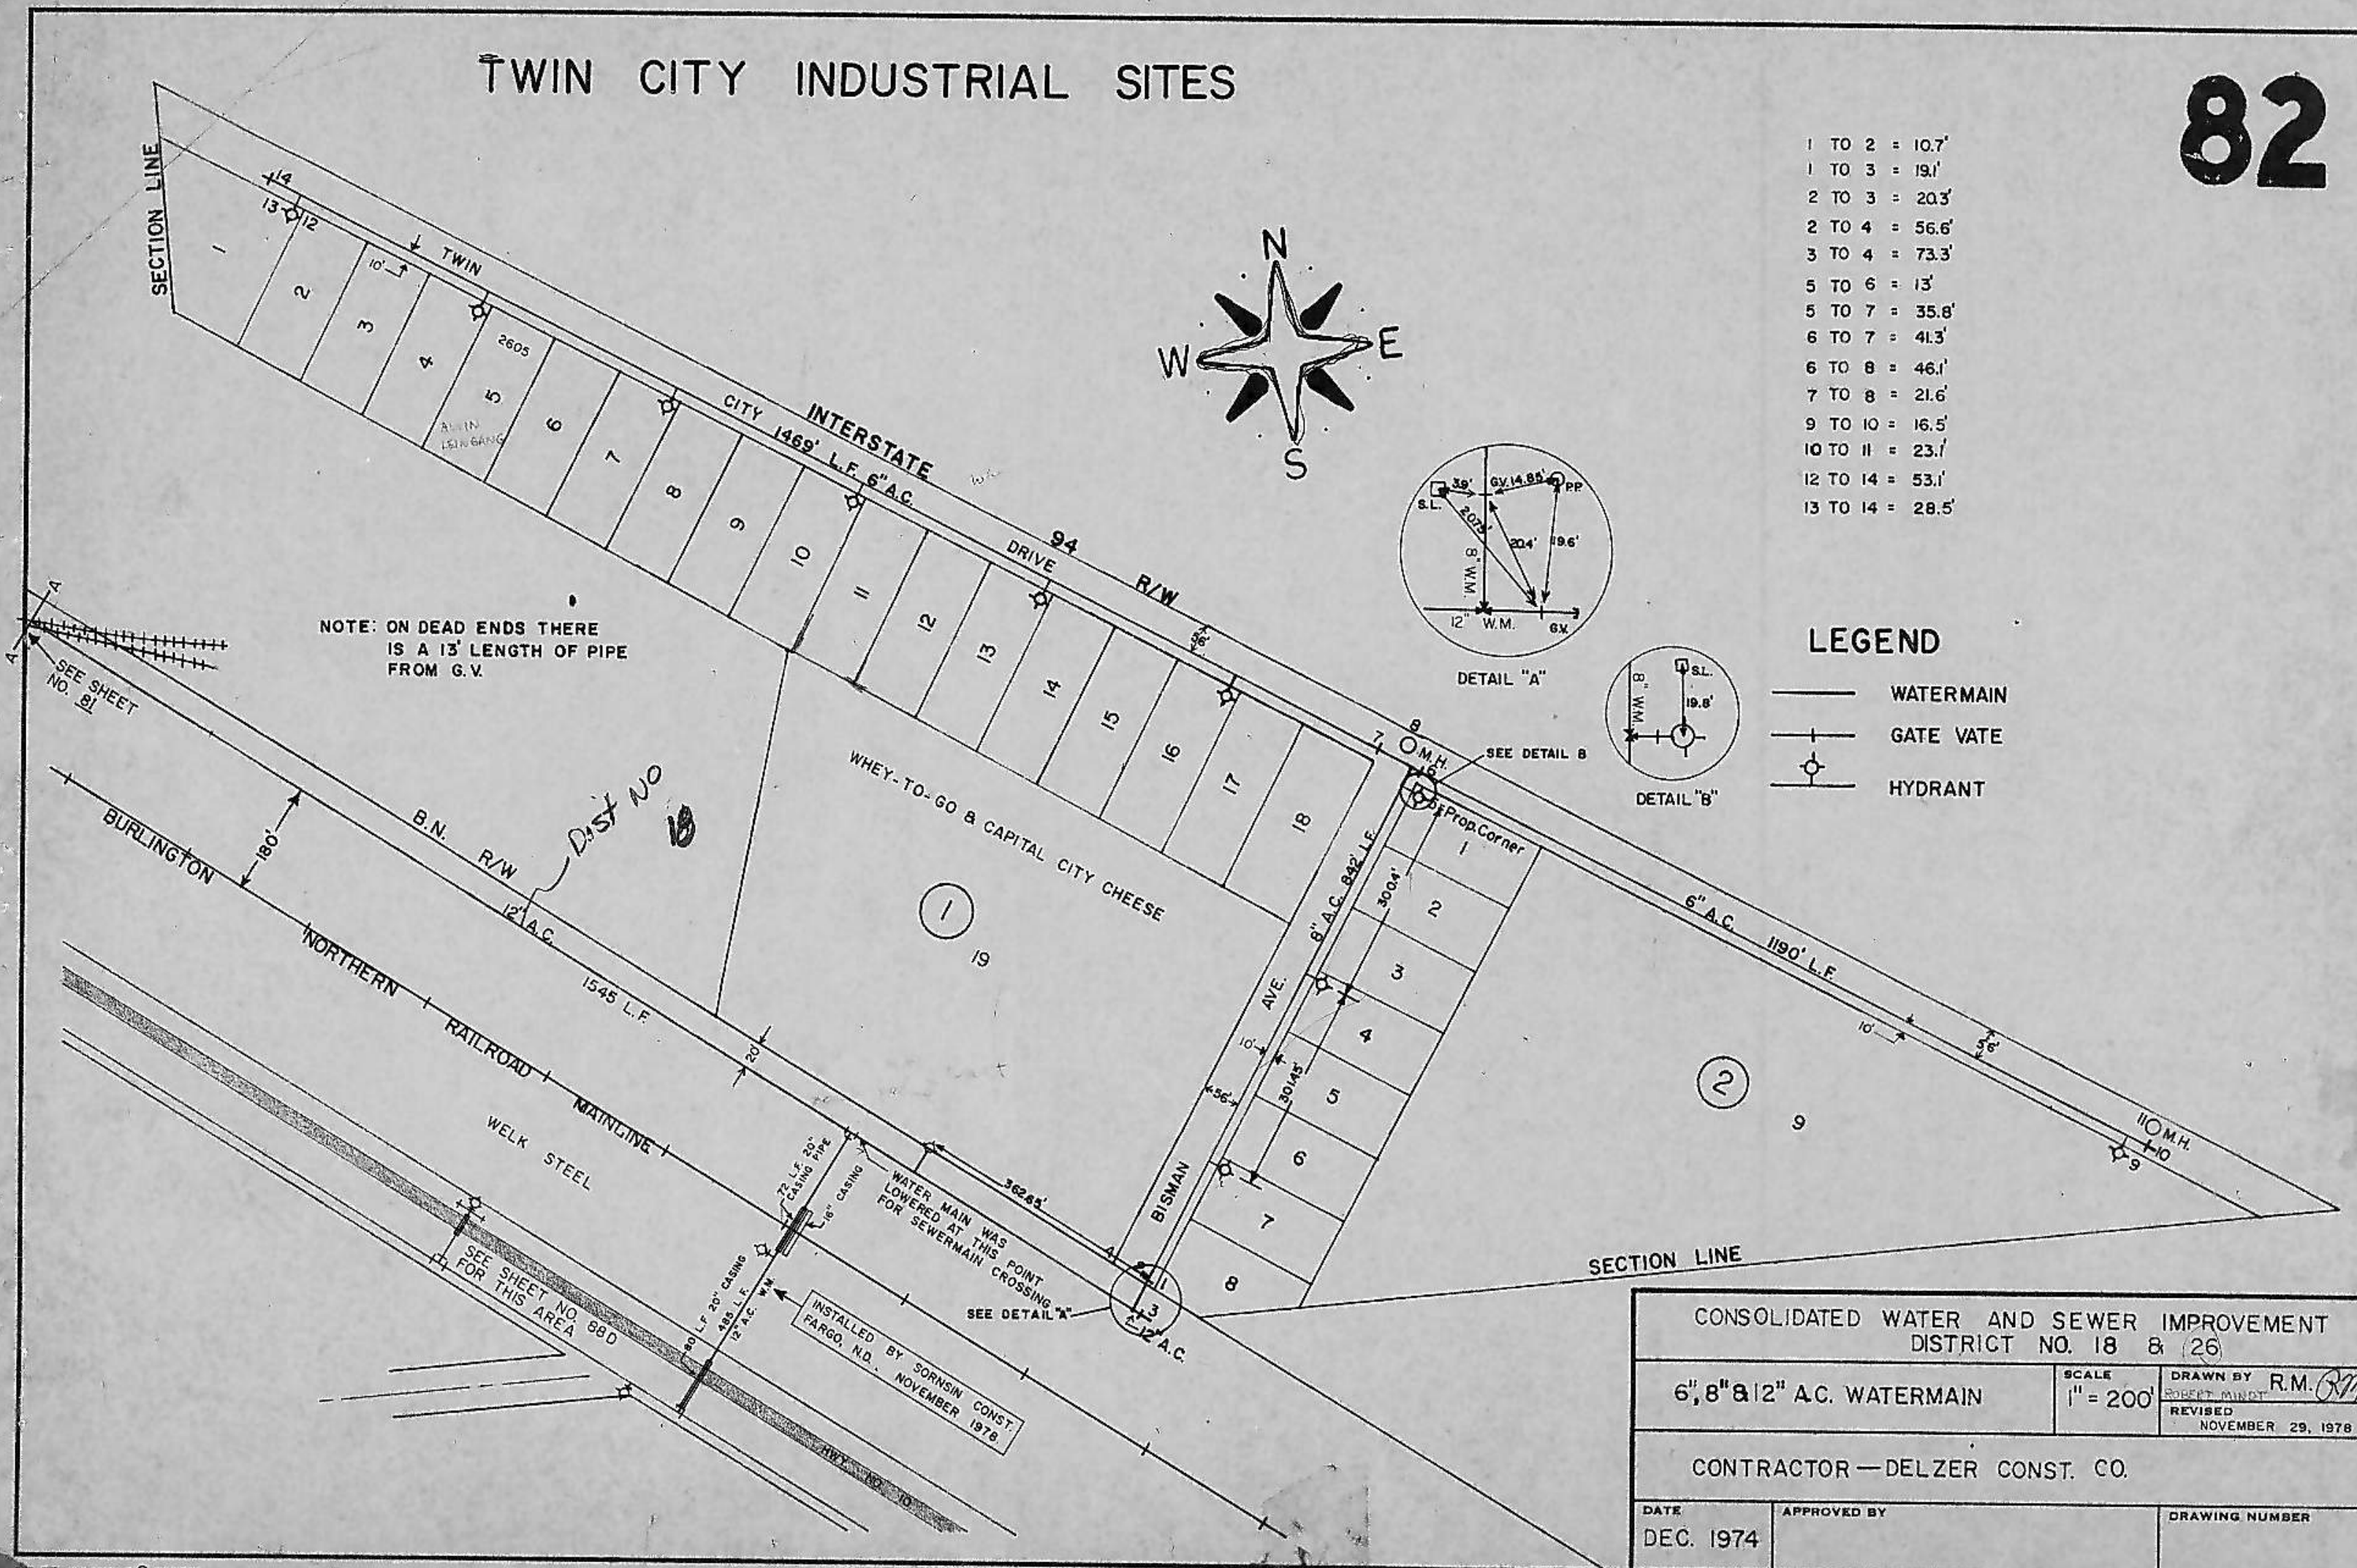

CONSOLIDATED WATER AND SEWER IMPROVEMENT DISTRICT NO. 18 & 26		
6", 8" & 12" A.C. WATERMAIN	SCALE 1" = 200'	DRAWN BY R.M. <i>R.M.</i> REVISED NOVEMBER 29, 1978
CONTRACTOR—DELZER CONST. CO.		
DATE DEC. 1974	APPROVED BY	DRAWING NUMBER