


CLARK STREET
RIPPEL'S 2ND SUBDIVISION

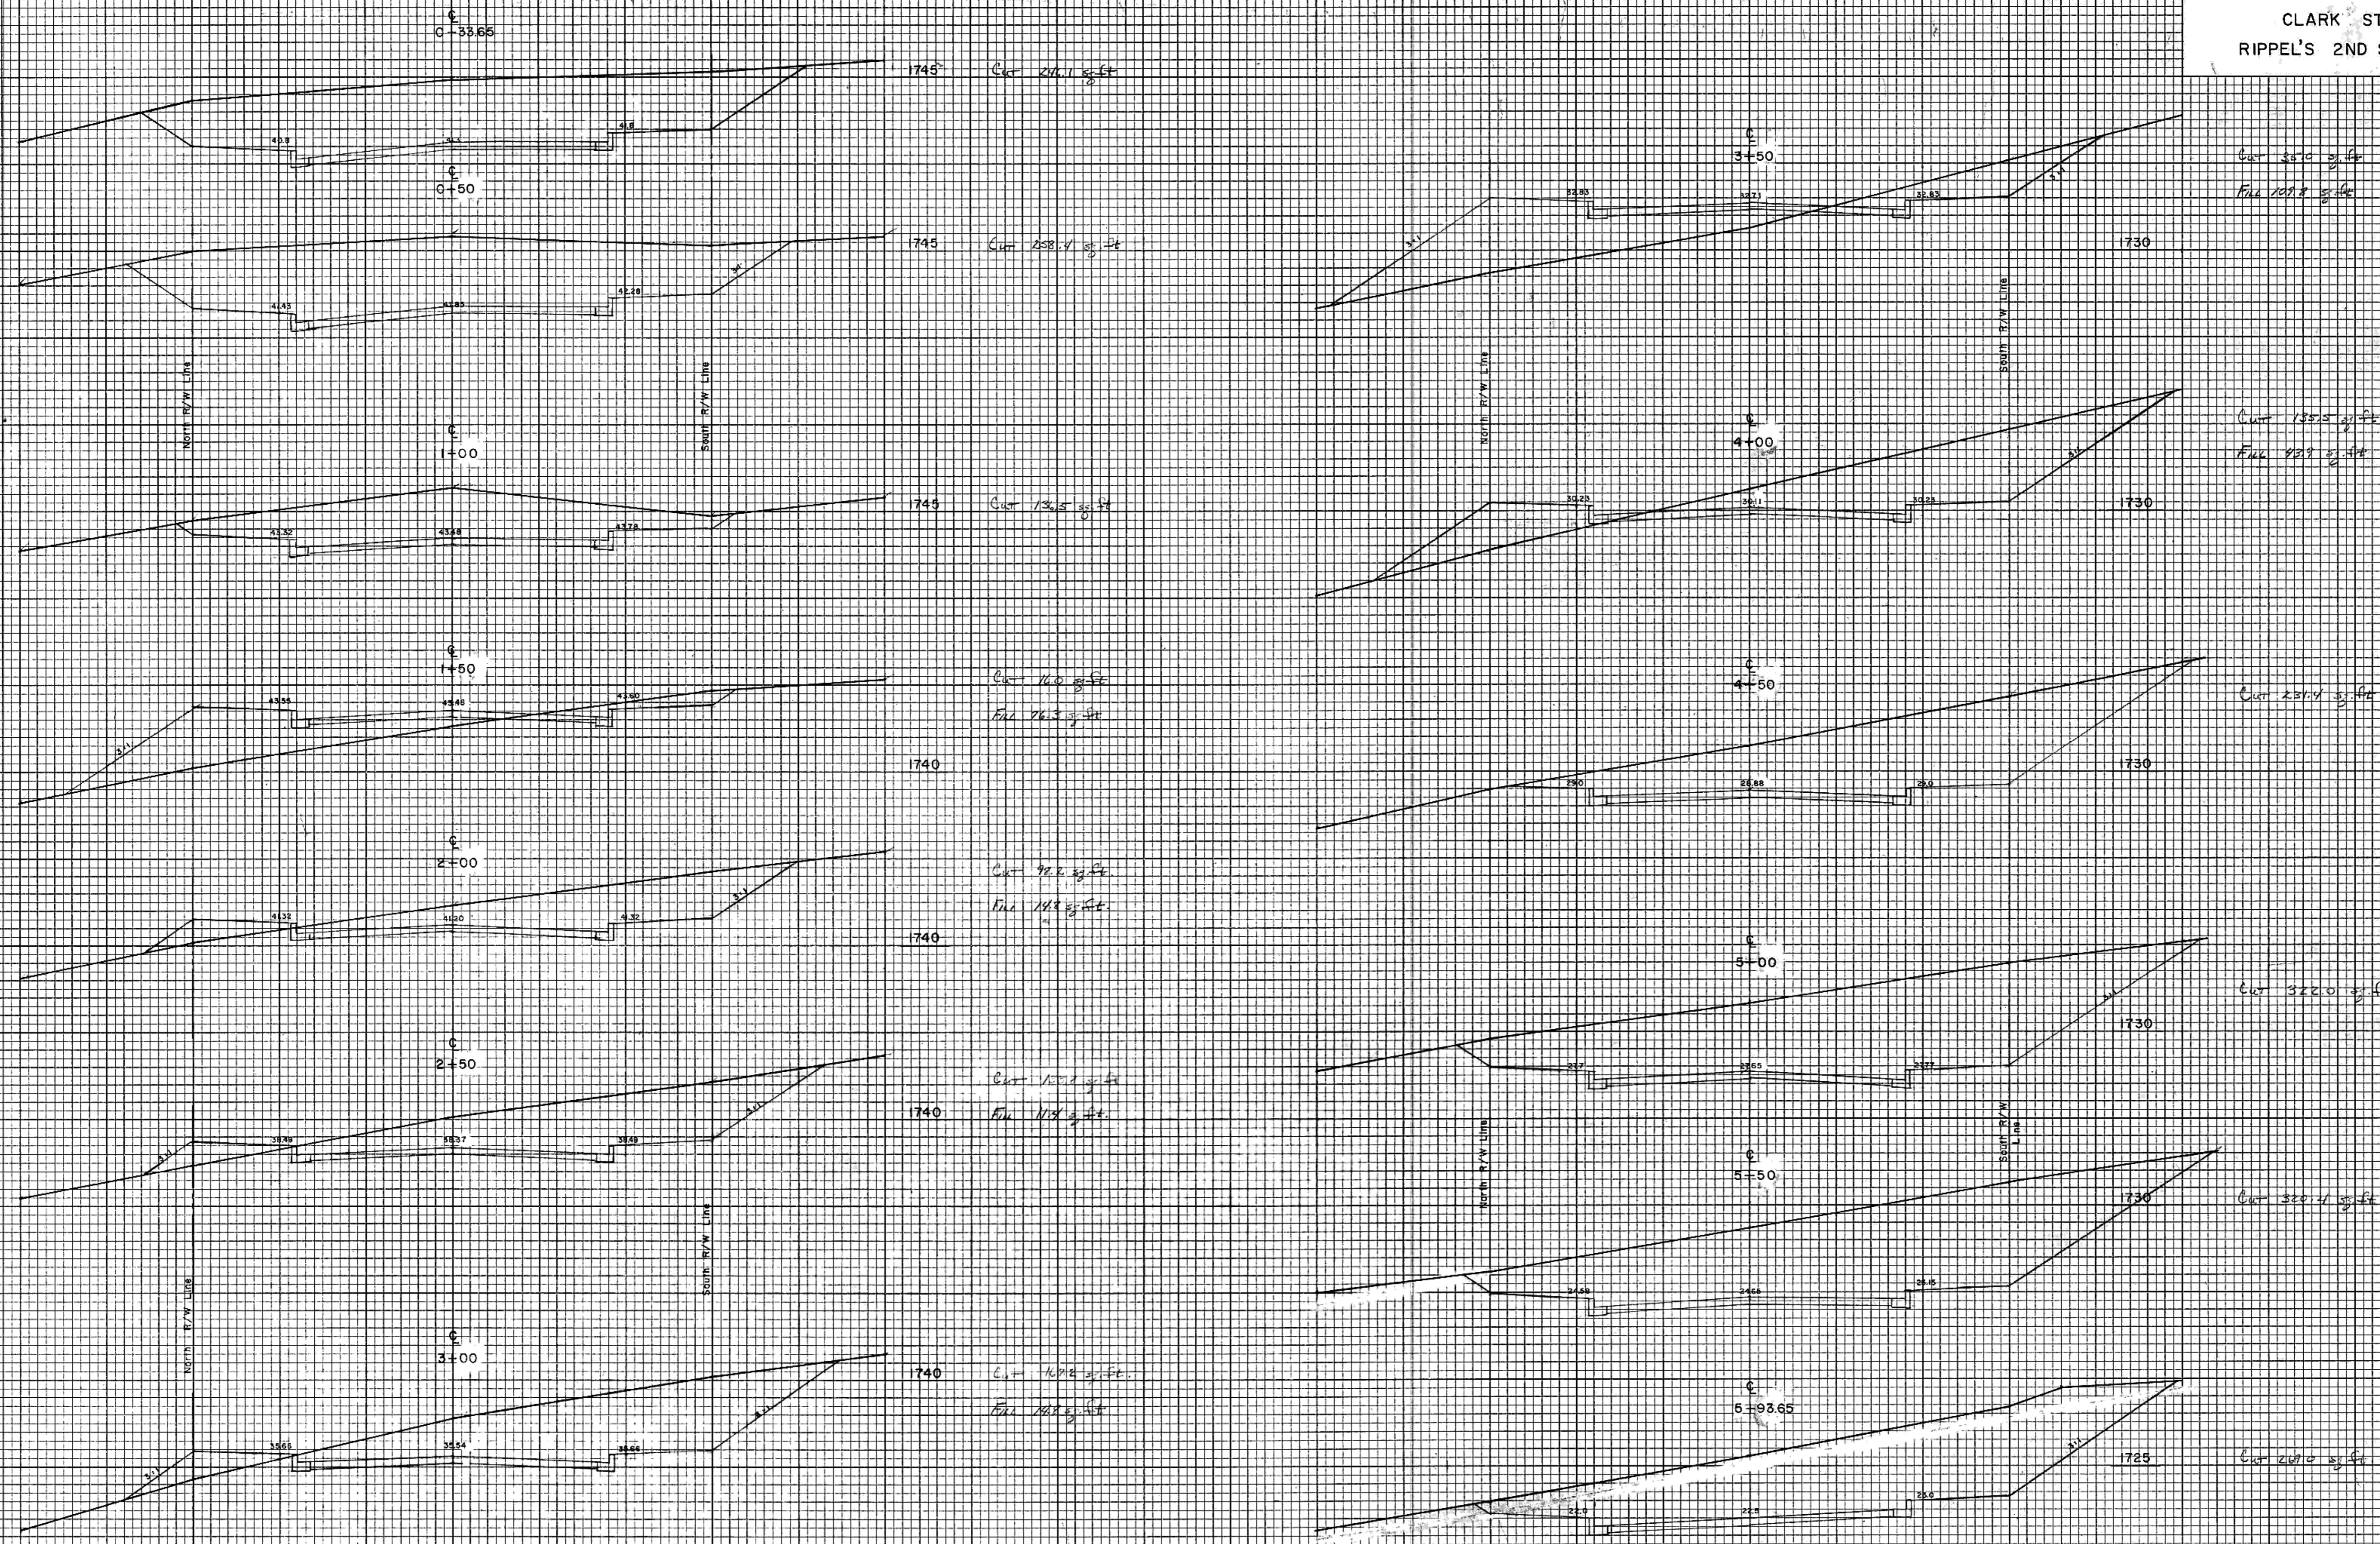

SCALE:
HORIZ. 1" = 10'
VERT. 1" = 5'

JHK