
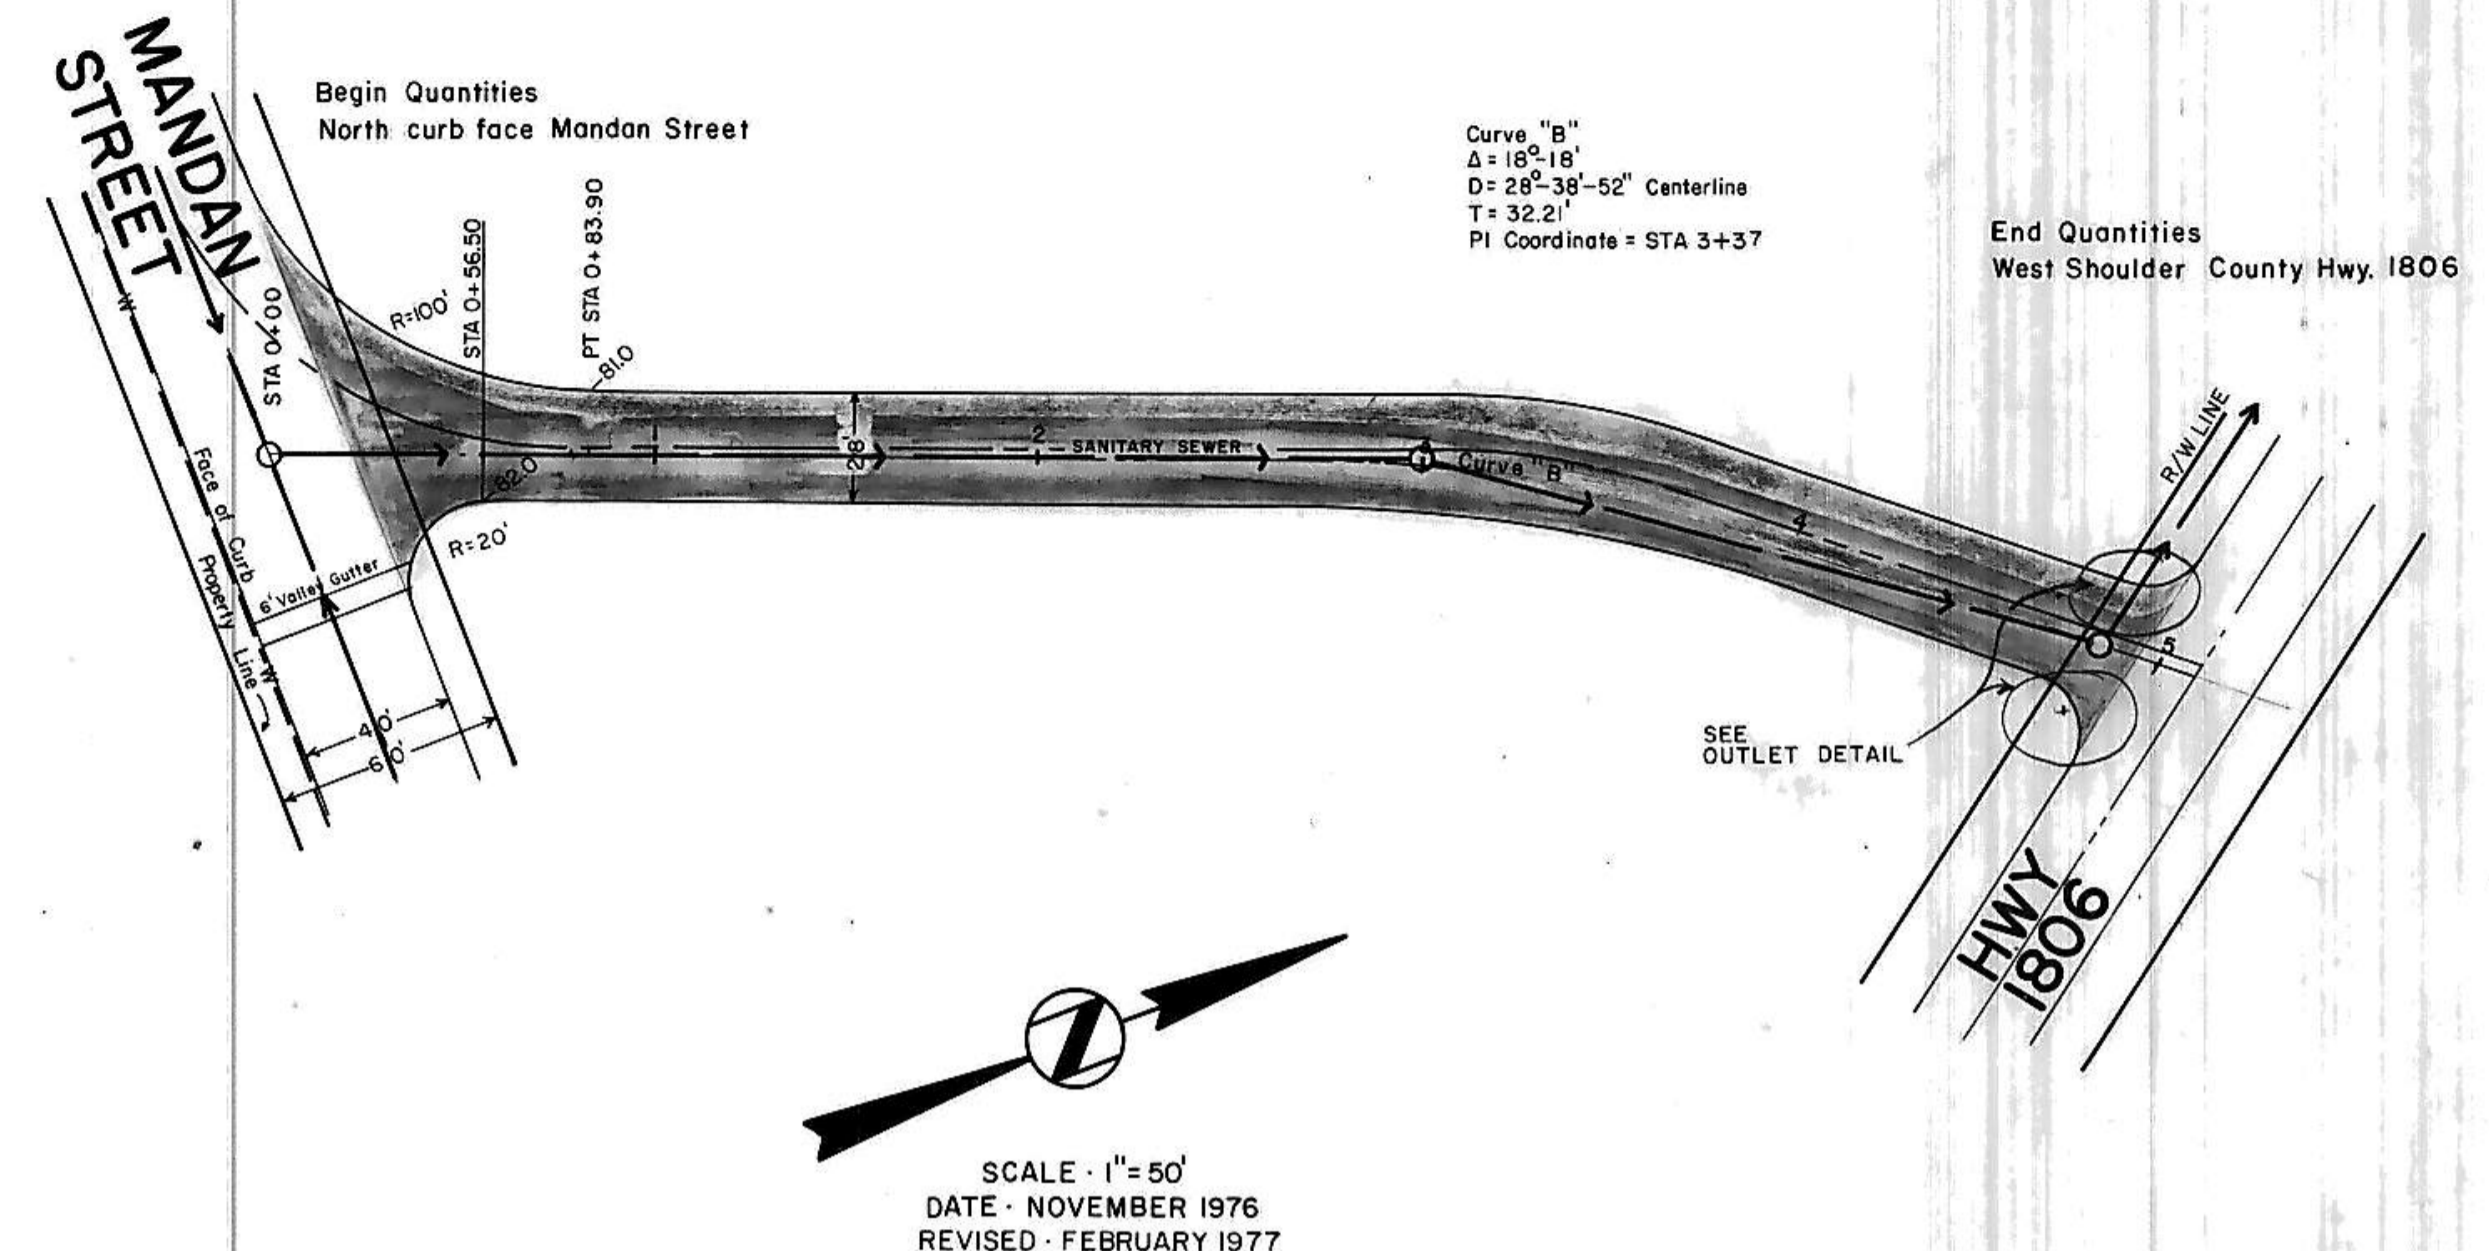


DATE: _____ BY: _____
 SURVEYED: _____
 PLAN NOTE BOOK GRADE CHECKED: _____
 RT. OF WAY CHECKED: _____
 No. _____

DATE: _____ BY: _____
 SURVEYED: _____
 PROFILE NOTE BOOK GRADE CHECKED: _____
 B. M. NOTED: _____
 STRUCTURE NOTATIONS CHECKED: _____
 No. _____

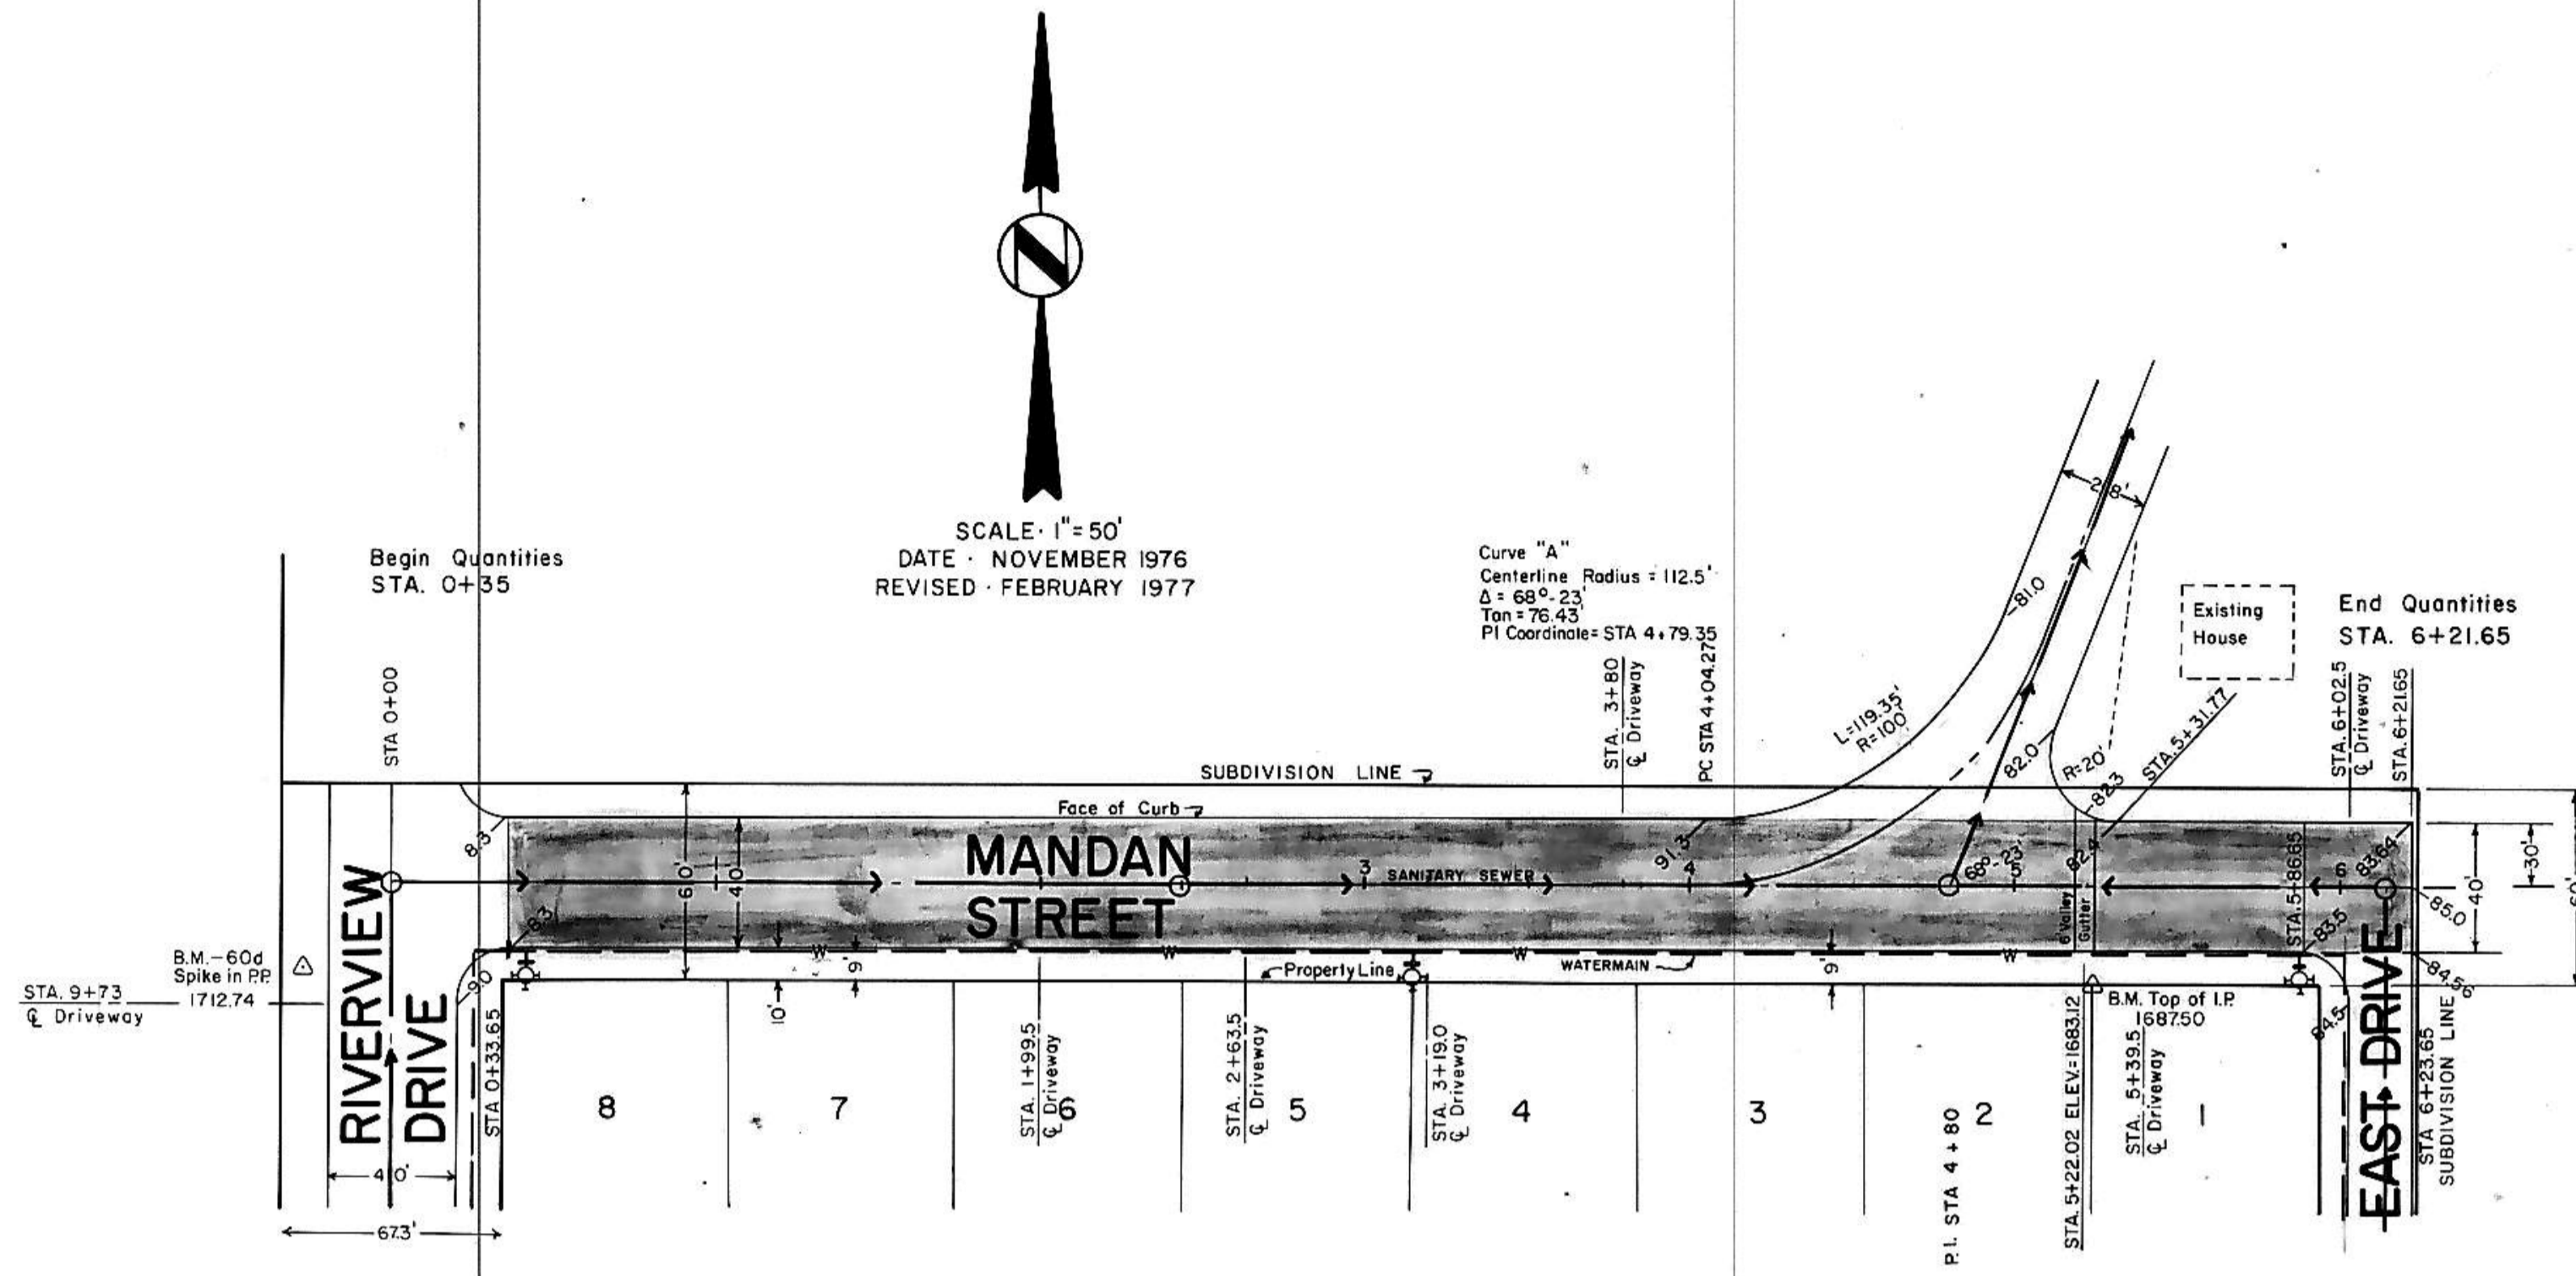

NOTES

- All curb & gutter radii are 15' at face of curb unless otherwise noted.
- Water & sewer as per plans by TOMAN ENGINEERING.
- Sanitary sewer is existing.
- Watermain is proposed, not existing as of date of plans.
- Engineer shall verify location of drop curb prior to construction.
- Proposed grades are to top of curb.

HORIZONTAL SCALE: 1" = 50'
 VERTICAL SCALE: 1" = 5'

--- Existing C ○ Manhole ⊕ Hydrant
 --- 50' Left → Sanitary Sewermain -|- Gate Valve
 --- 50' Right --- Watermain

