


EAST DRIVE
RIPPEL'S 2ND SUBDIVISION

FINAL SURVEY	SURVEYED	DATE
NOTE BOOK	PLOTTED	
NO.	TEMPERATURE	
	AREAS CHECKED	
	ALSO CHECKED	

ORIGINAL SURVEY	SURVEYED	DATE
NOTE BOOK	PLOTTED	
NO.	TEMPERATURE	
	AREAS CHECKED	
	ALSO CHECKED	

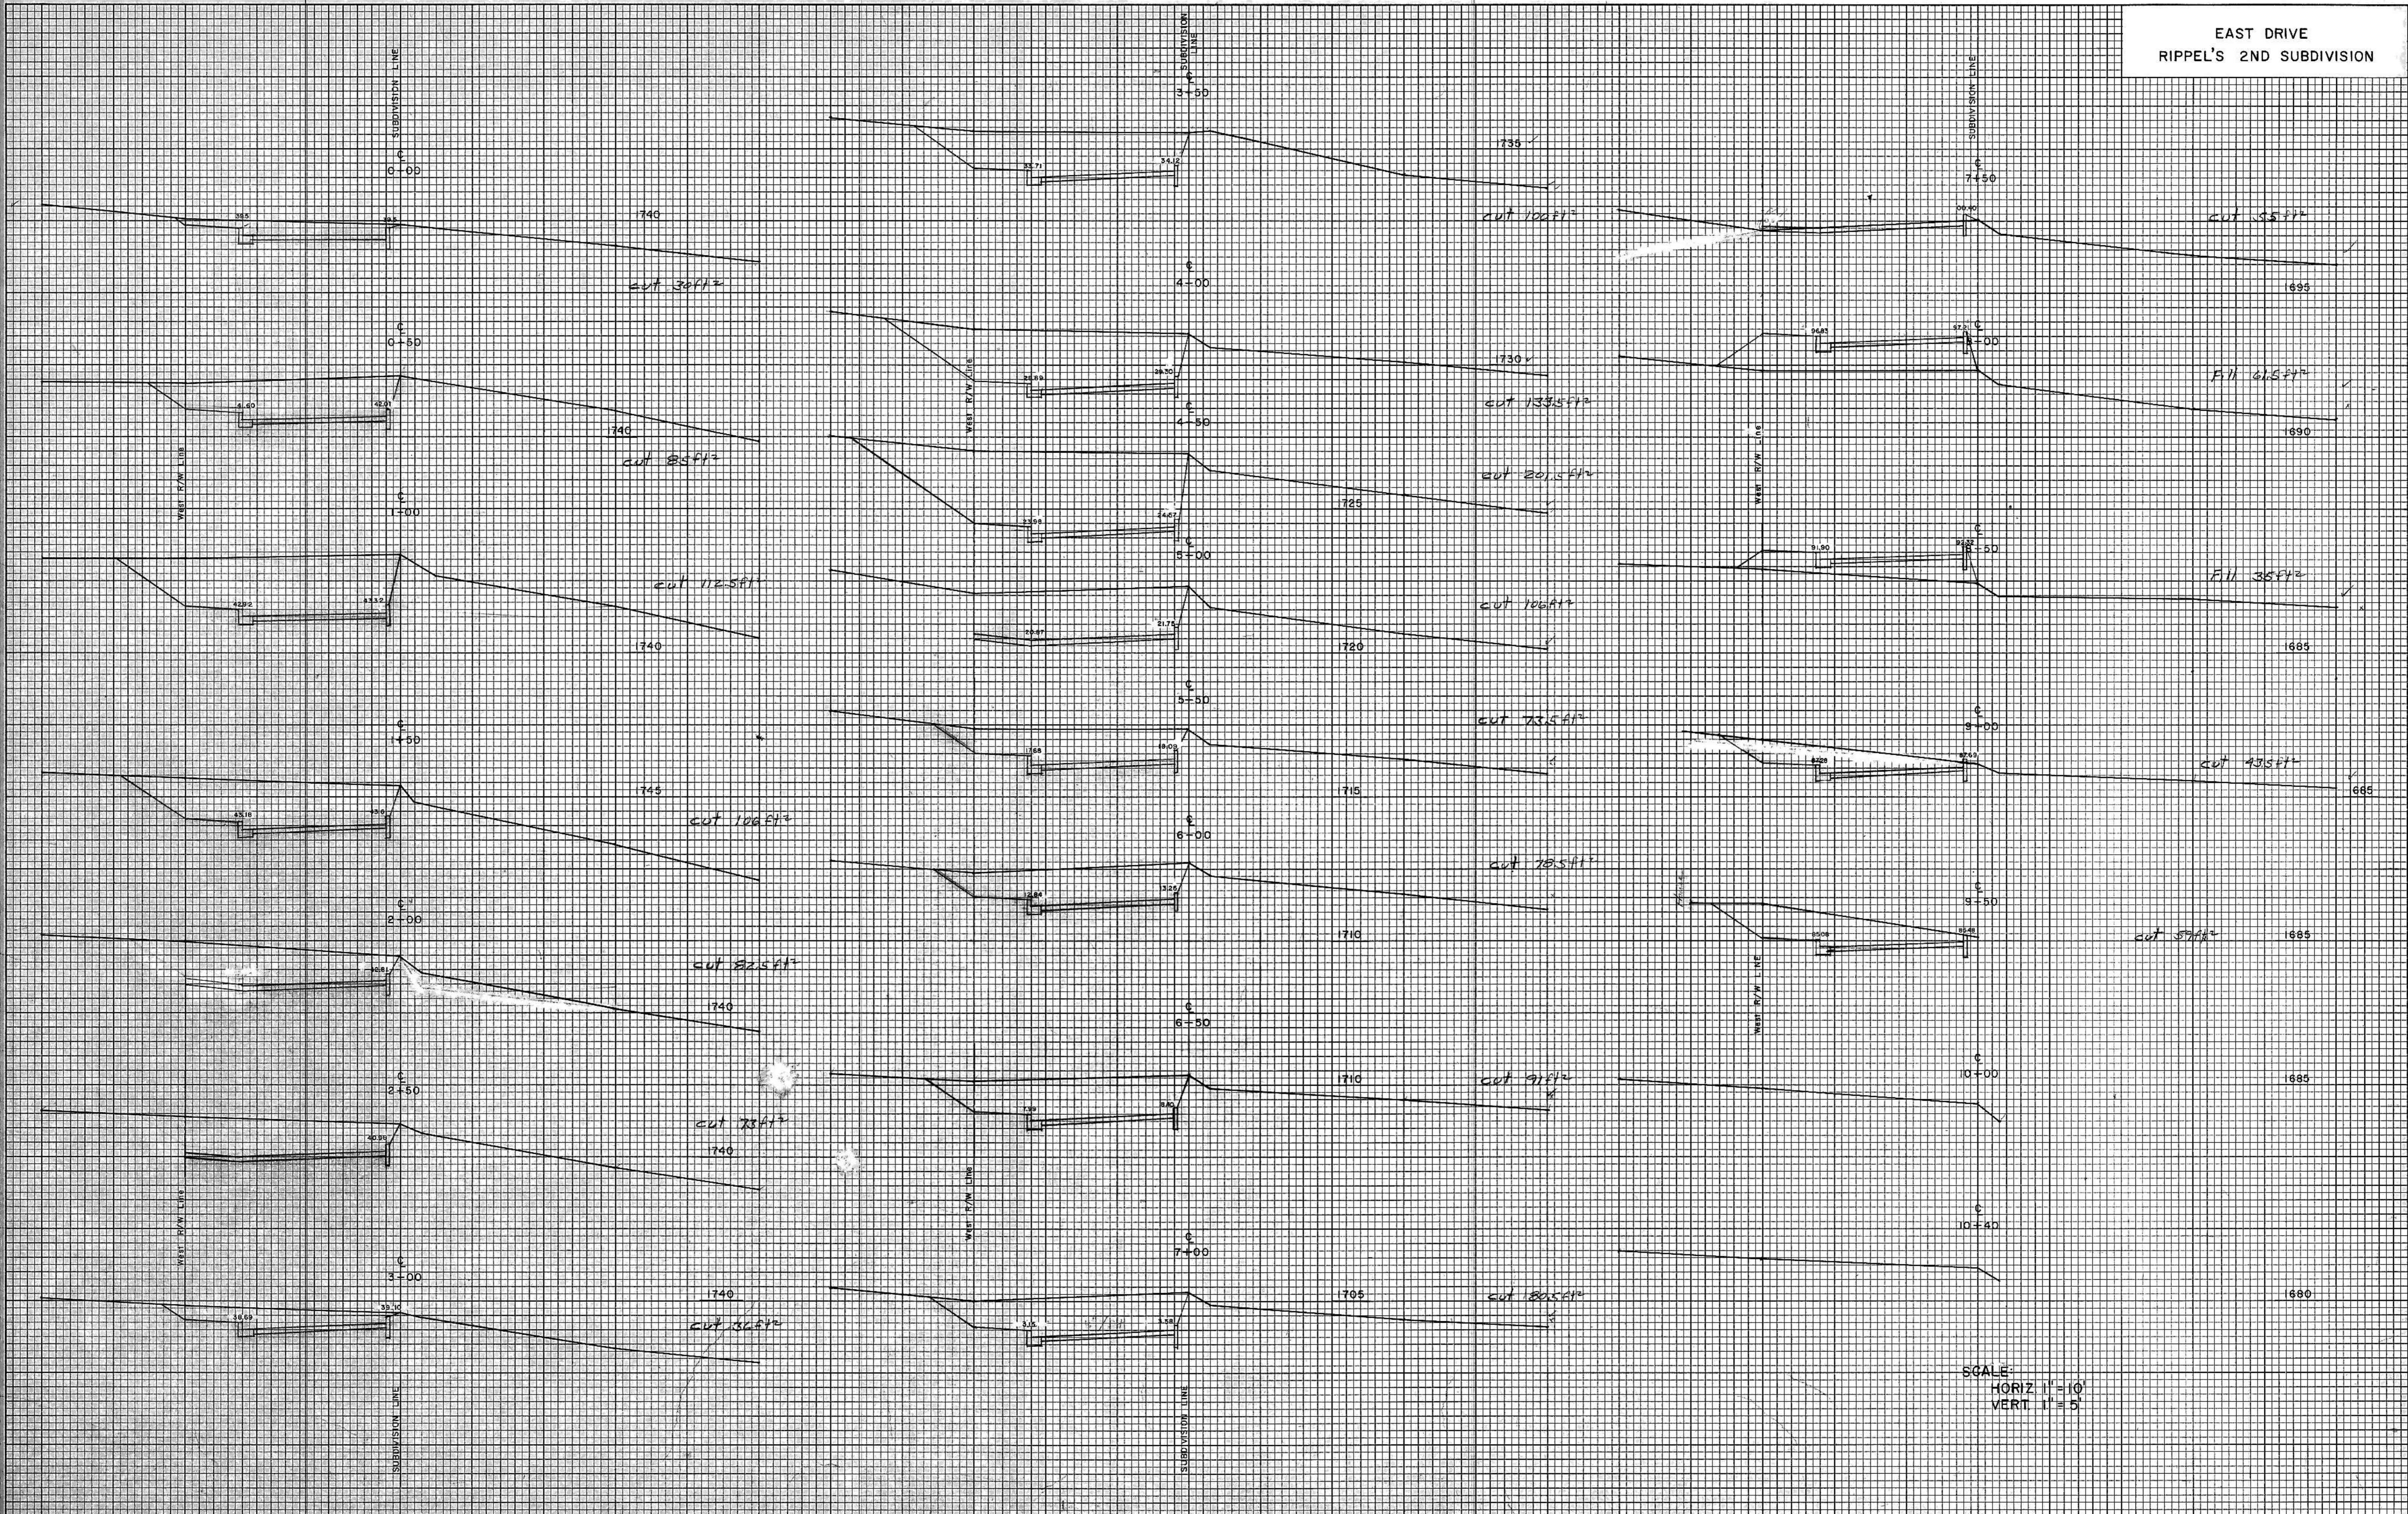

SCALE:
HORIZ 1" = 10'
VERT 1" = 5'