


DATE: \_\_\_\_\_  
 BY: \_\_\_\_\_  
 SURVEYED: \_\_\_\_\_  
 PLOTTED: \_\_\_\_\_  
 ALIGNED CHECKED: \_\_\_\_\_  
 NOTE BOOK No. \_\_\_\_\_

DATE: \_\_\_\_\_  
 BY: \_\_\_\_\_  
 SURVEYED: \_\_\_\_\_  
 PLOTTED: \_\_\_\_\_  
 ALIGNED CHECKED: \_\_\_\_\_  
 NOTE BOOK No. \_\_\_\_\_

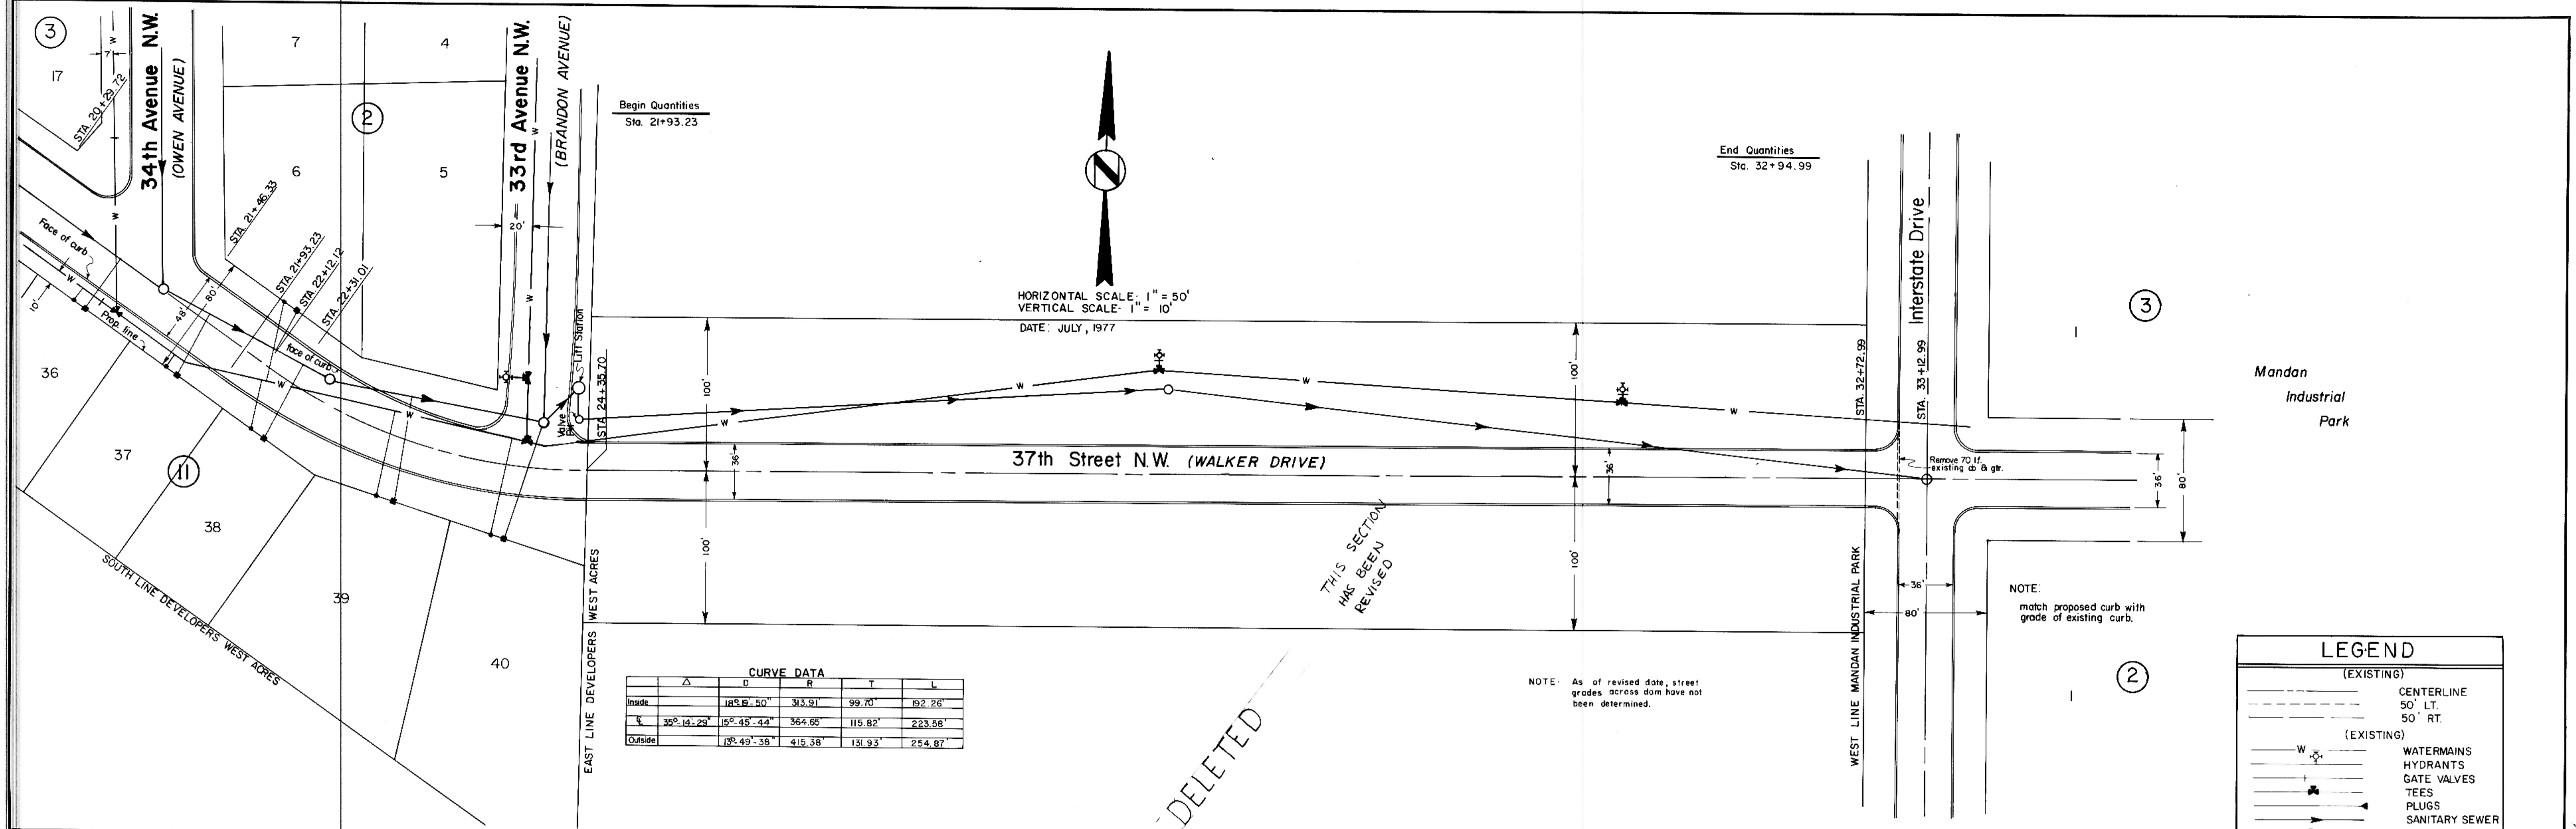


CURVE DATA

	Δ	D	R	T	L
Inside	18° 02' 50"	313.91	99.70	132.26'	
Outside	36° 14' 23"	15° 45' 44"	364.65'	115.82'	223.58'
Outside	18° 49' 38"	415.38	131.93'	254.87'	

LEGEND

(EXISTING)	CENTERLINE
(EXISTING)	50' LT.
(EXISTING)	50' RT.
(EXISTING)	WATERMAINS
(EXISTING)	HYDRANTS
(EXISTING)	GATE VALVES
(EXISTING)	TEES
(EXISTING)	PLUGS
(EXISTING)	SANITARY SEWER
(EXISTING)	SAN SEWER M.H.

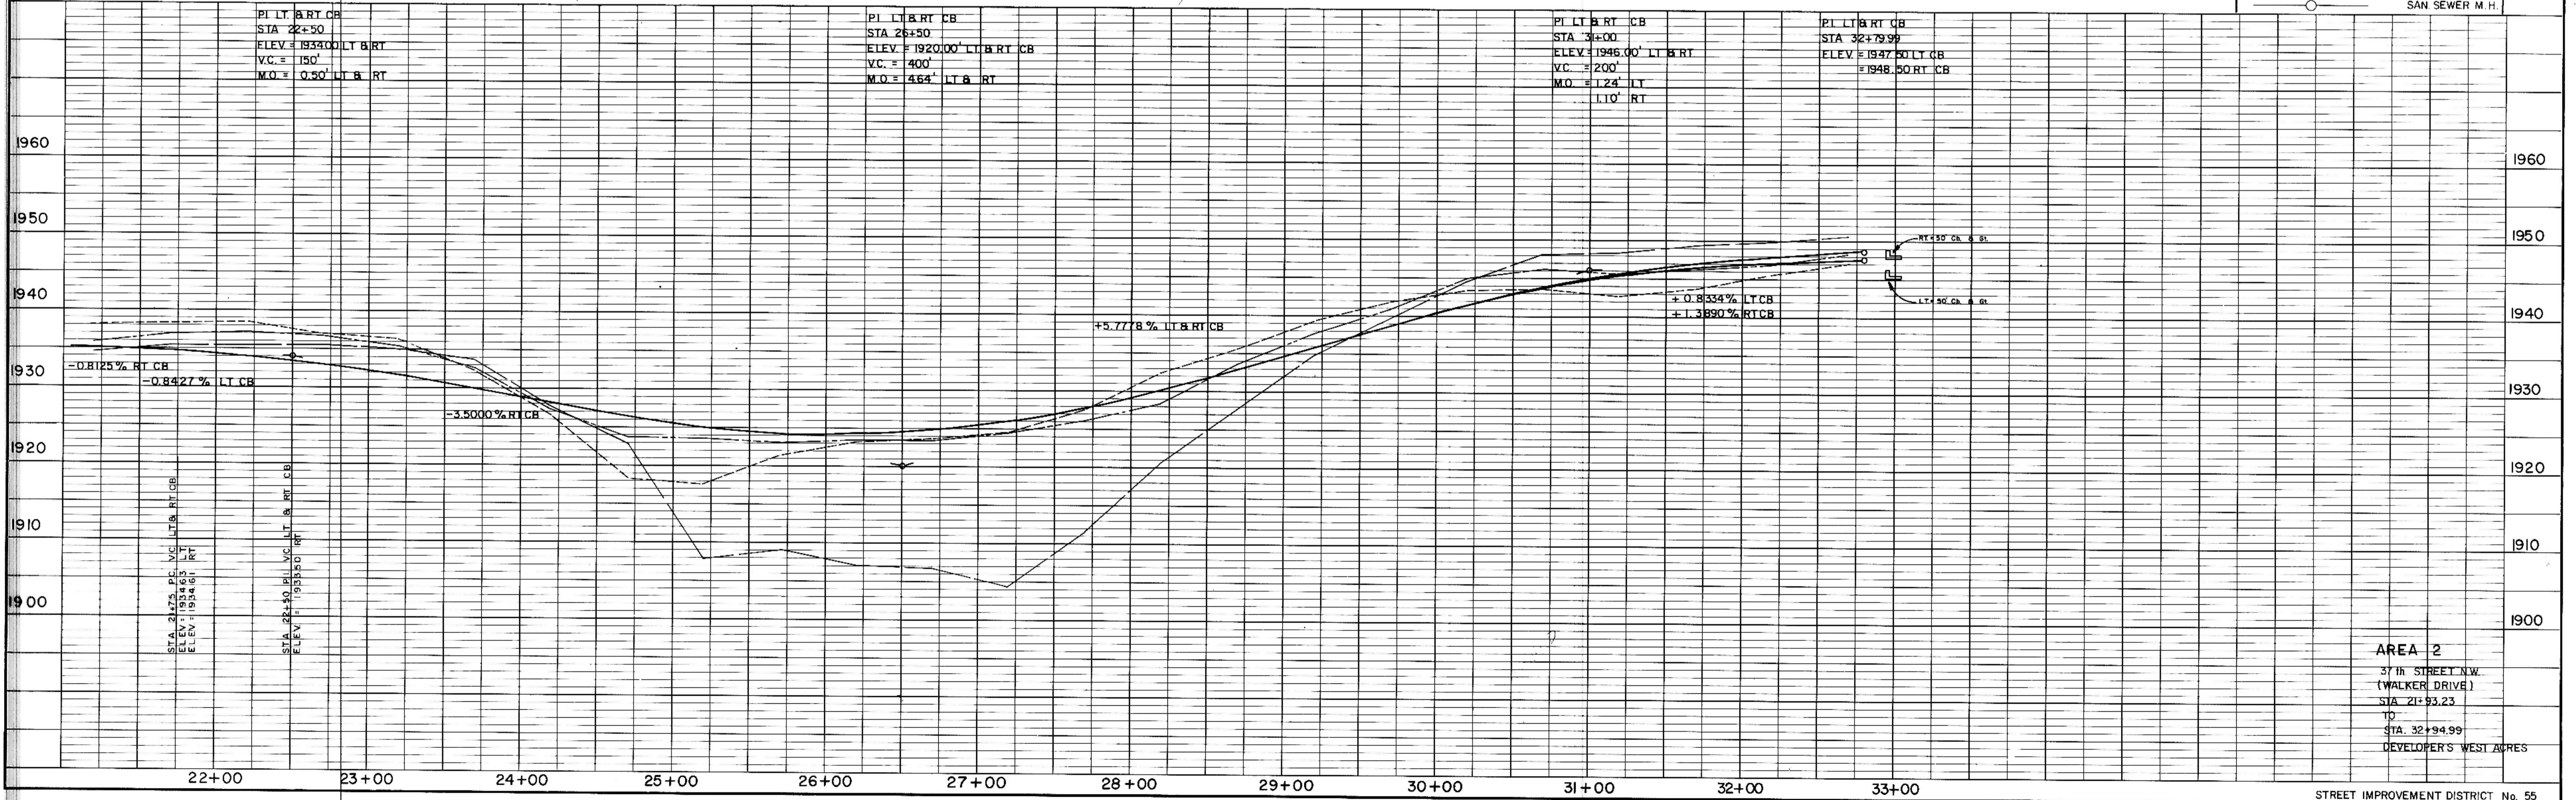

AREA 2  
 37th STREET N.W.  
 (WALKER DRIVE)  
 STA. 21+93.23  
 TO  
 STA. 32+94.99  
 DEVELOPERS' WEST ACRES