


# STREET IMPROVEMENT DISTRICT NO. 55 PROJECT LAYOUT



SCALE · 1" = 100'

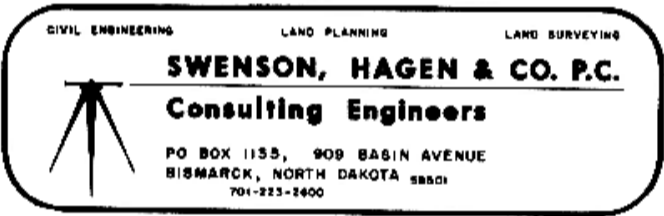

AREA 2  
DEVELOPER'S WEST ACRES

INTERSTATE DRIVE  
MANDAN INDUSTRIAL PARK

