
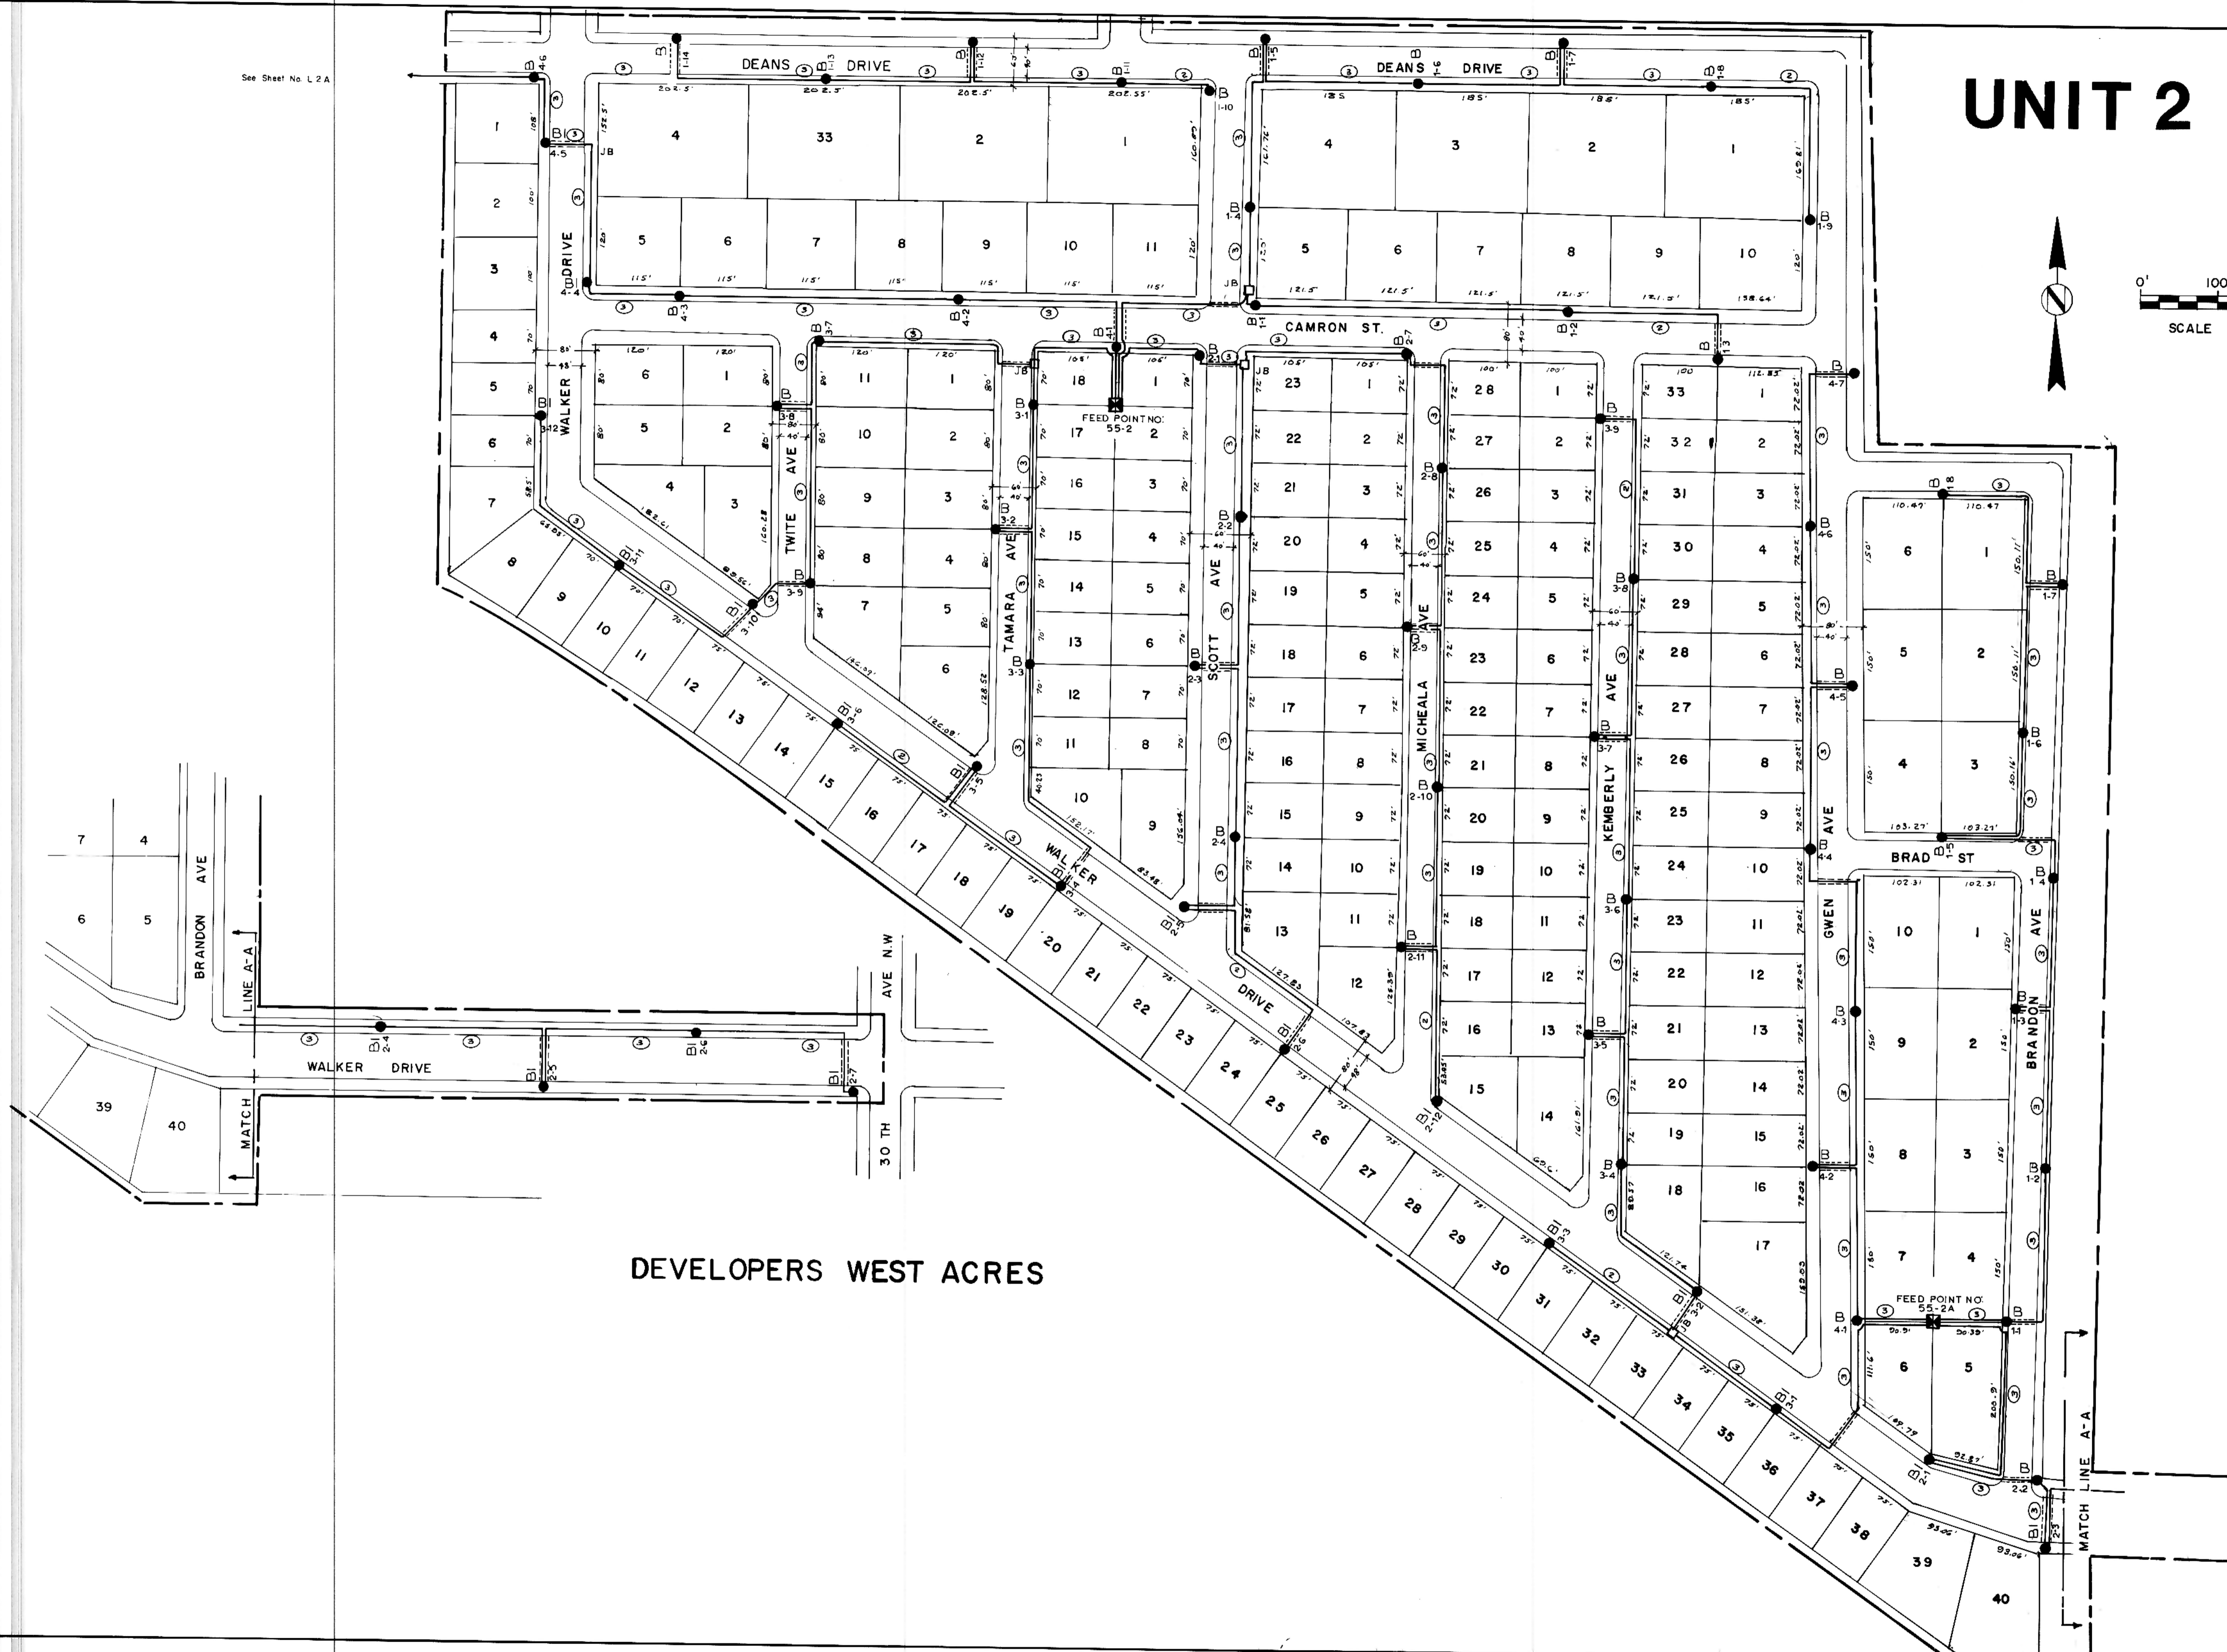


See Sheet No. L-2 A

# UNIT 2

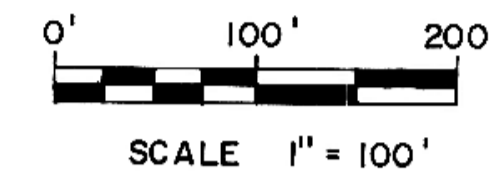

DEVELOPERS WEST ACRES

**SCHMIT, SMITH & RUSH**  
CONSULTING ENGINEERS  
MINOT NORTH DAKOTA