


DEVELOPER'S WEST ACRES WATER & SEWER DISTRICT NO. 24 PROJECT LAYOUT



LEGEND

- UTILITIES EASEMENT
- BUILDING SETBACK LINE
- MANHOLE
- SEWERMAIN
- GATE VALVE
- WATERMAIN
- ↑ HYDRANT WITH 6" GATE VALVE
- PLUG
- TEE & FITTINGS
- 6" FORCEMAIN
- WYES RUN 8" BRANCH 6"
RUN 8" BRANCH 8"
- CROSS
- BEND

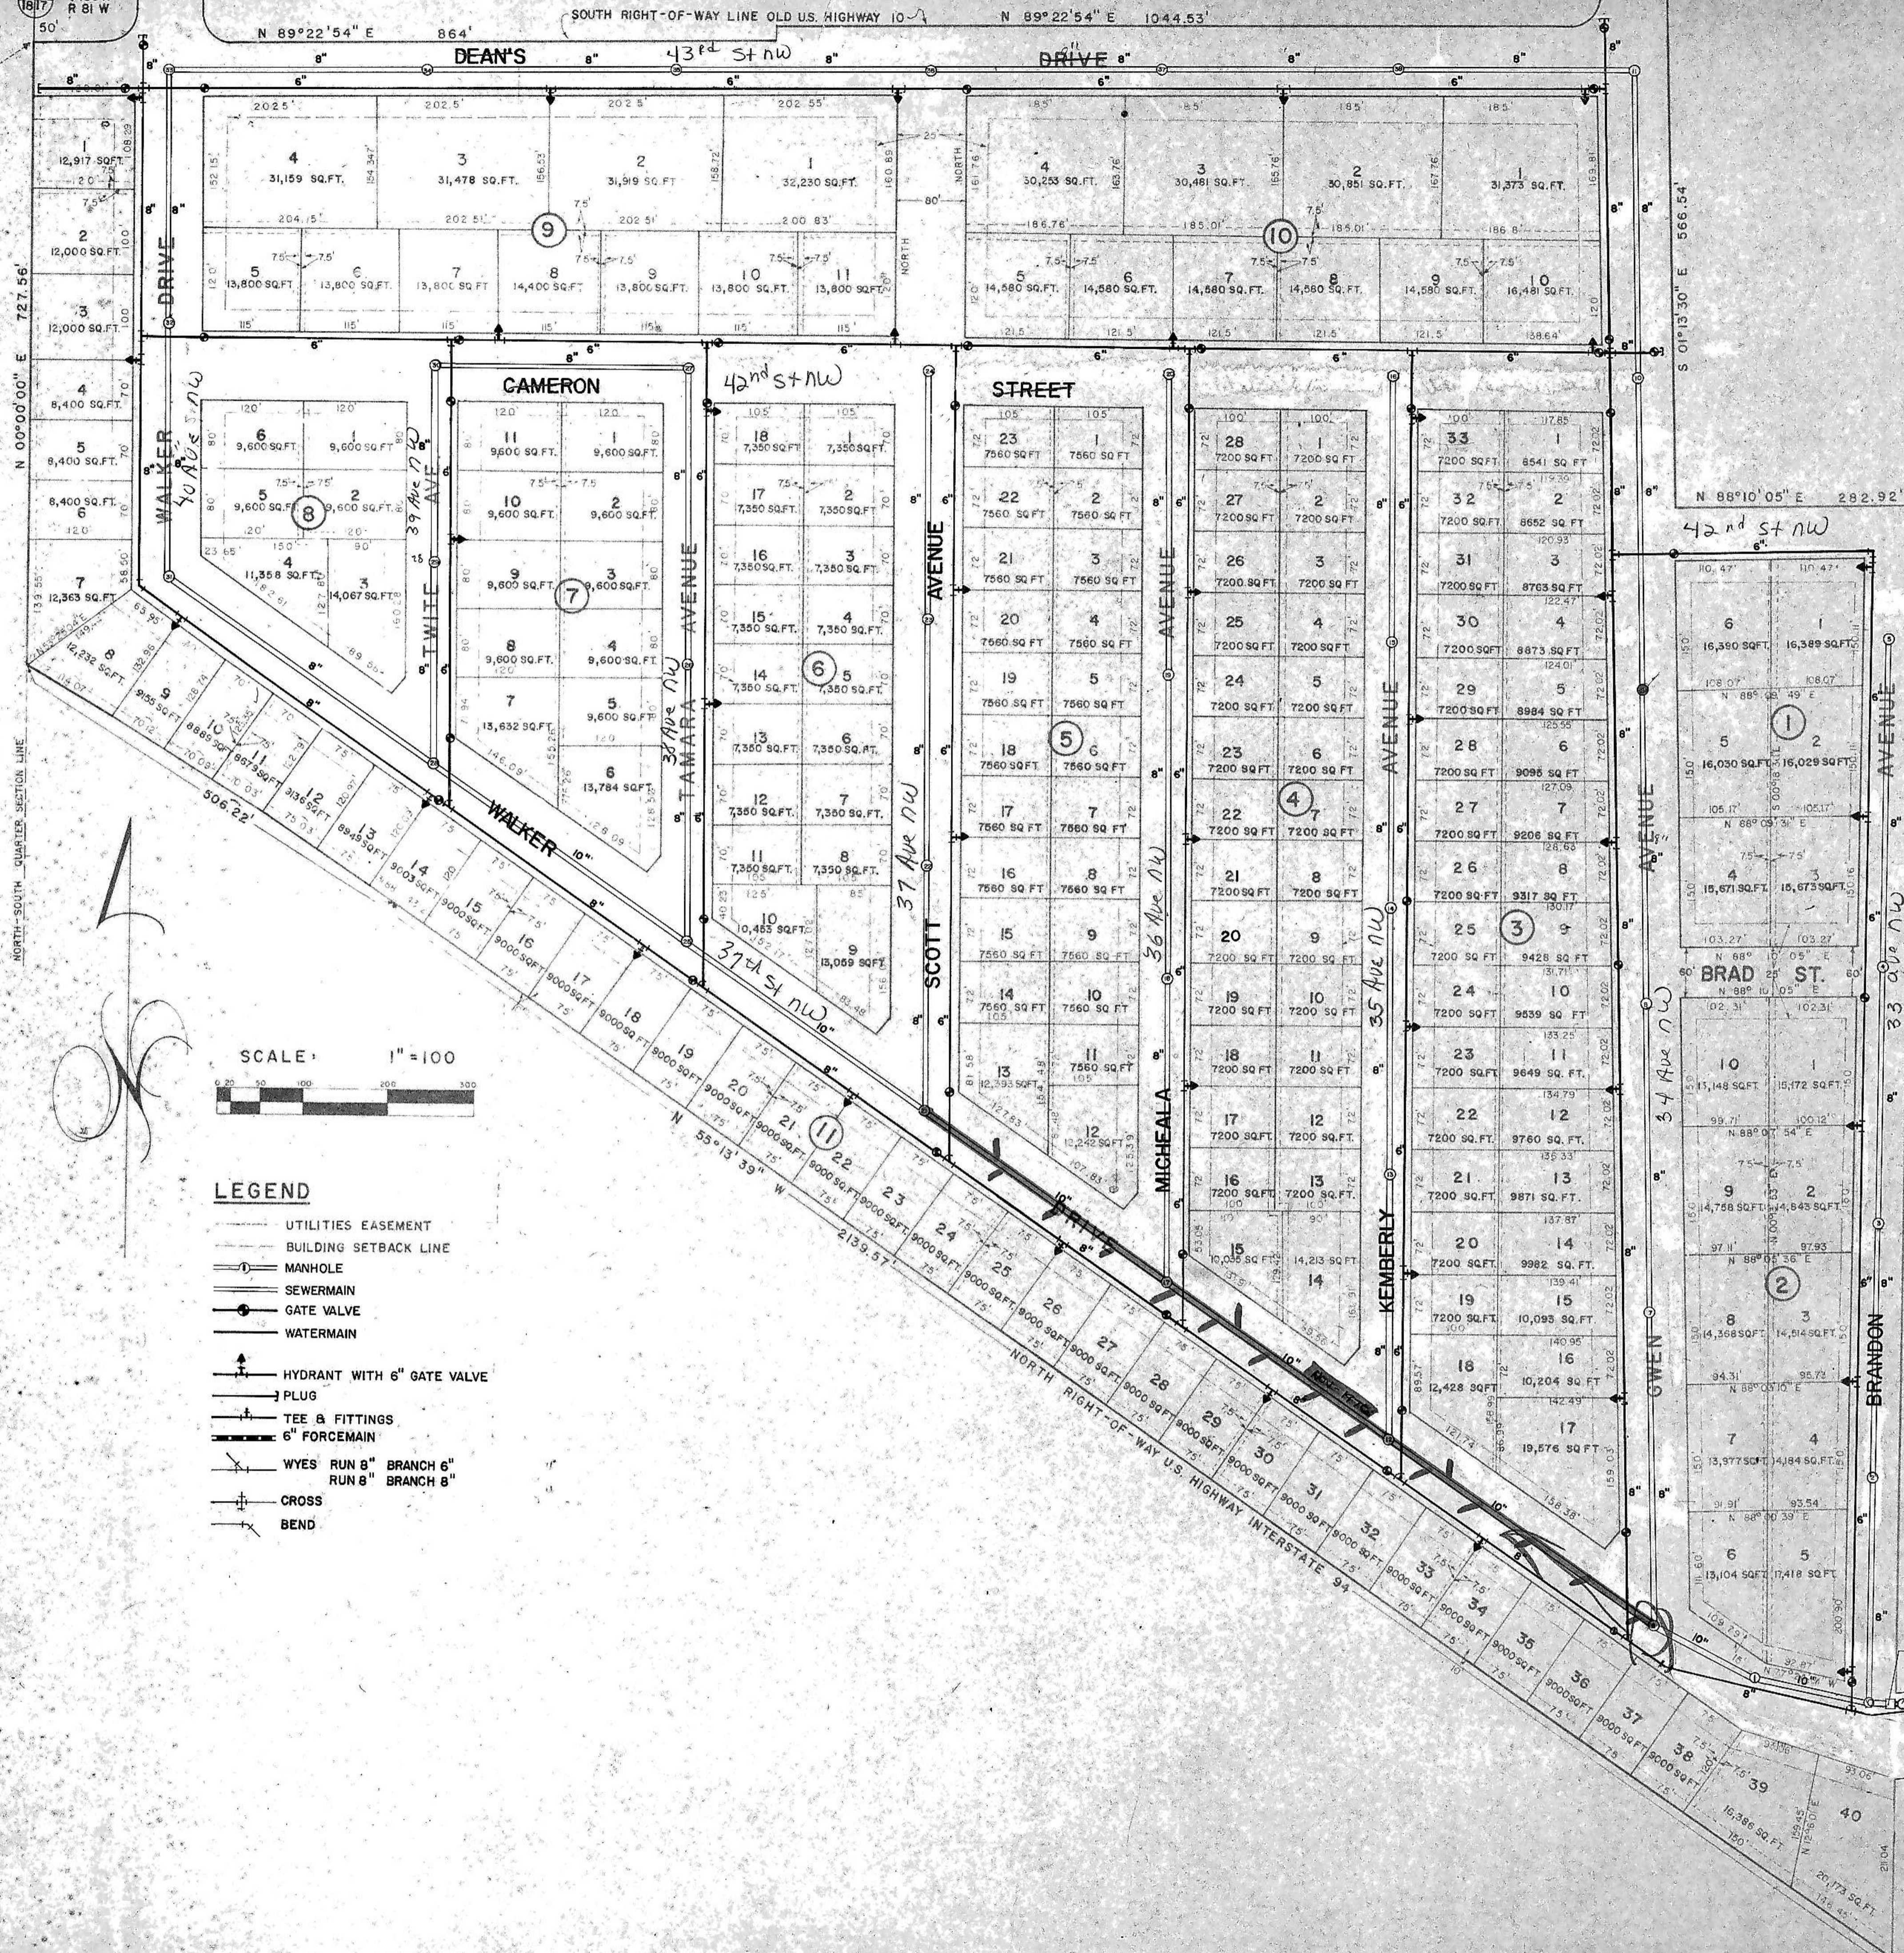

Toman Engineering Company
Civil & Environmental Consultants
P. O. Box 708 P. O. Box 852
Mandan, ND 58542