


DATE: \_\_\_\_\_ BY: \_\_\_\_\_  
 SUPERVISOR: \_\_\_\_\_  
 PLAN NOTE BOOK NO. \_\_\_\_\_  
 ROUTE: \_\_\_\_\_  
 GRADES CHECKED: \_\_\_\_\_  
 E.L. OF MAIN CENTERLINE: \_\_\_\_\_



DATE: \_\_\_\_\_ BY: \_\_\_\_\_  
 SUPERVISOR: \_\_\_\_\_  
 PROFILE NOTE BOOK NO. \_\_\_\_\_  
 ROUTE: \_\_\_\_\_  
 GRADES CHECKED: \_\_\_\_\_  
 E.L. OF MAIN CENTERLINE: \_\_\_\_\_

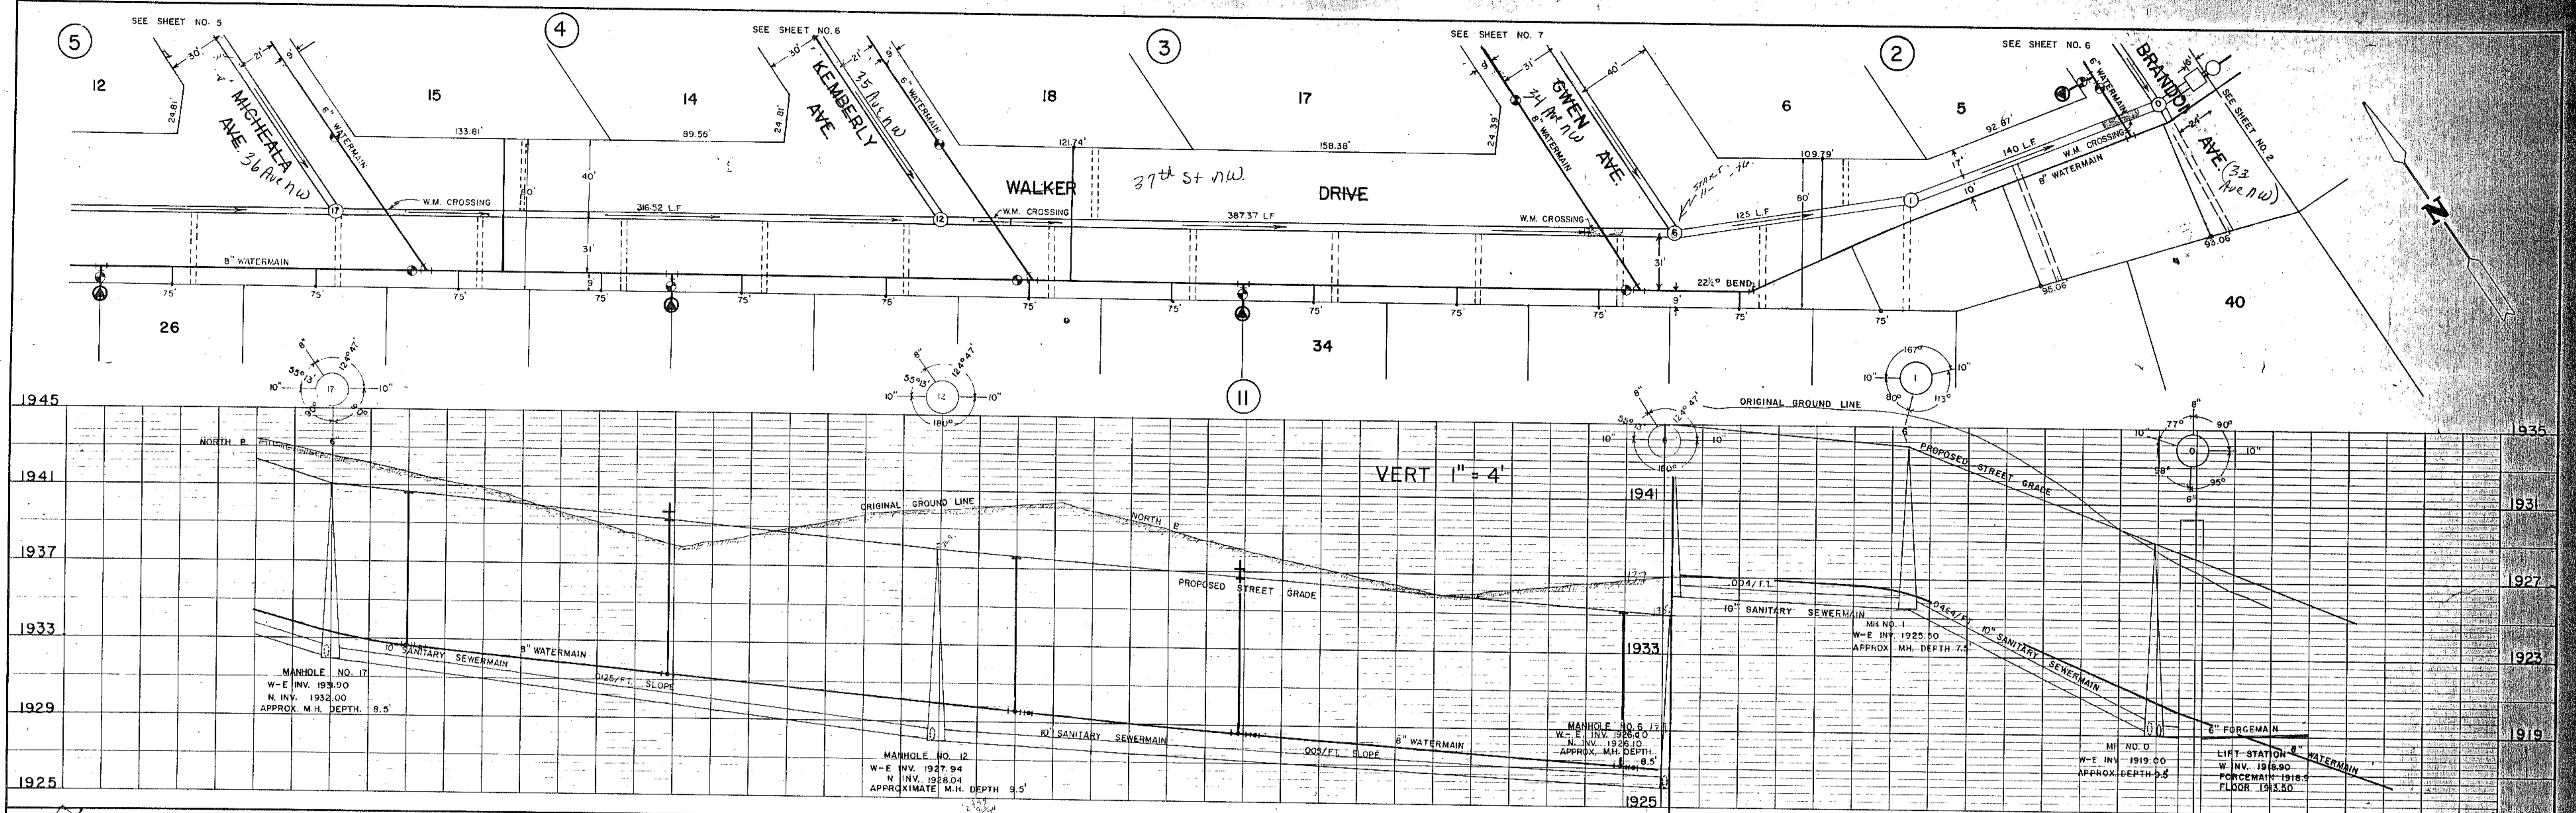