
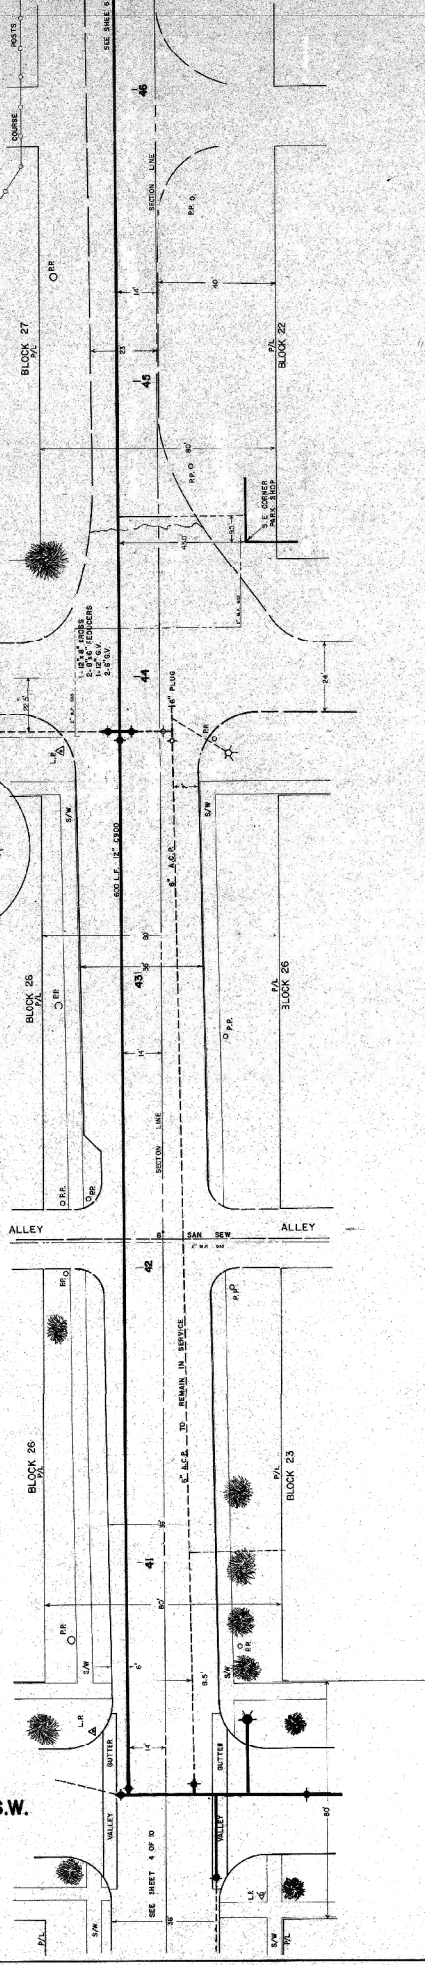



10th AVE S.W.

HORZ 1" = 20'
VERT 1" = 2'

9th AVE S.W.

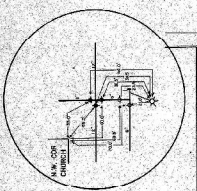

3rd ST. S.W.

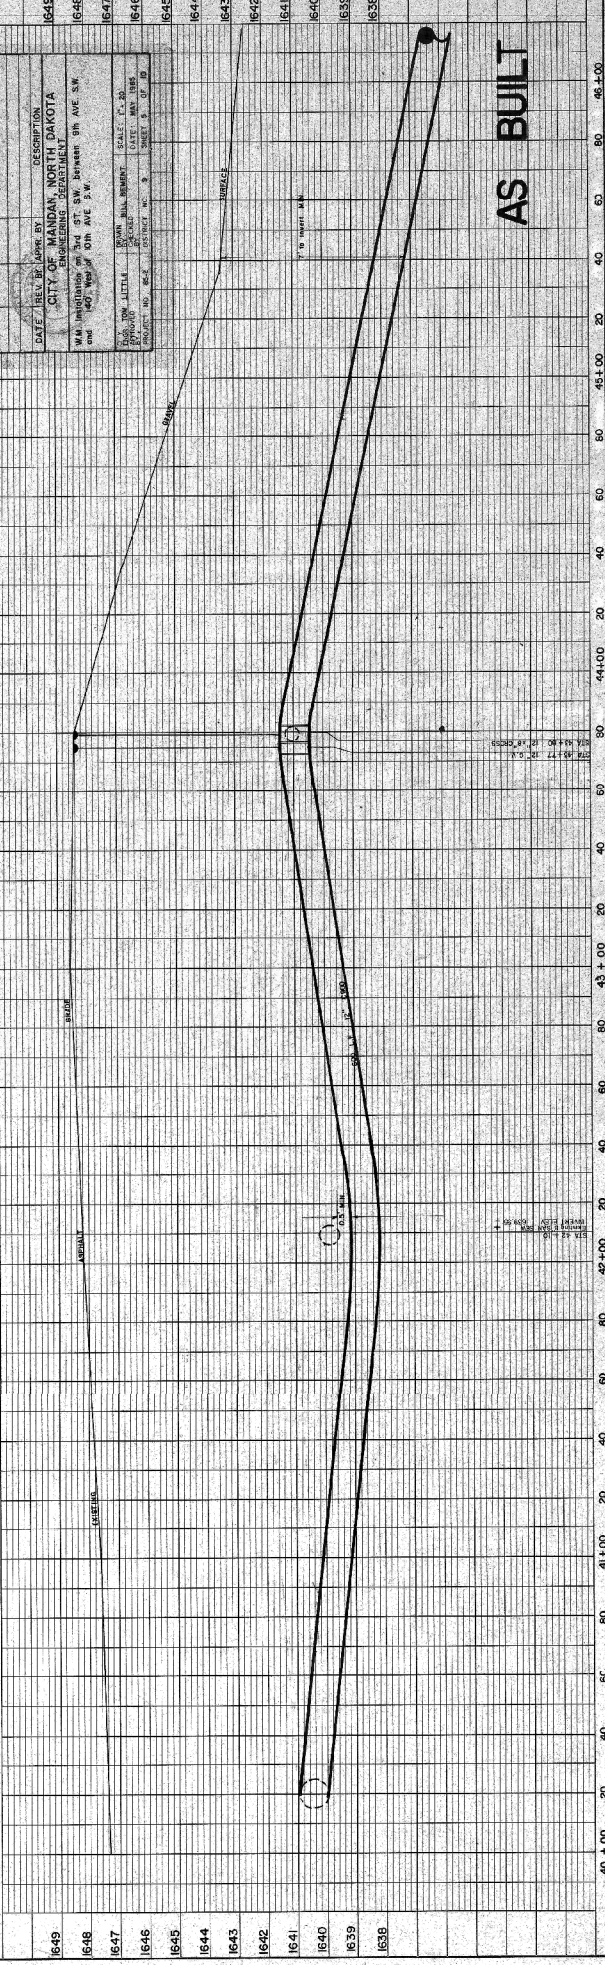

AS BUILT

DATE	REV.	BY	DESCRIPTION
1643			
1648			
1647			
1646			
1645			
1644			
1643			
1642			
1641			
1640			
1639			
1638			

PROJECT 85- SHEET 5 OF 10

PLAN
NOTE BOOK
DRAWN BY
CHECKED BY
DATE
SCALE

PROFILE
NOTE BOOK
DRAWN BY
CHECKED BY
DATE
SCALE