
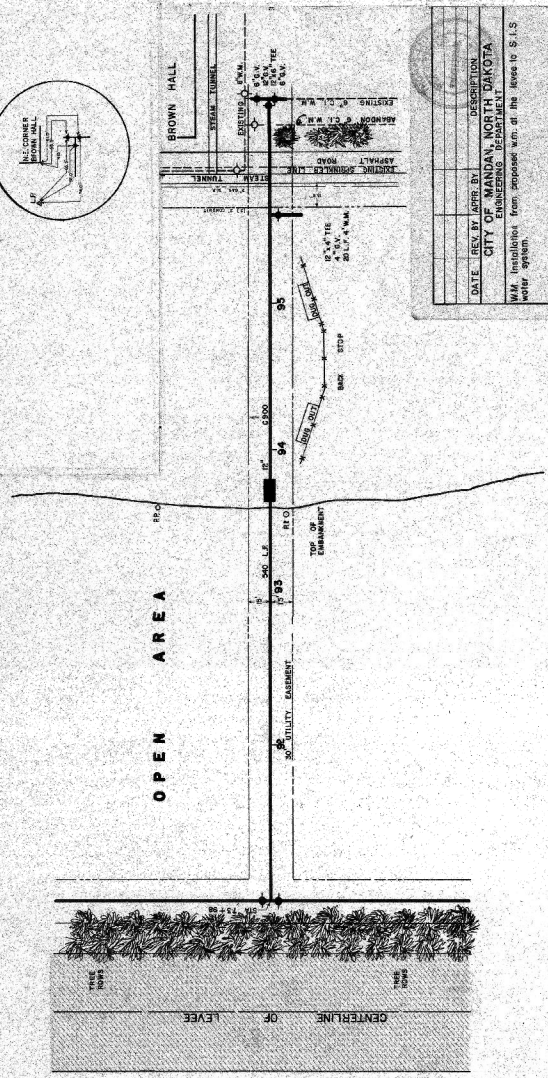


AS BUILT


N
HORIZ = 1" = 40'
VERT 1" = 2'

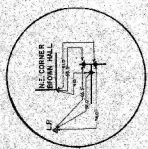

DATE	REV. BY	APP. BY	DESCRIPTION
			CITY OF MANDAN, NORTH DAKOTA ENGINEERING DEPARTMENT

M.W. installed from proposed term of the lines to S.I.S.
Comp. option.

DESIGNED BY	DATE	SCALE
PROJECT NO.	DISTRICT NO.	SHEET NO. OF

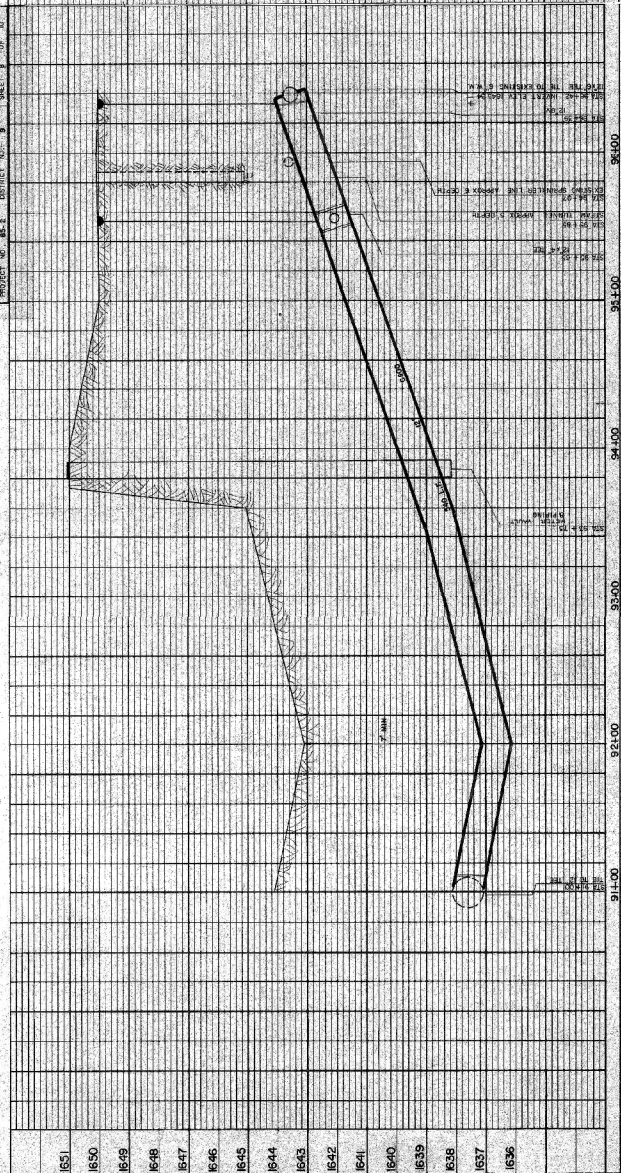

DATE	REVISION

DATE	REVISION

- 1651
- 1650
- 1649
- 1636