


APRIL 1993
 0 20 40 60 80
 SCALE: 1"=20' HOR
 1"=5' VER

DIVISION ST NW

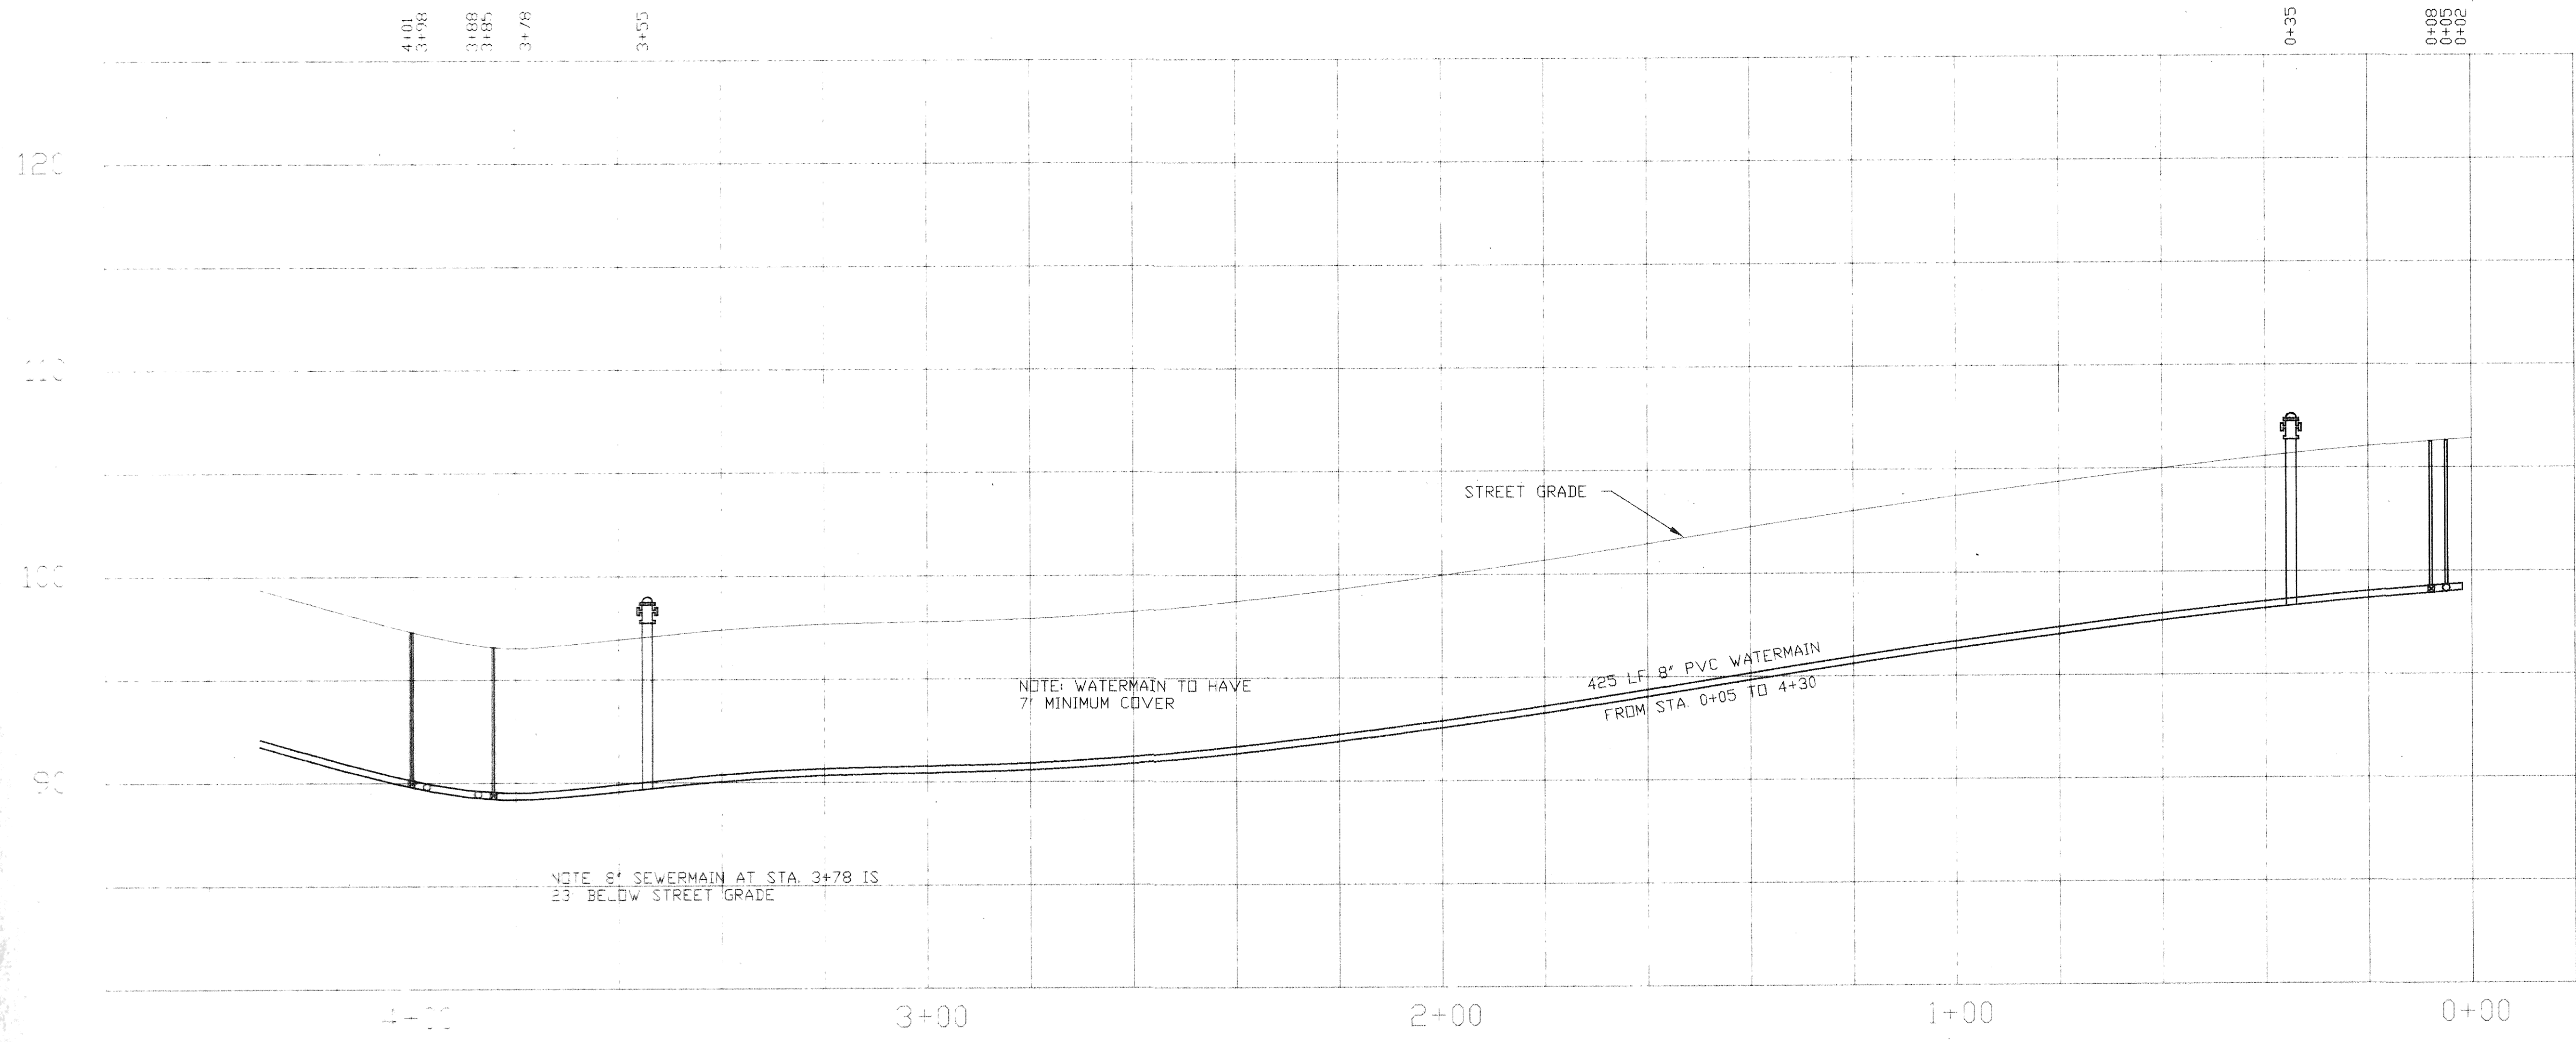

- STA. 0+02
8" PLUG
- STA. 0+05
TIE INTO EXISTING 6" W.M.
2-8x6 REDUCER
8" G.V.
3 LF 8" PVC
8x8 CROSS
6 LF 8" PVC
- STA. 0+08
8" G.V.
- STA. 0+35
6" HYDRANT
20 LF 6" HYDRANT LEAD
6" G.V.
3 LF 6" HYDRANT LEAD
8x6 TEE
- STA. 3+55
REMOVE AND SALVAGE HYDRANT
6" HYDRANT
20 LF 6" HYDRANT LEAD
6" G.V.
3 LF 6" HYDRANT LEAD
8x6 TEE
- STA. 3+85
8" G.V.
- STA. 3+88
8x8 TEE
- STA. 3+98
8x8 TEE
- STA. 4+01
8" G.V.

FEB. 1995	JW	TL	AS BUILT
DATE	REV. BY	APPR. BY	DESCRIPTION
CITY OF MANDAN, NORTH DAKOTA ENGINEERING DEPARTMENT			
WATER IMPROVEMENT PROJECT 93-4 DIVISION ST NW			
CITY ENG. BY T. LITTLE	DRAWN BY J. WRIGHT	SCALE AS SHOWN	
APPR. BY	CHECKED BY	DATE	
PROJECT 93-4	DISTRICT	SHEET 1 OF 9	