



PLAN
 SUBMITTAL
 NOTE BOOK
 NO. OF WAY CHECKED
 DATE

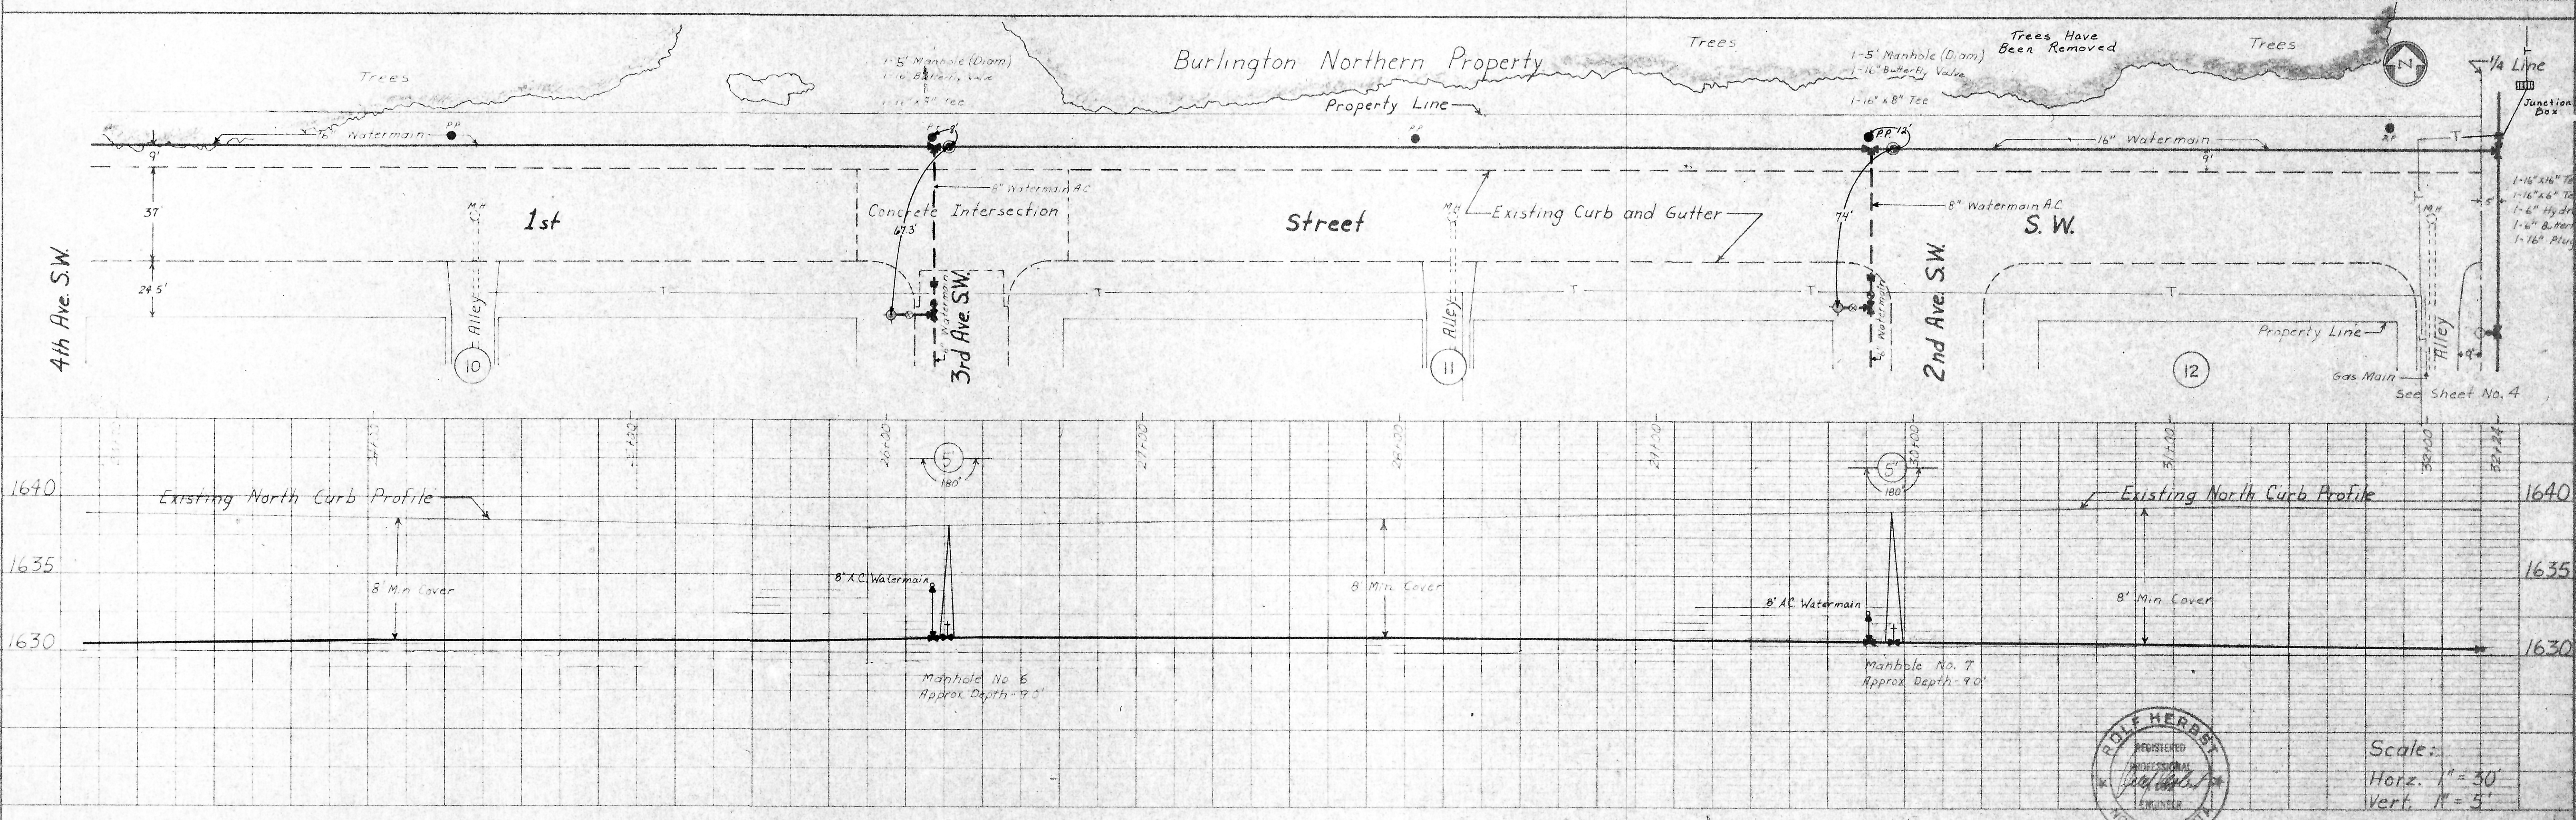

PROFILE
 SUBMITTAL
 NOTE BOOK
 NO. OF WAY CHECKED
 DATE

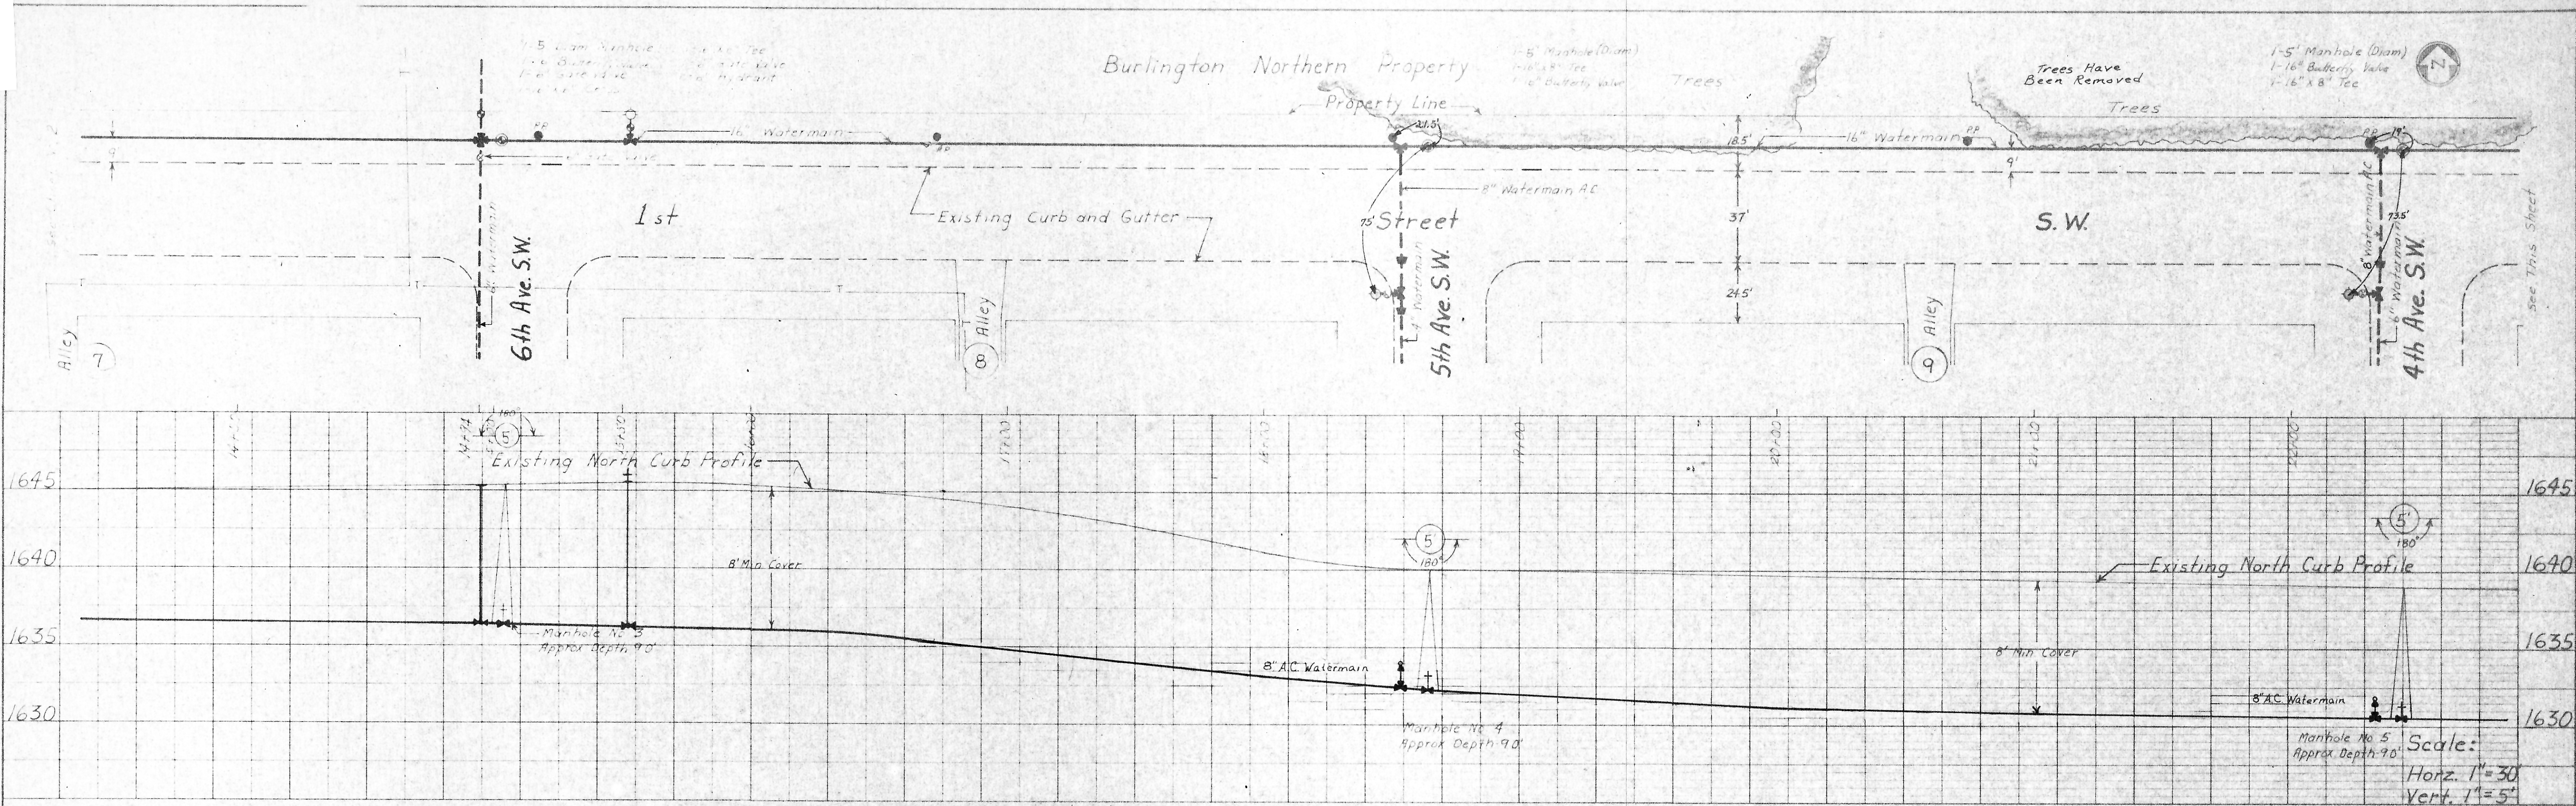