

CITY OF MANDAN

CONNECT TO EXISTING WATERMAIN


ALTERNATE ROUTING (Not installed)

PRIMARY ROUTING (Not installed)

CONNECT TO EXISTING WATERMAIN BY BOOSTER STATION

CORPORATE LIMITS

CORPORATE LIMITS

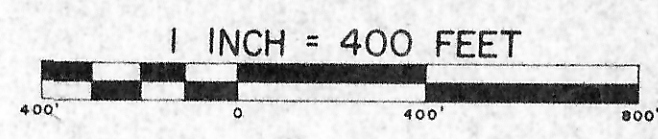

LEGEND

- 20" WATERMAIN
- 12" WATERMAIN
- 16" WATERMAIN
- 12" WATERMAIN (ALTERNATE)



WATER IMP. DIST. NO. 3
E.D.A. PROJECT NO. 05-5120808
MANDAN, N.D.

SHEET NO. 1 OF 13 SHEETS