
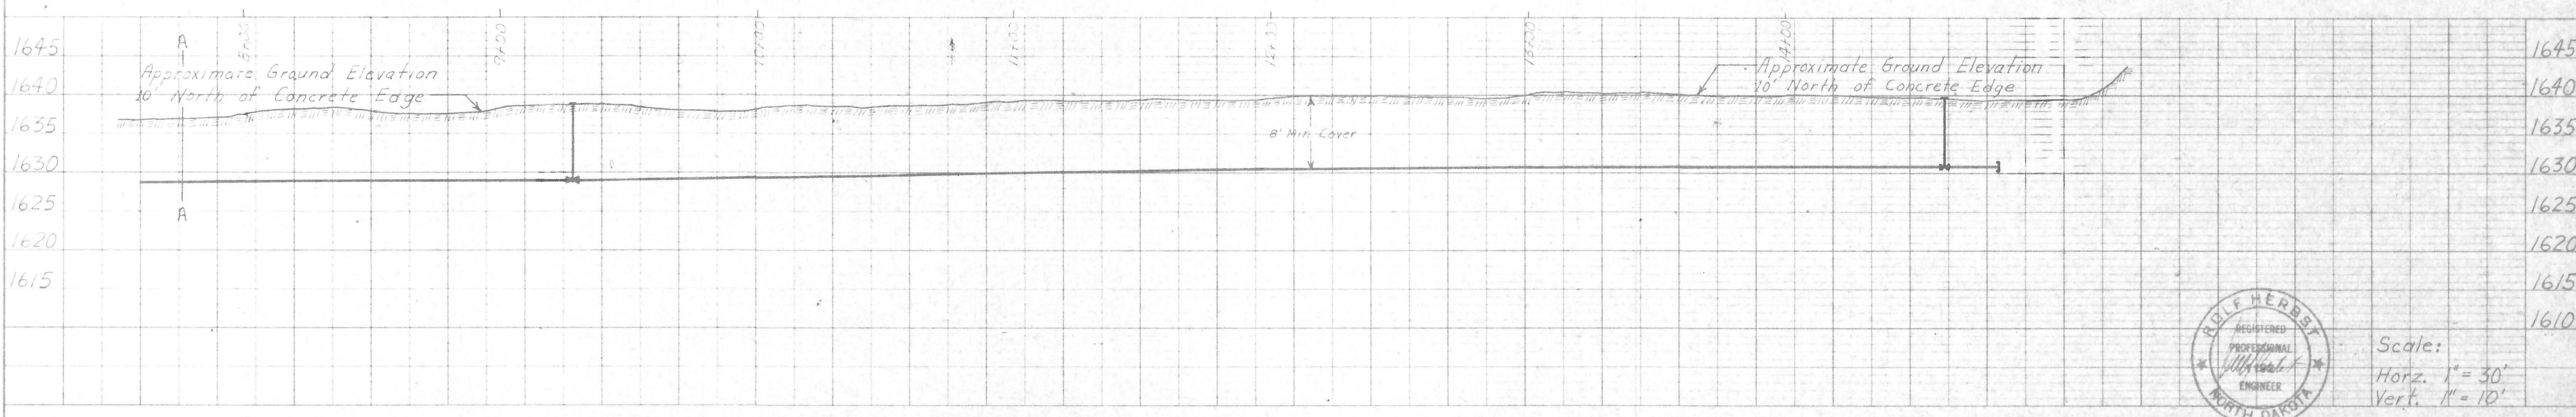


Scale:
 Horz. 1" = 30'
 Vert. 1" = 10'

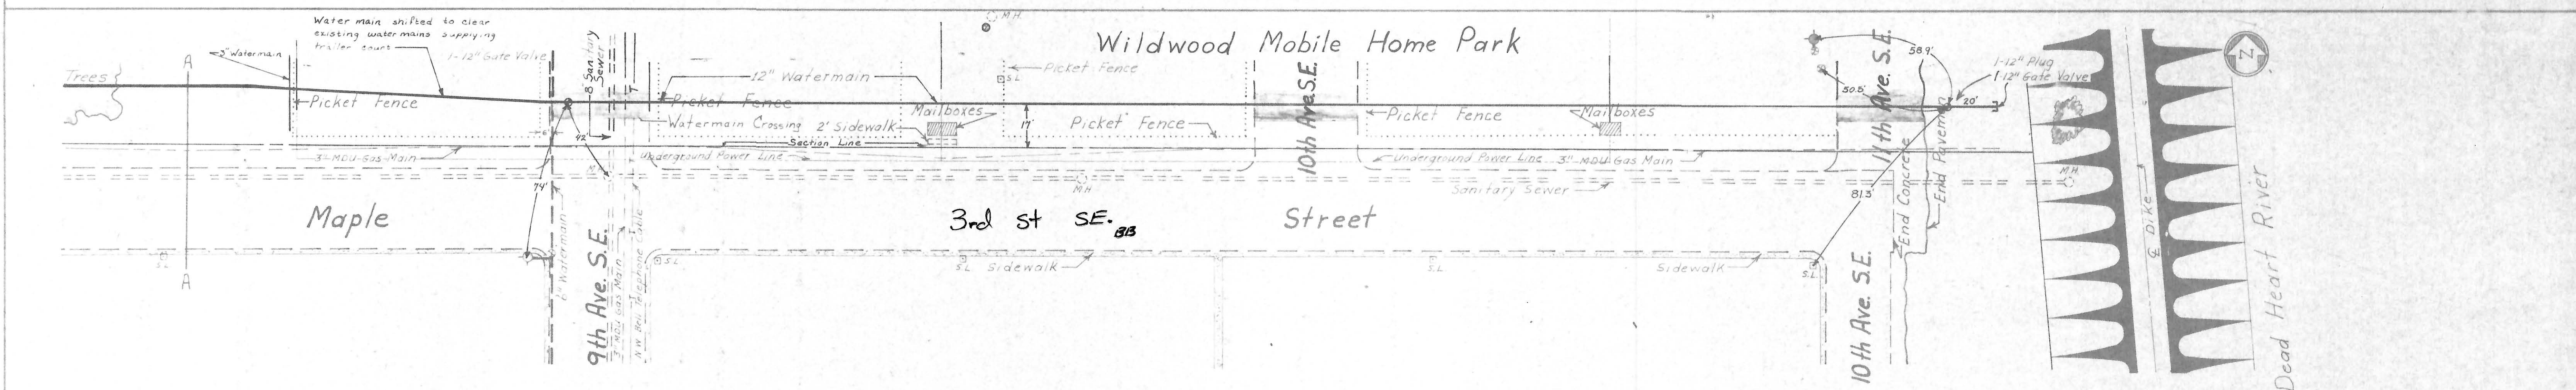

Scale:
 Horz. 1" = 30'
 Vert. 1" = 10'