
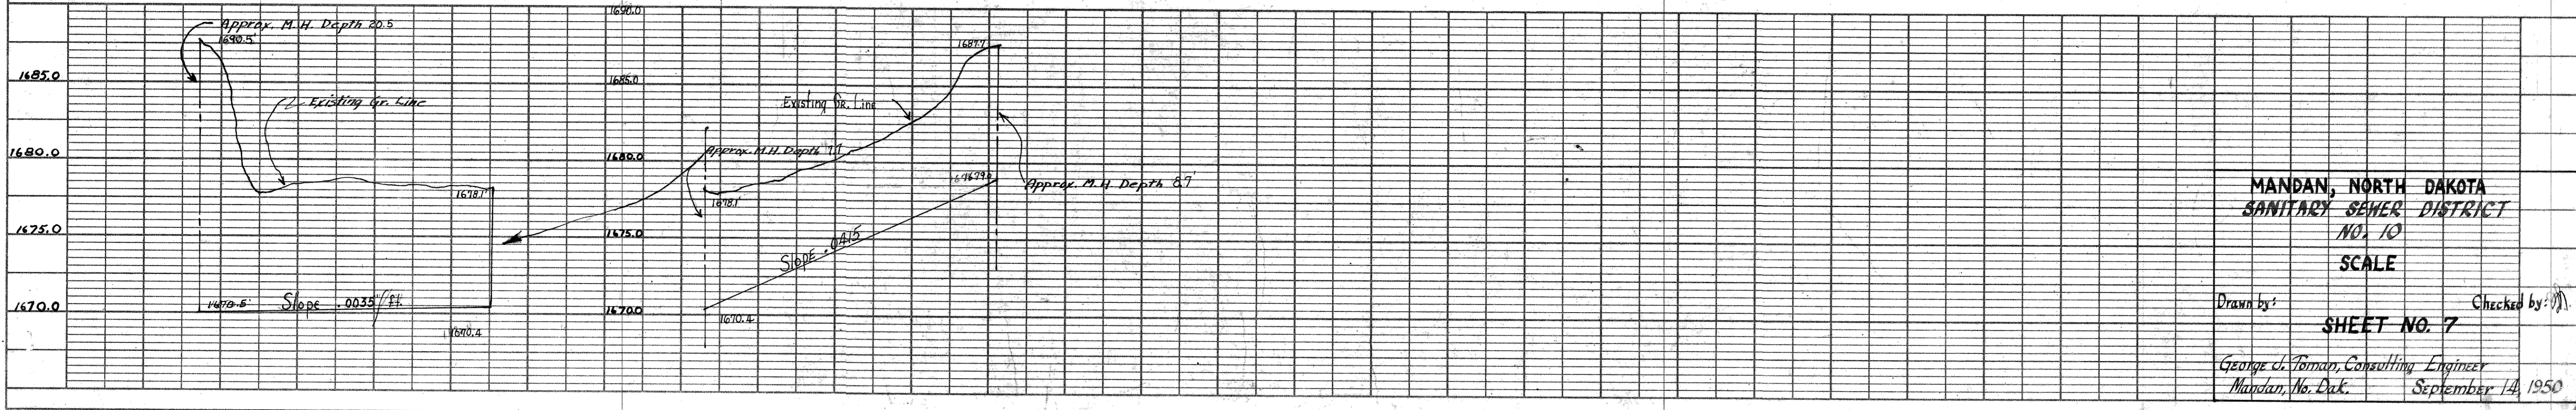
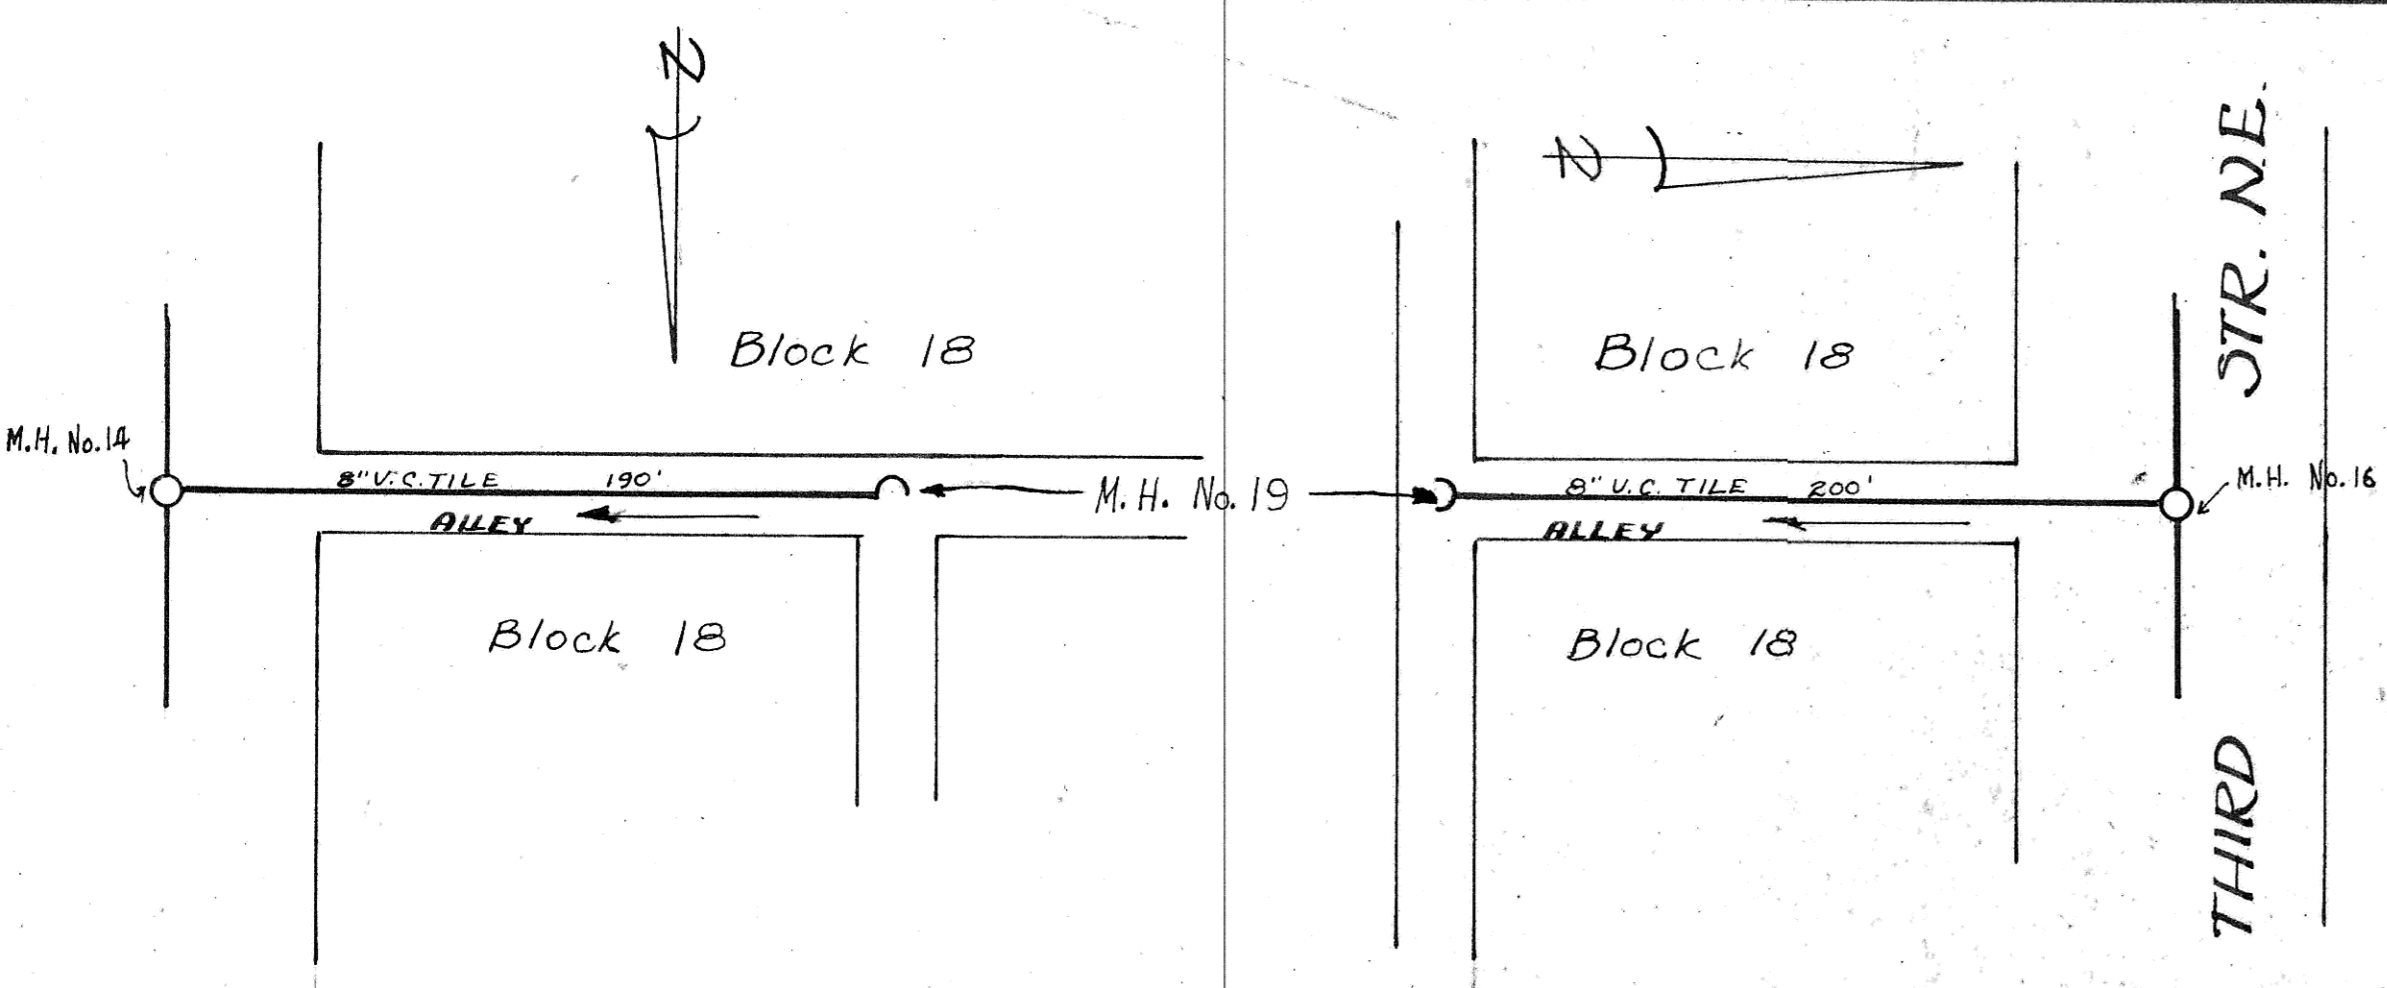
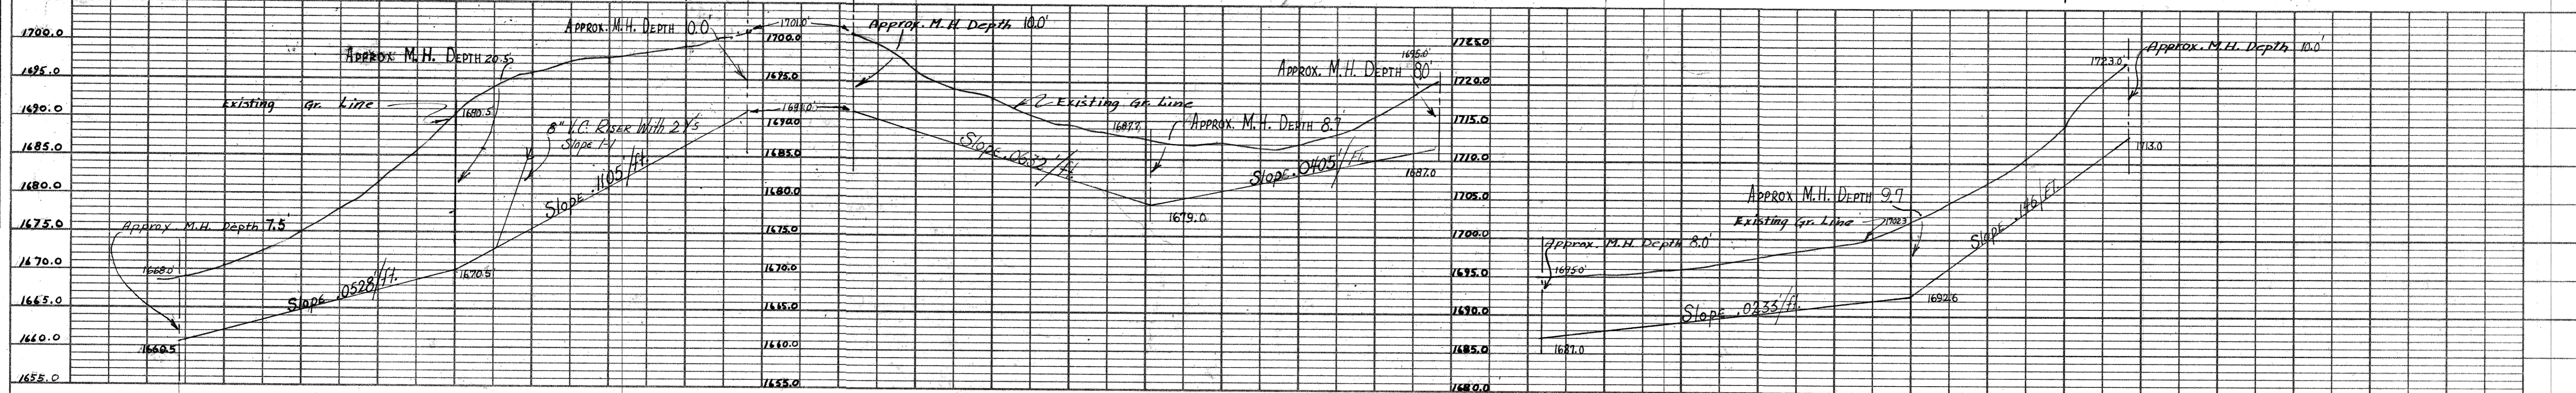


DATE: _____
 BY: _____
 SURVEYED: _____
 NOTE BOOK: _____
 NO. OF WAY CHECKED: _____

DATE: _____
 BY: _____
 SURVEYED: _____
 NOTE BOOK: _____
 NO. OF WAY CHECKED: _____

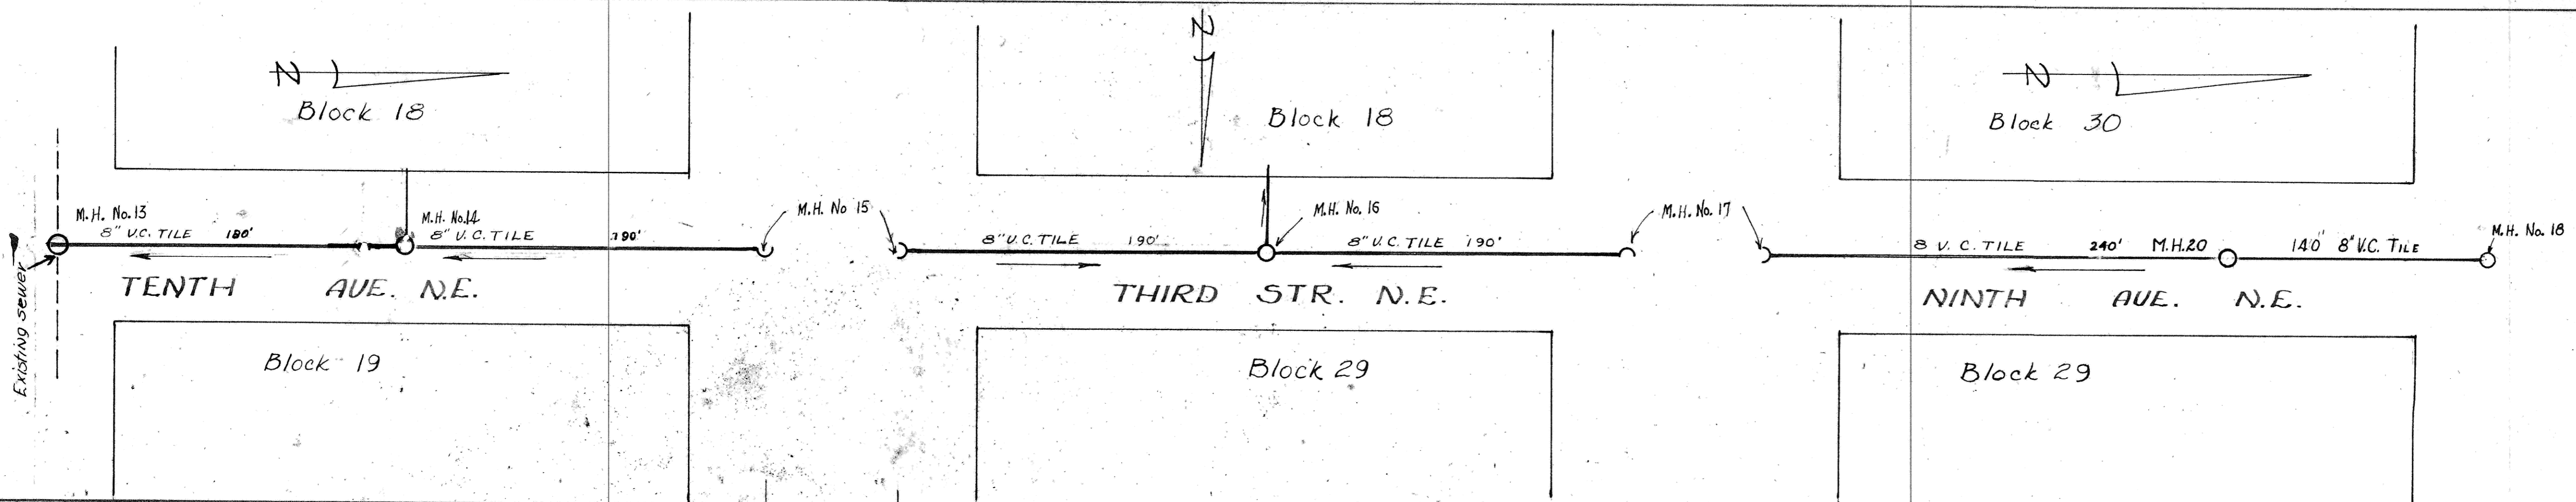

MANDAN, NORTH DAKOTA
 SANITARY SEWER DISTRICT
 NO. 10
 SCALE

Drawn by: _____ Checked by: _____
 SHEET NO. 7

George J. Tomar, Consulting Engineer
 Mandan, No. Dak. September 14, 1950