
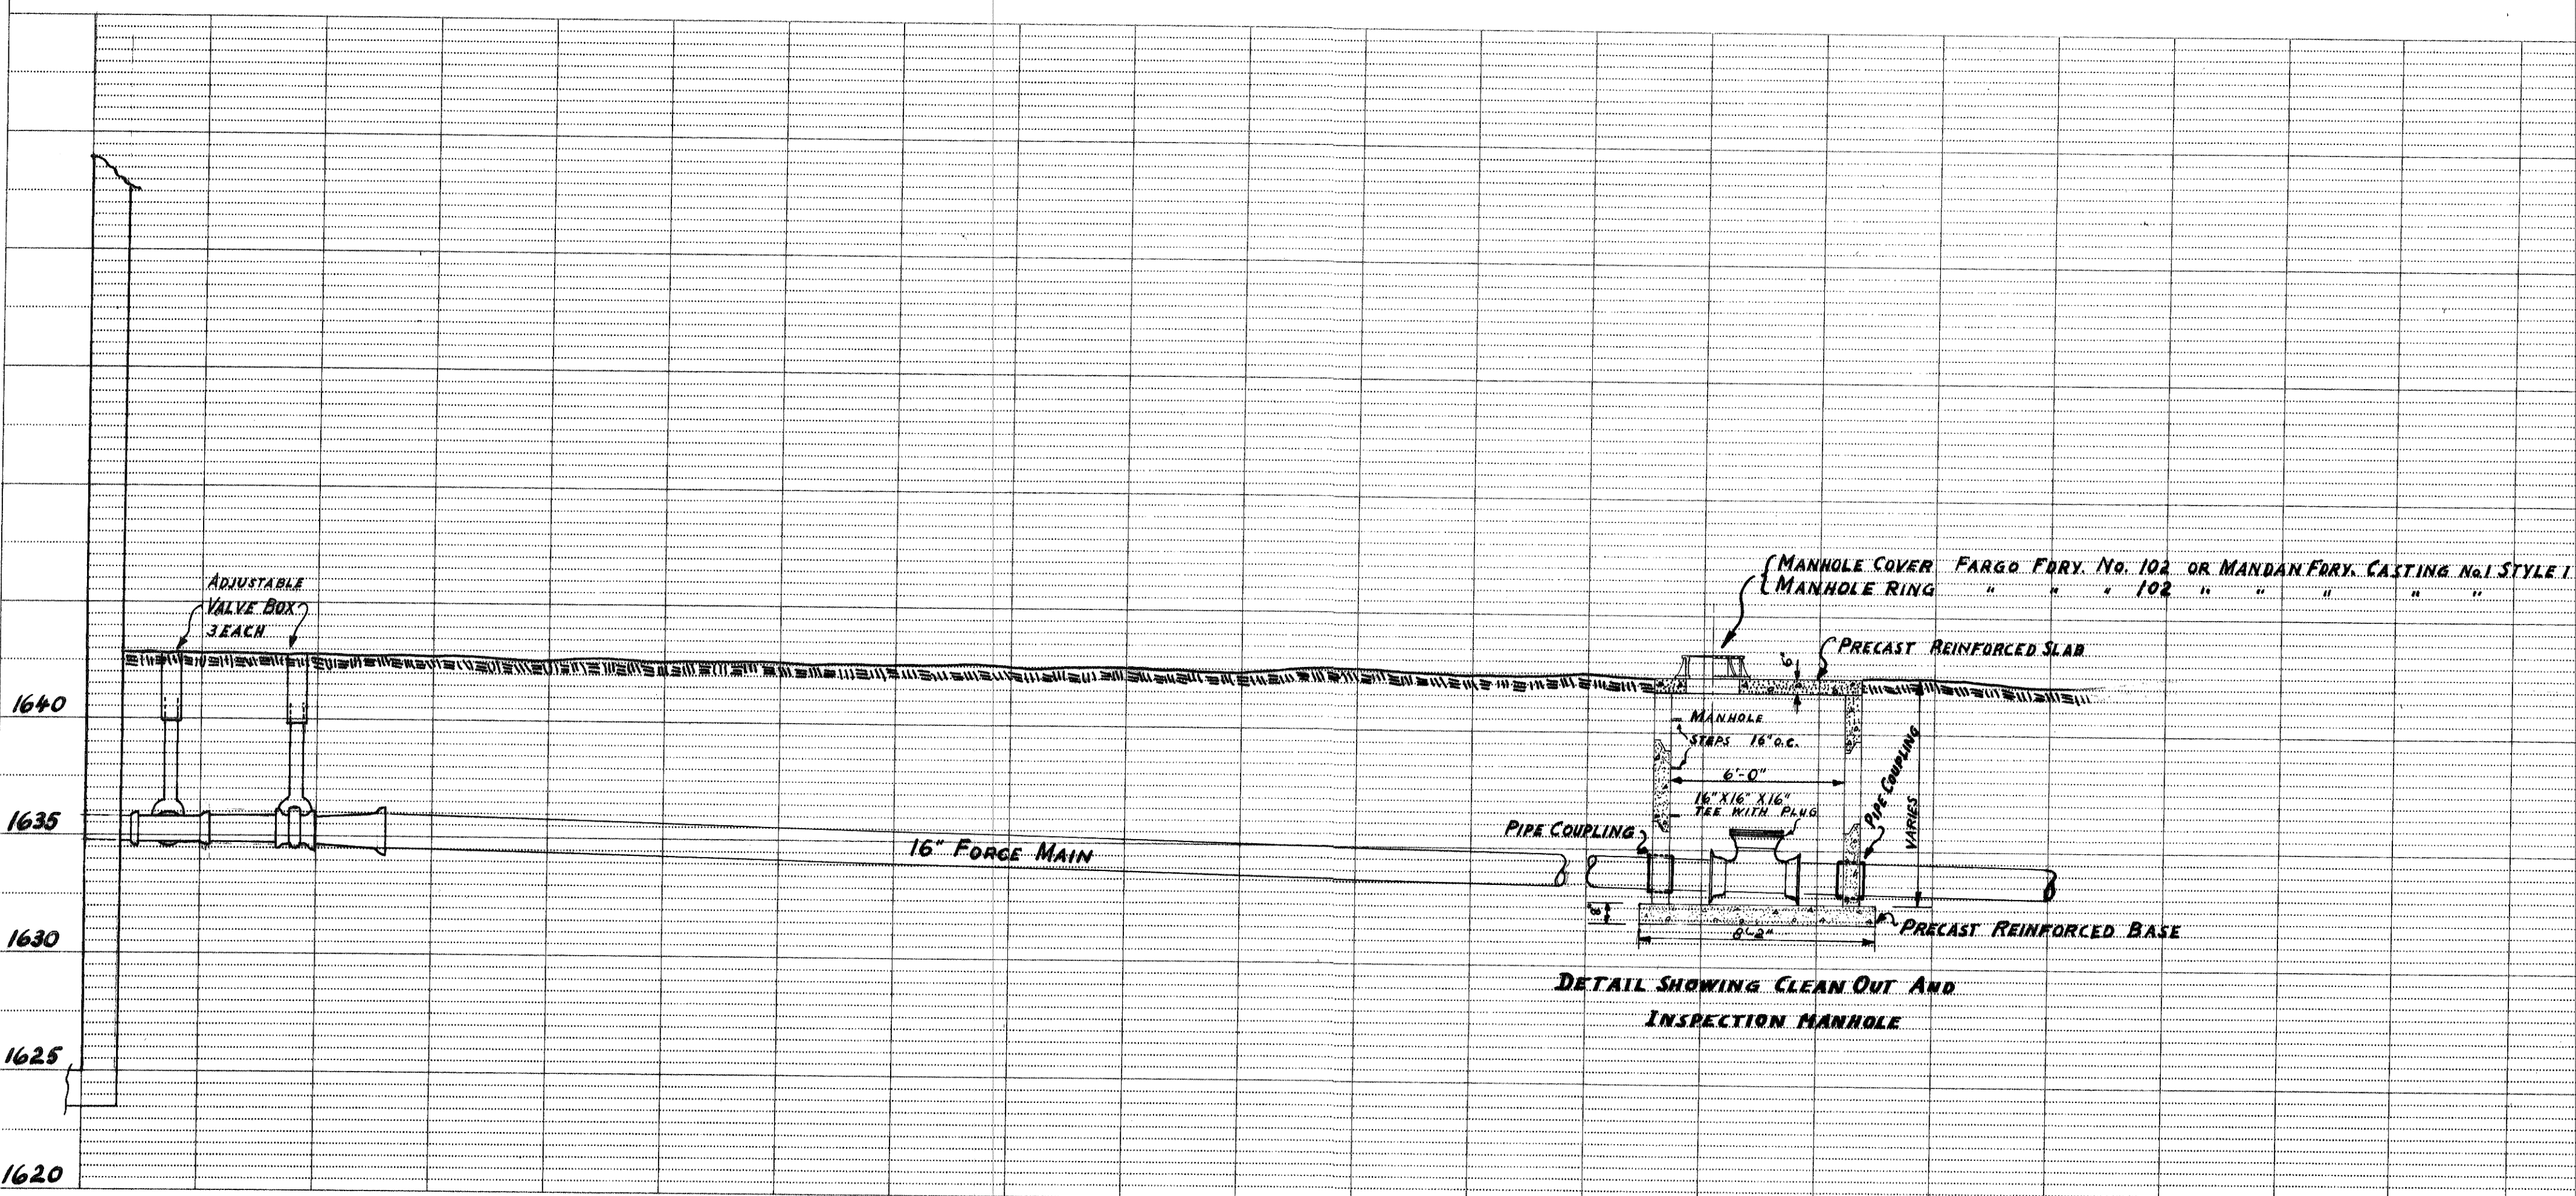
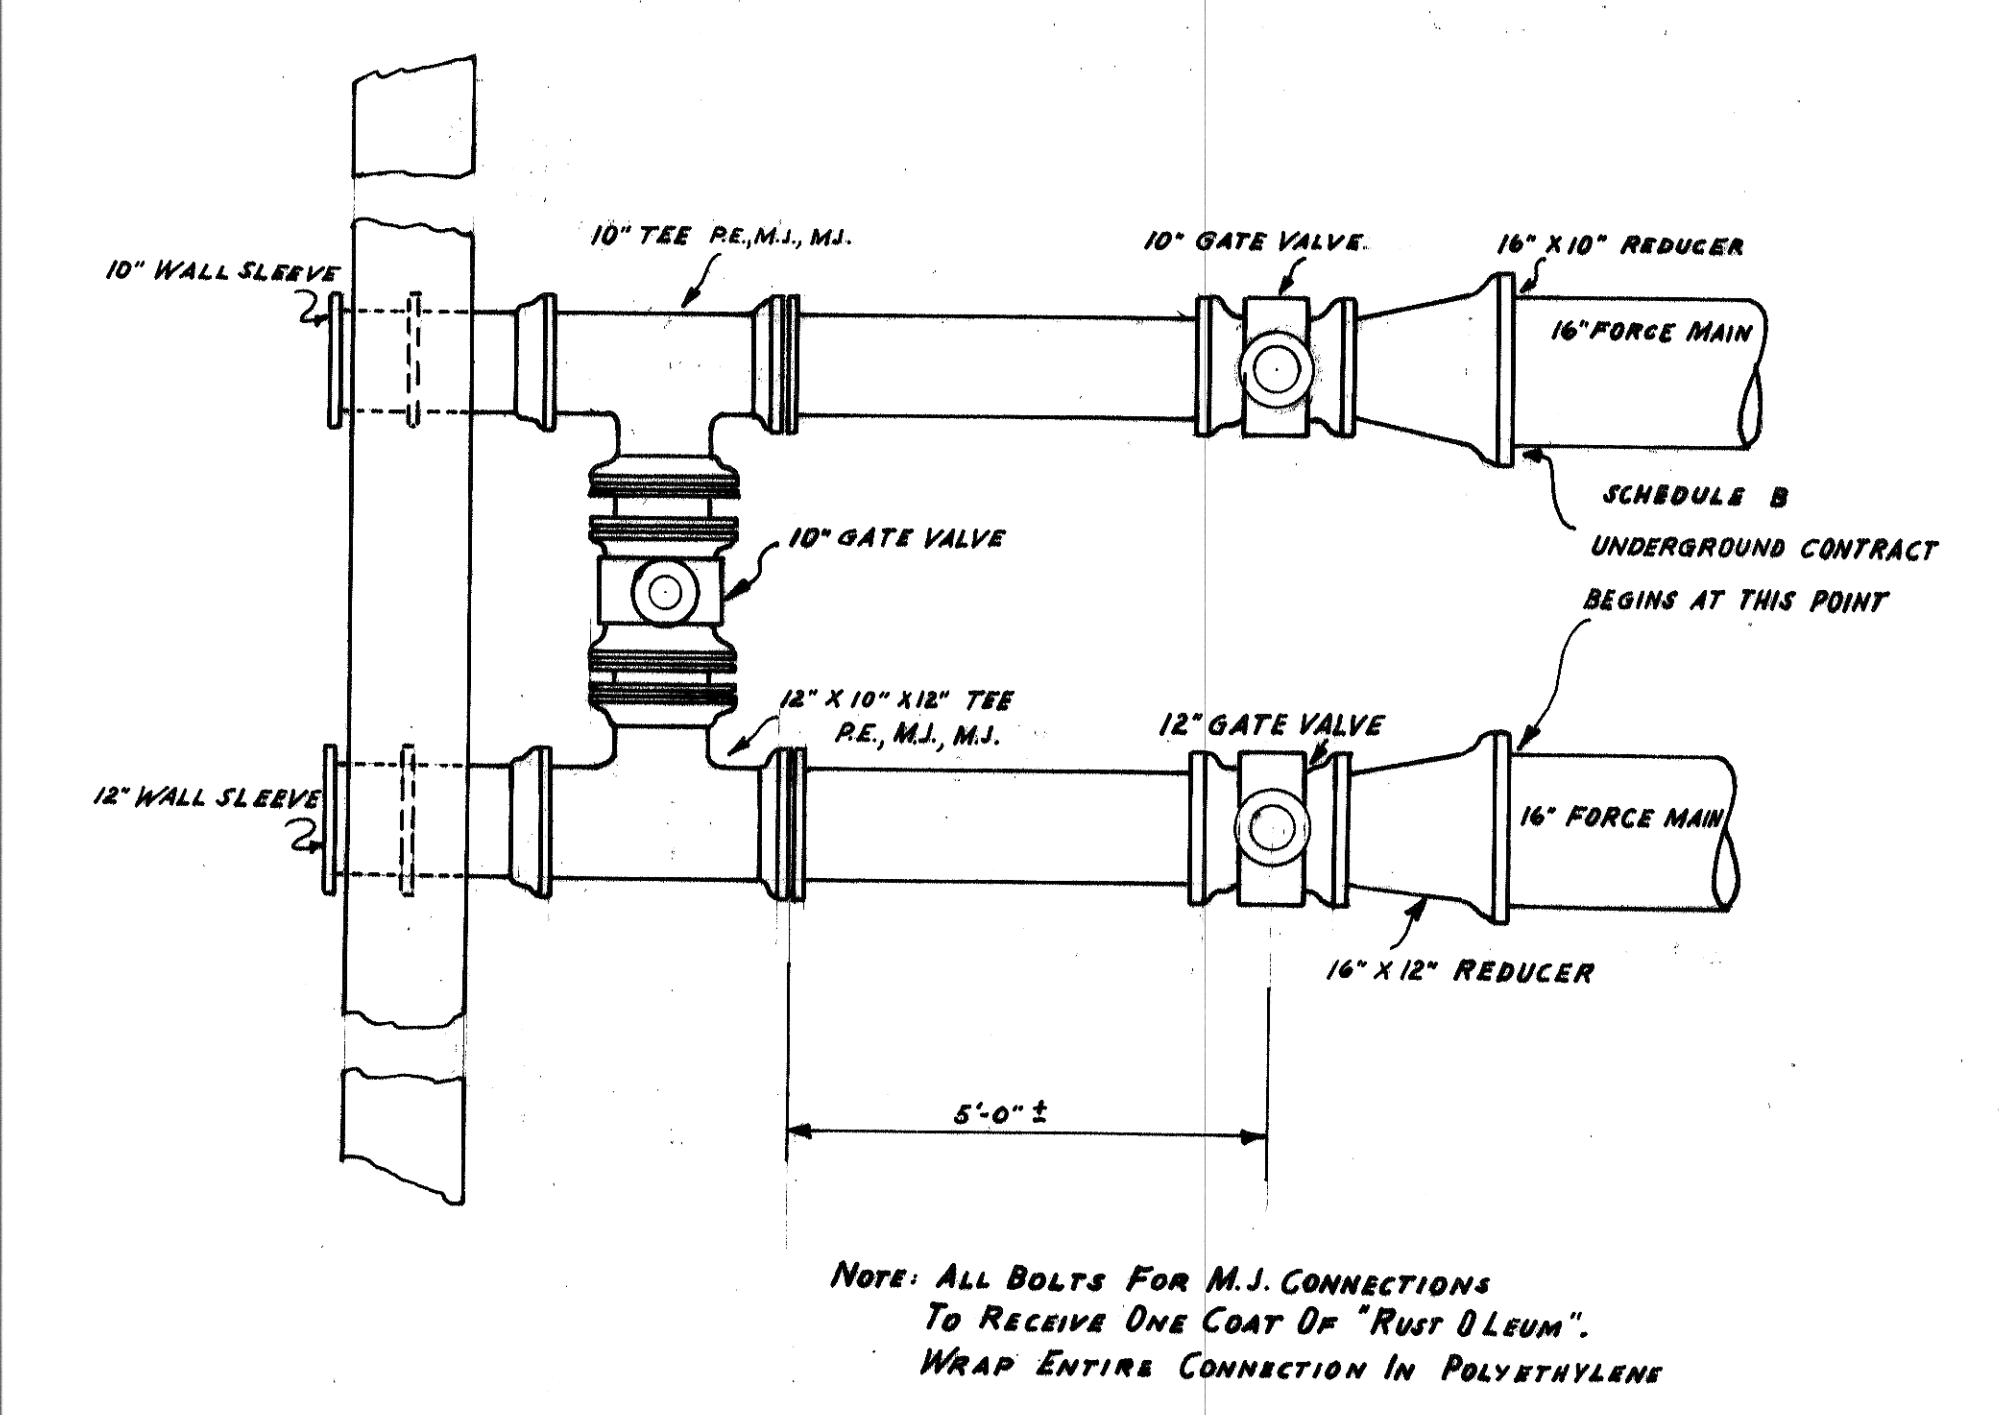


FED. ROAD DIST. NO.	STATE	FEDERAL PROJ. NO.	FISCAL YEAR	SHEET NO.	TOTAL SHEETS

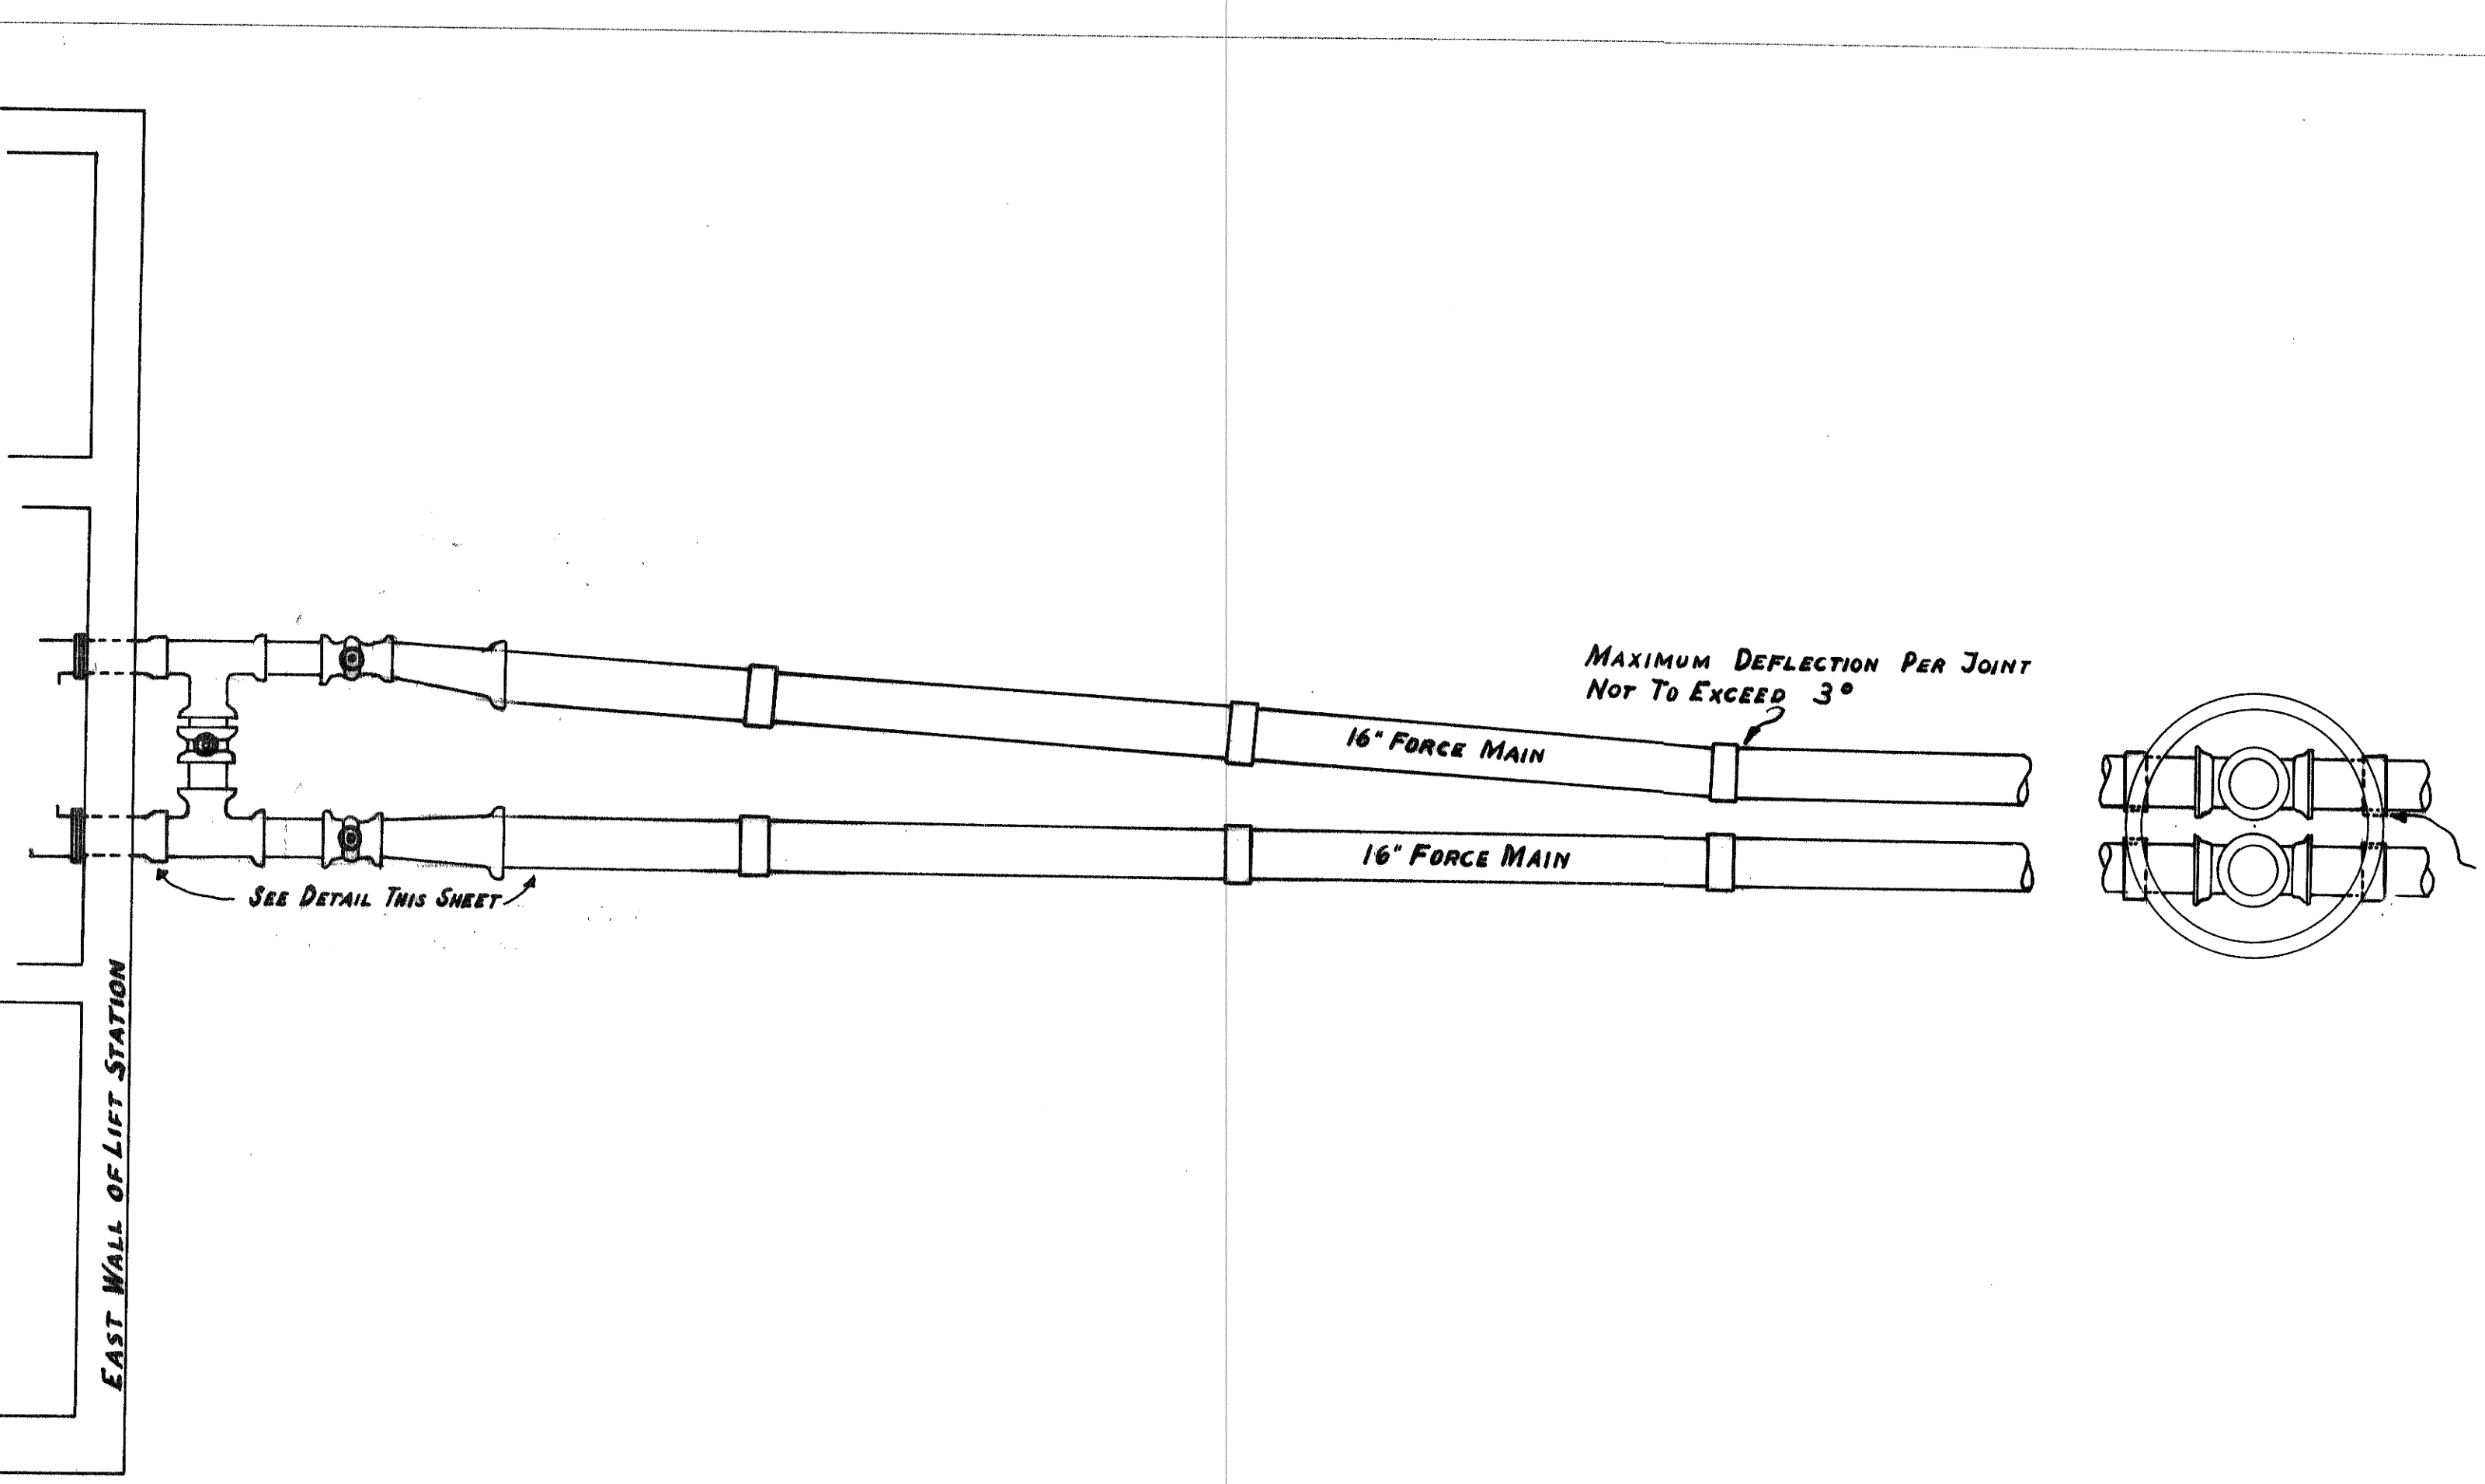

DETAIL SHOWING INSTALLATION OF WALL PIPES
SCALE 1/2" = 1'-0"

REVISED
Date: 9-15-1966
DESTROY
PREVIOUS PRINTS
GEORGE J. TOMAN
Consulting Engineer