

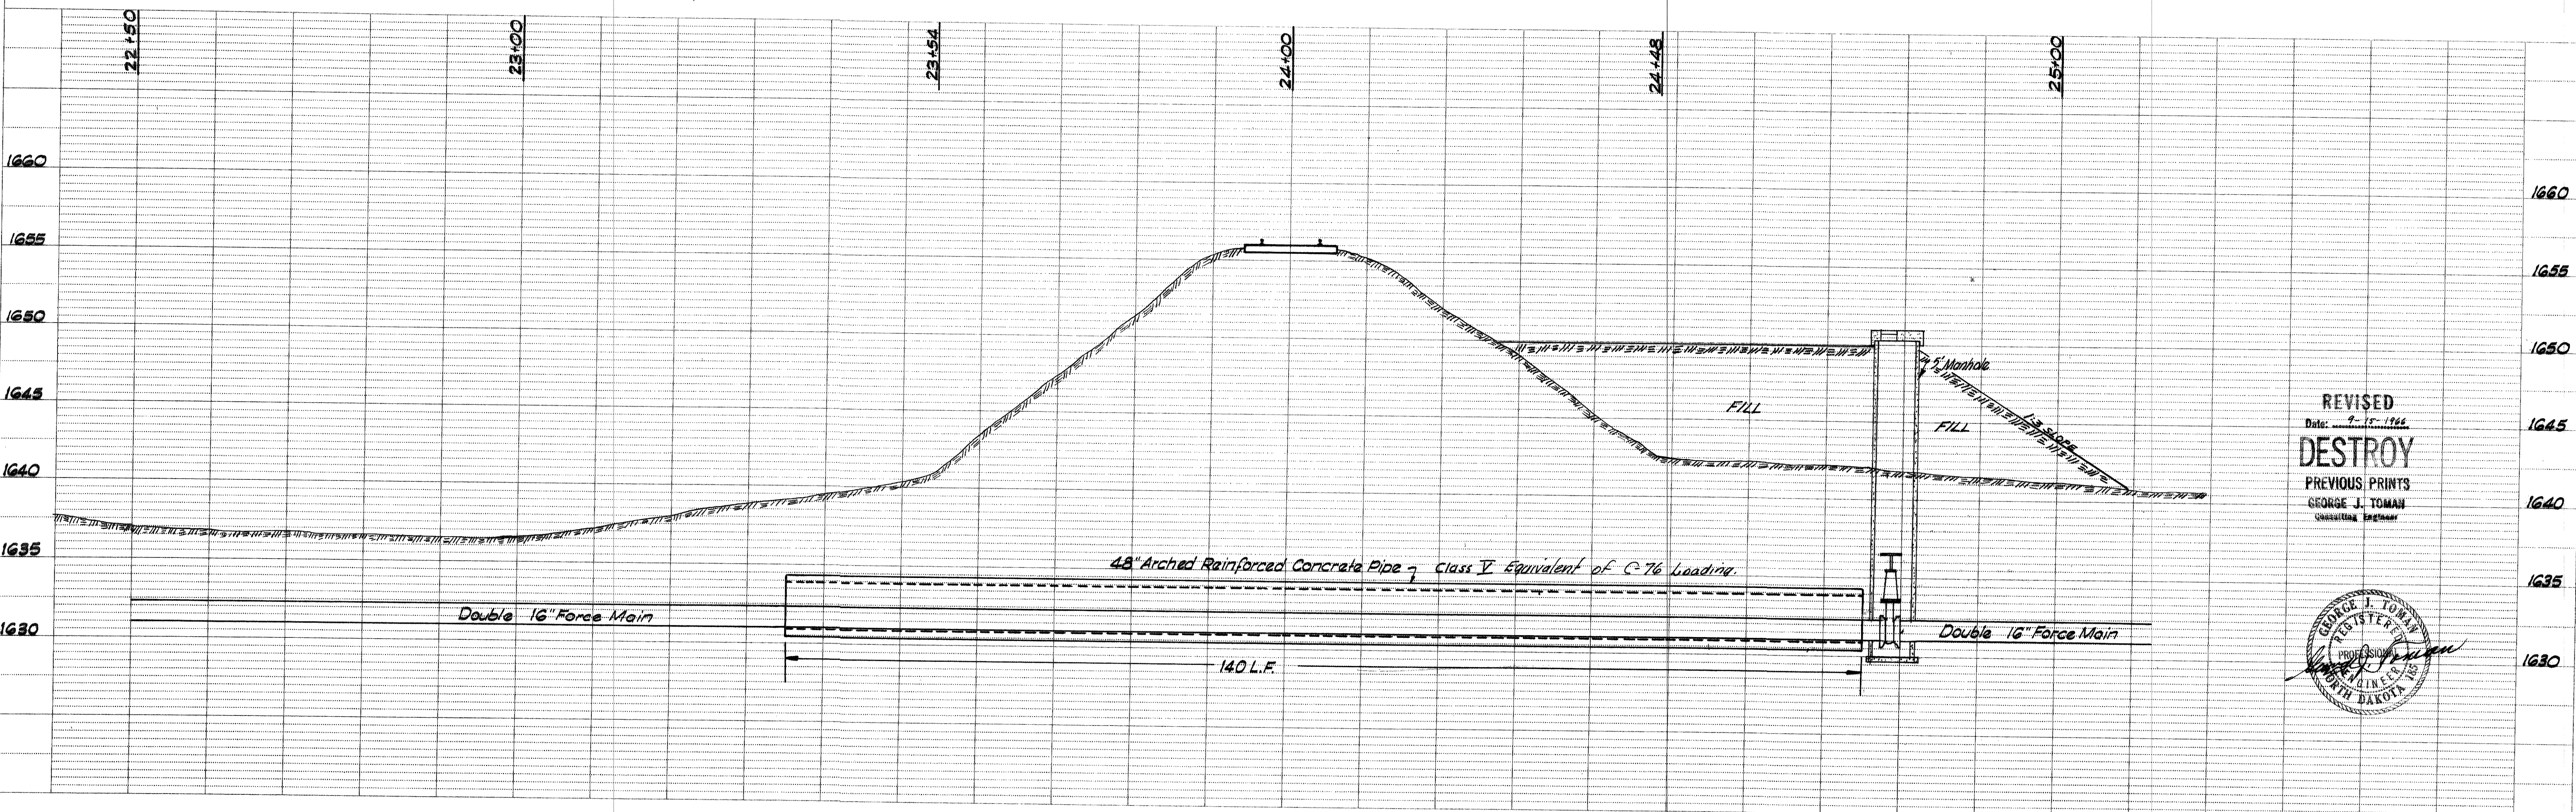


FED. ROAD DIST. NO.	STATE	FEDERAL PROJ. NO.	FISCAL YEAR	SHEET NO.	TOTAL SHEETS
---------------------	-------	-------------------	-------------	-----------	--------------

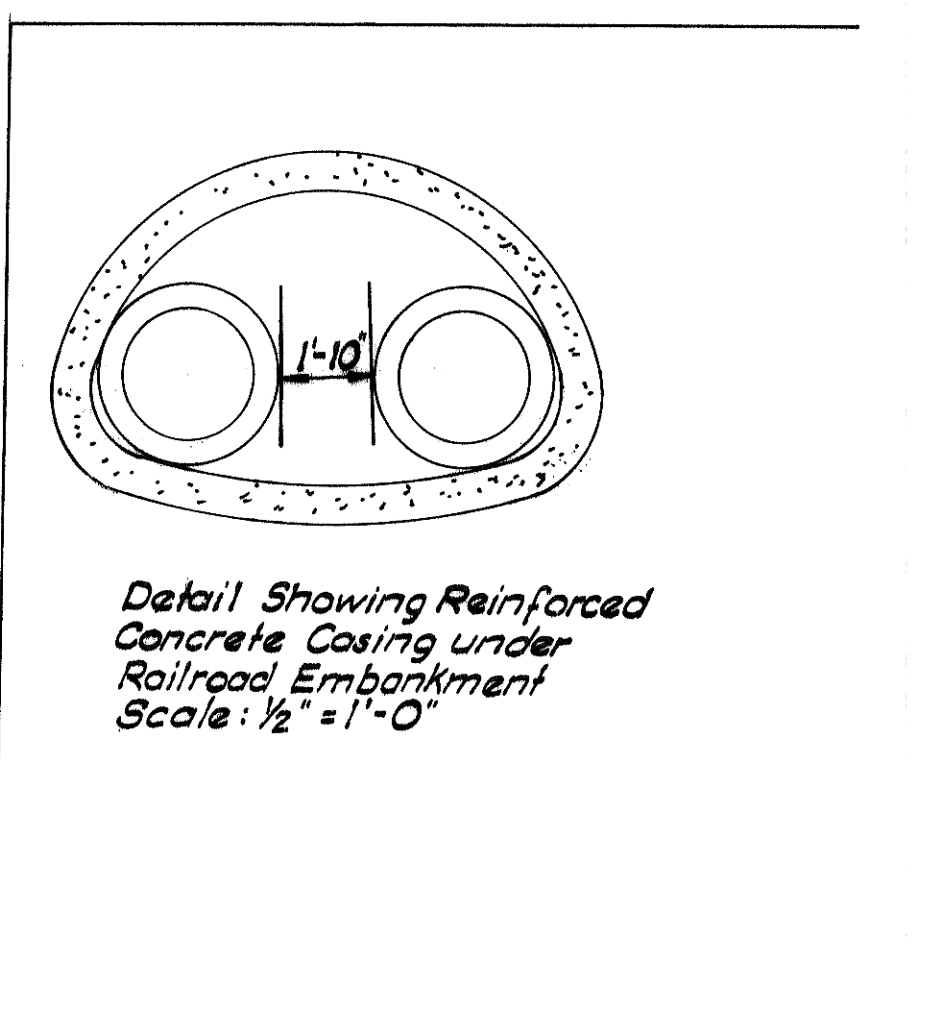

REVISED
Date: 9-15-1966
DESTROY
PREVIOUS PRINTS
GEORGE J. TOMAN
Consulting Engineer

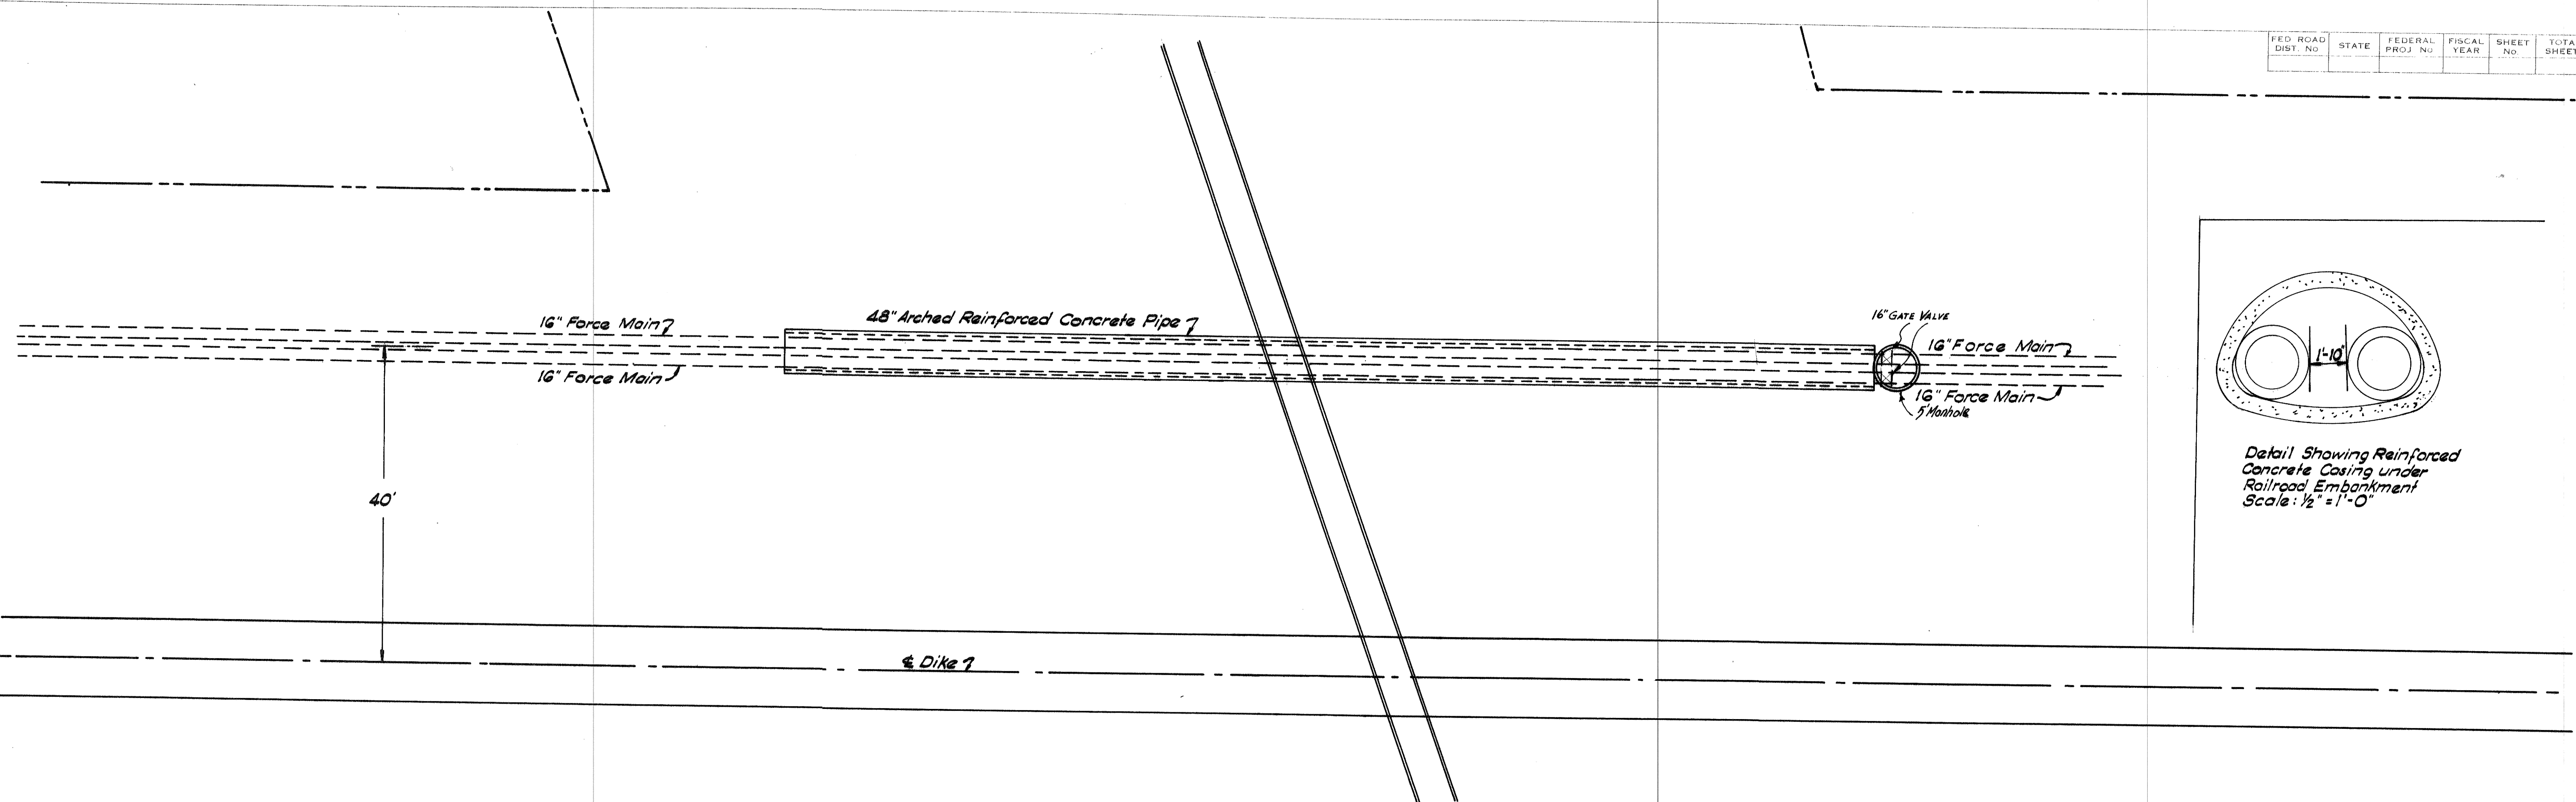