


Install concrete thrust restraining blocks behind bends in accordance with pipe manufacturer's directions & instructions for 100 psi pressure plus test pressure
 Estimate Total of 1 C.Y. of Concrete

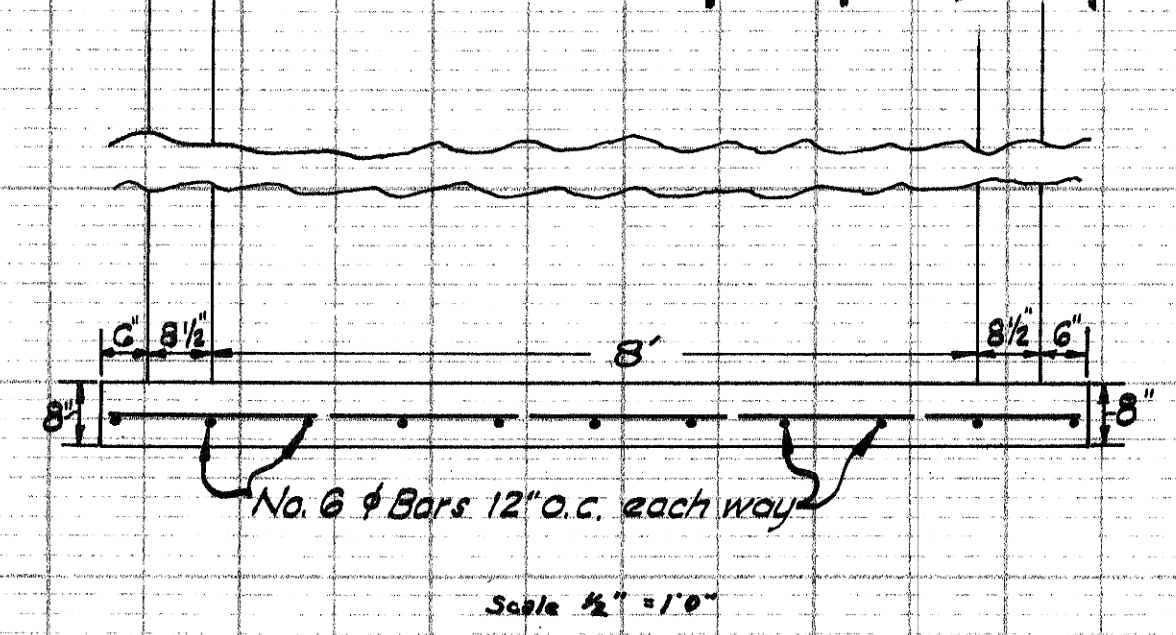

REVISED
 Date: 9/16/66
DESTROY
 PREVIOUS PRINTS
 GEORGE J. TOMIAN
 CONSULTING ENGINEER