

PLATE 1

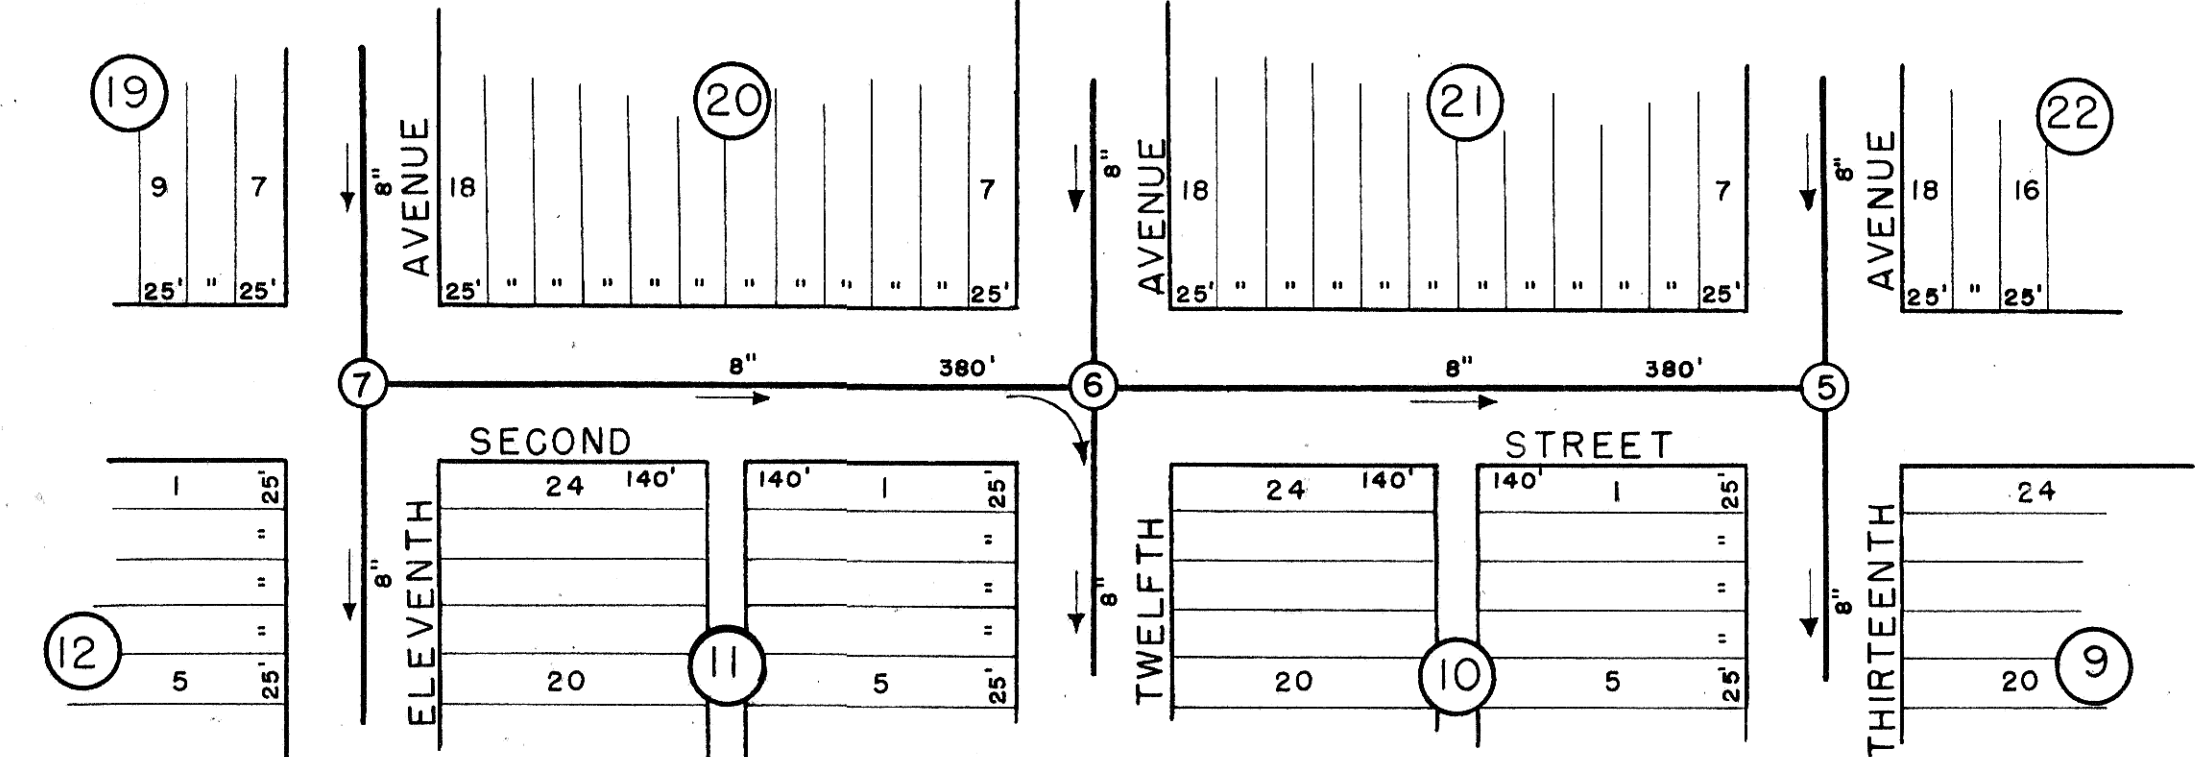


PLATE 2




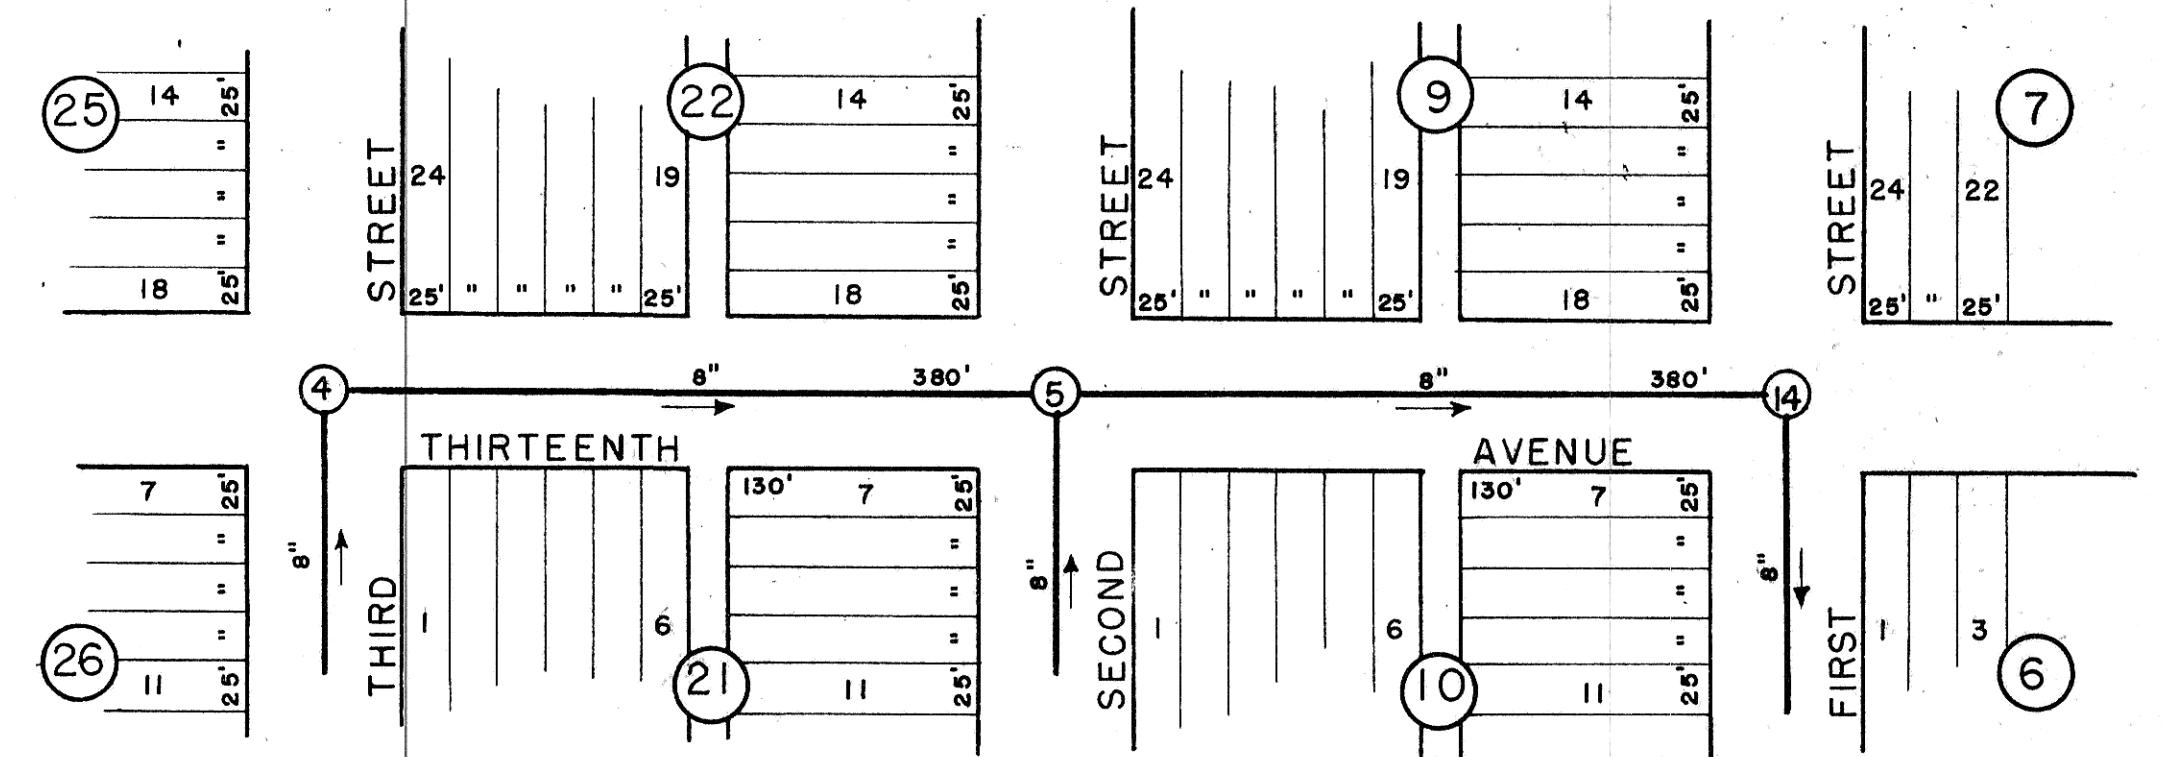


PLATE 3

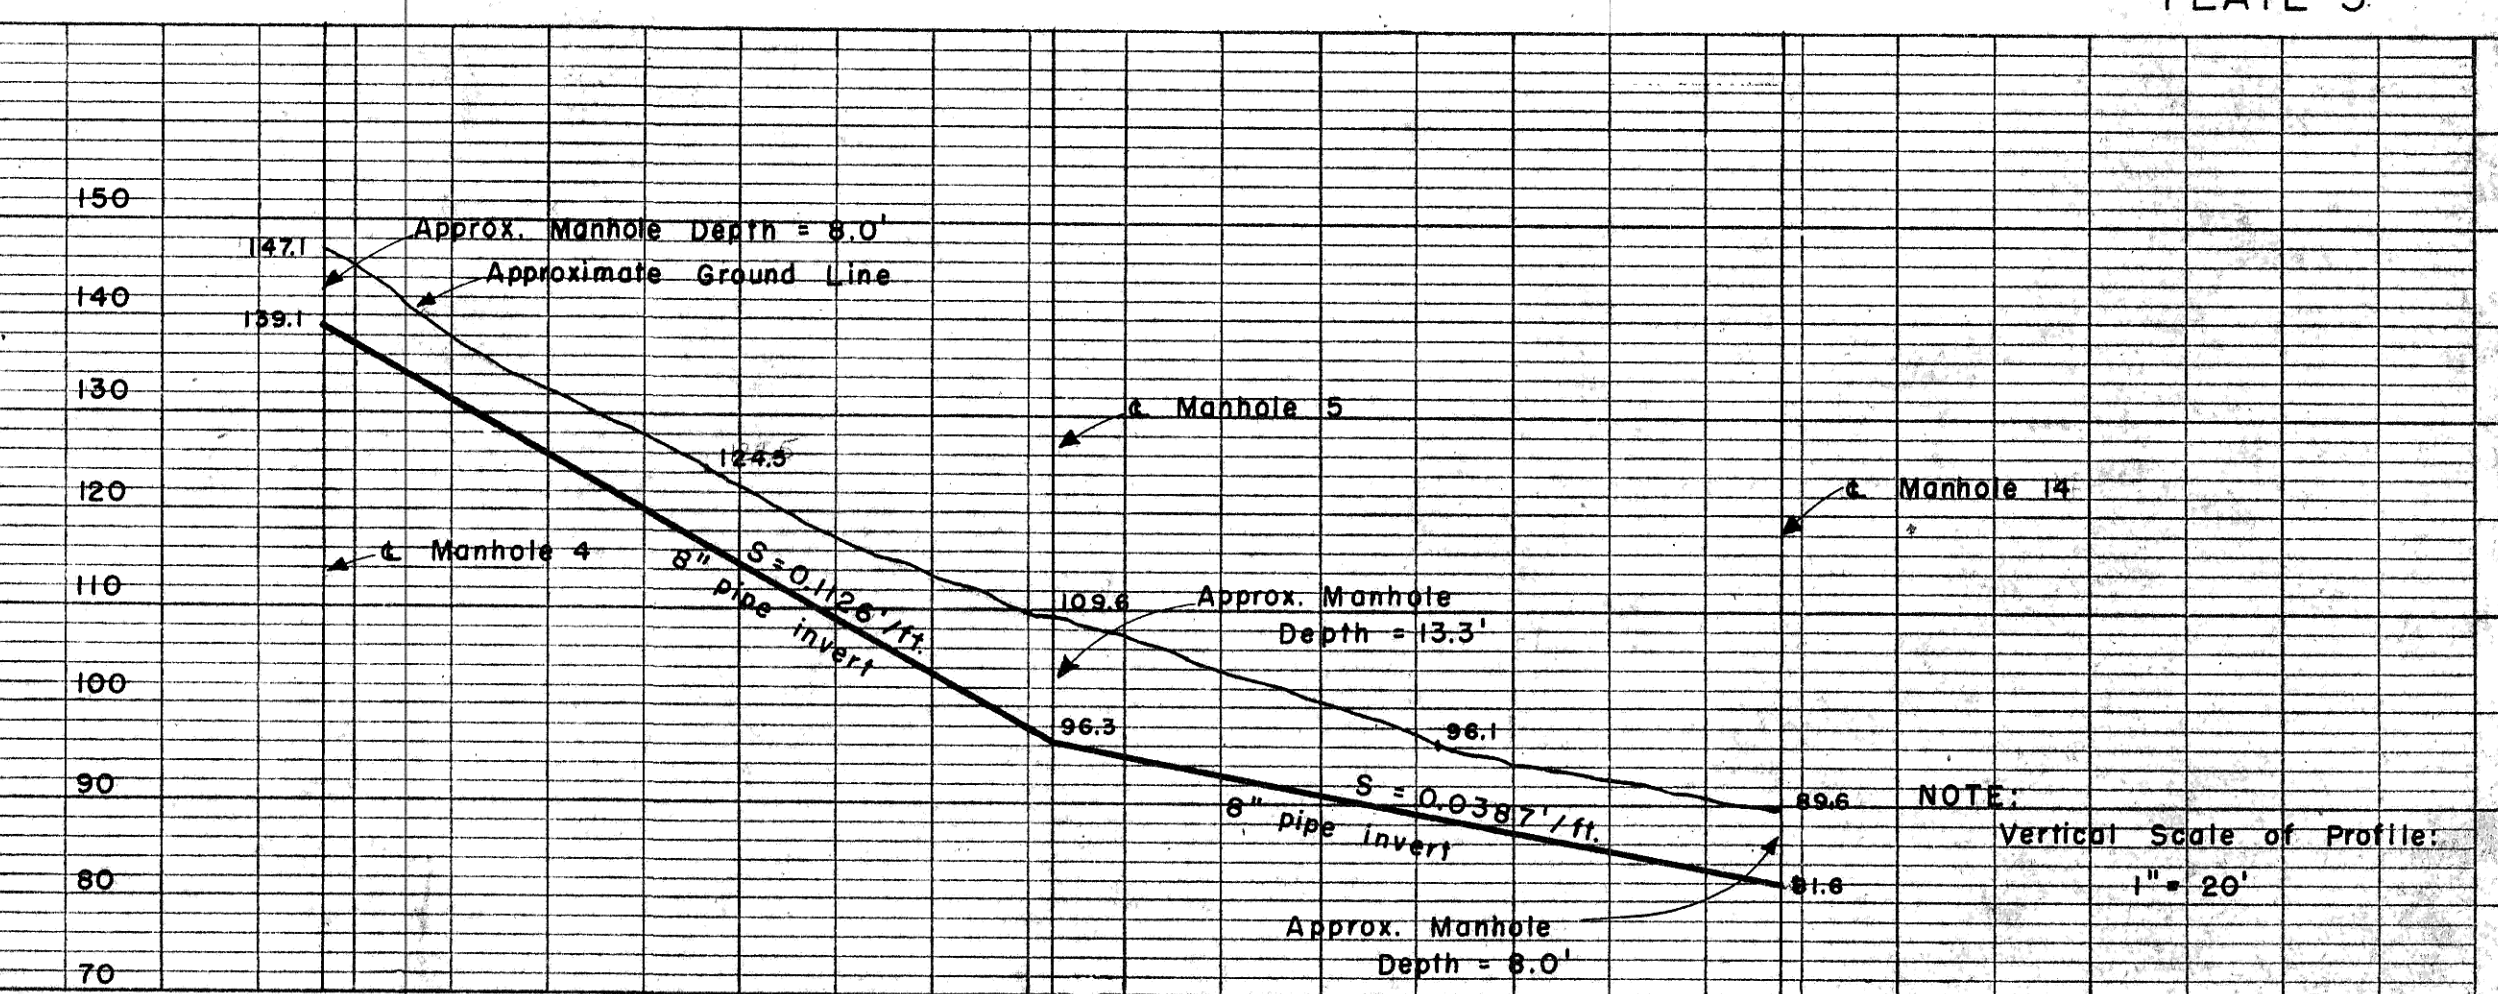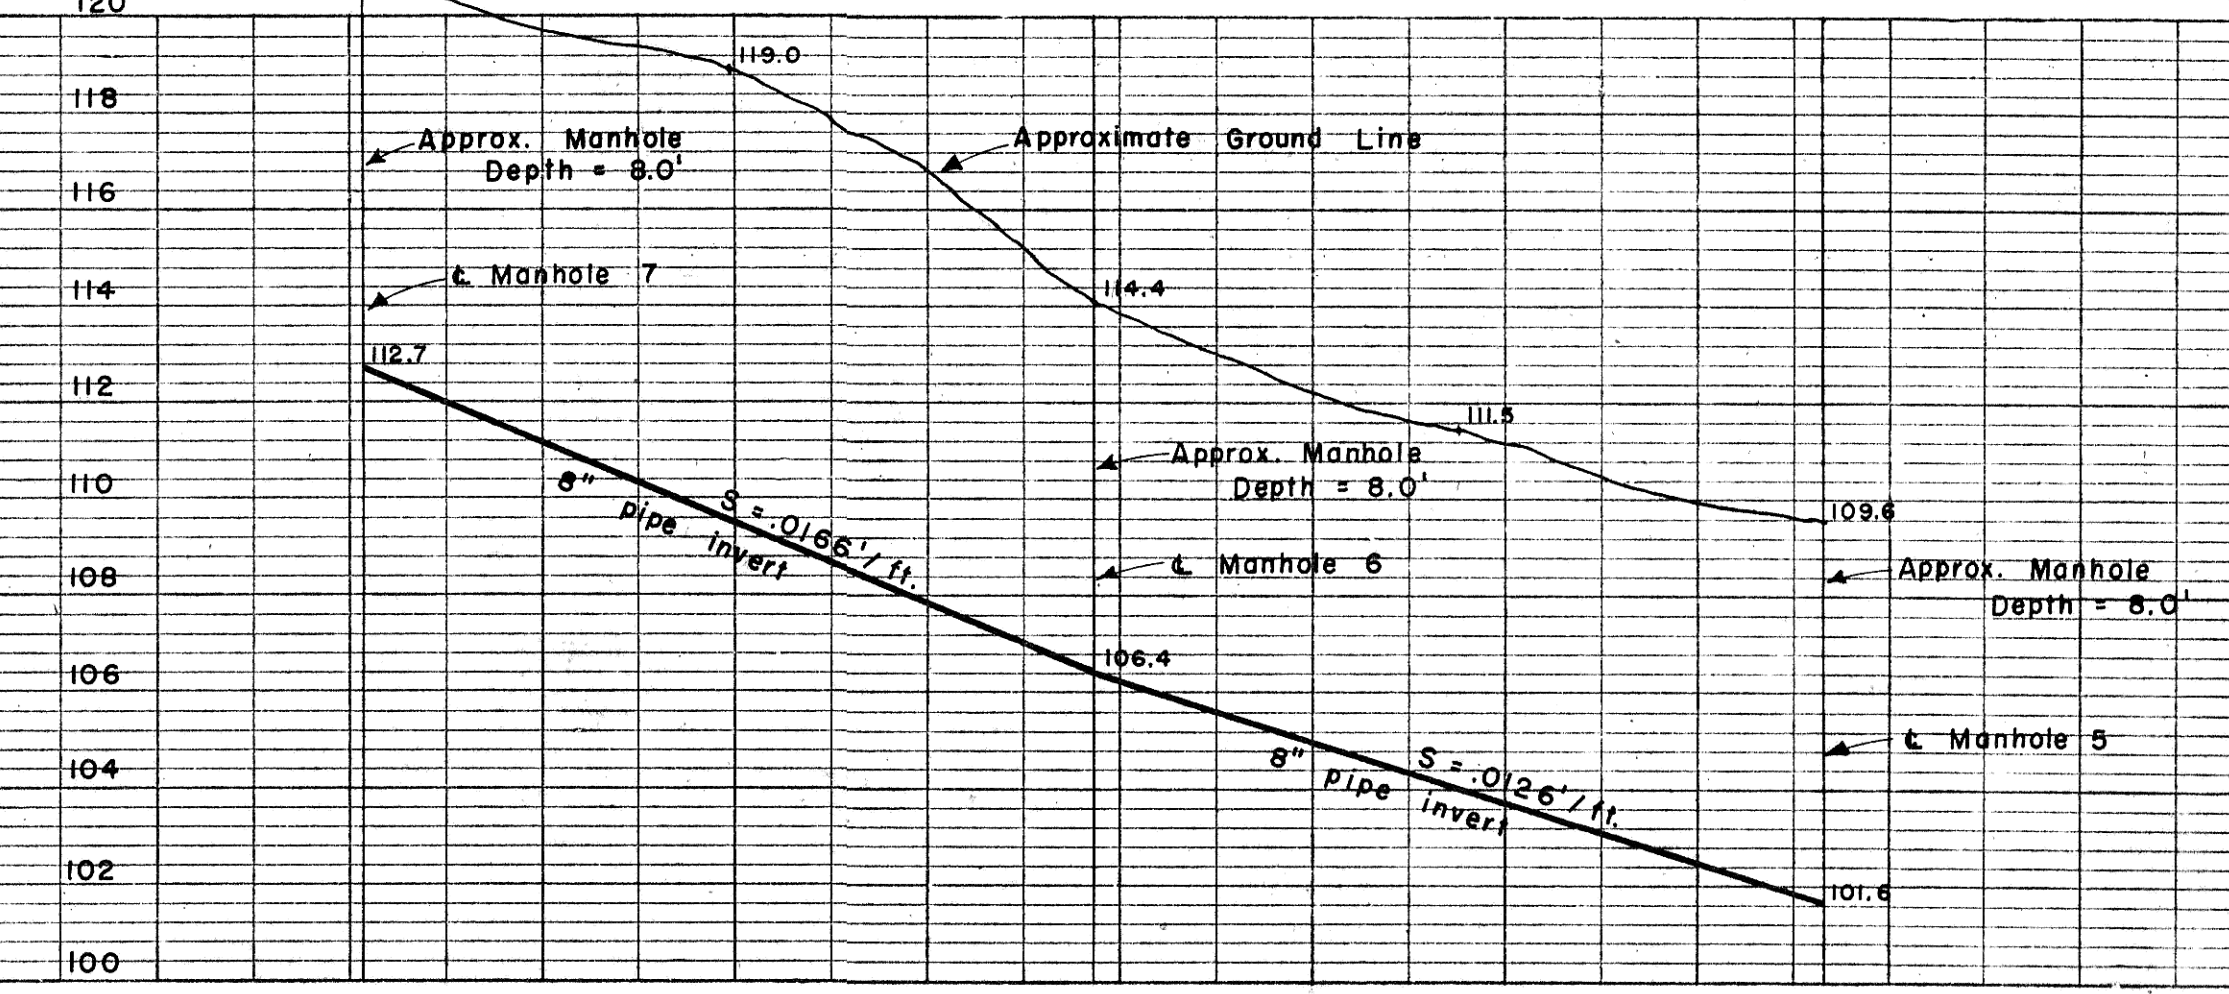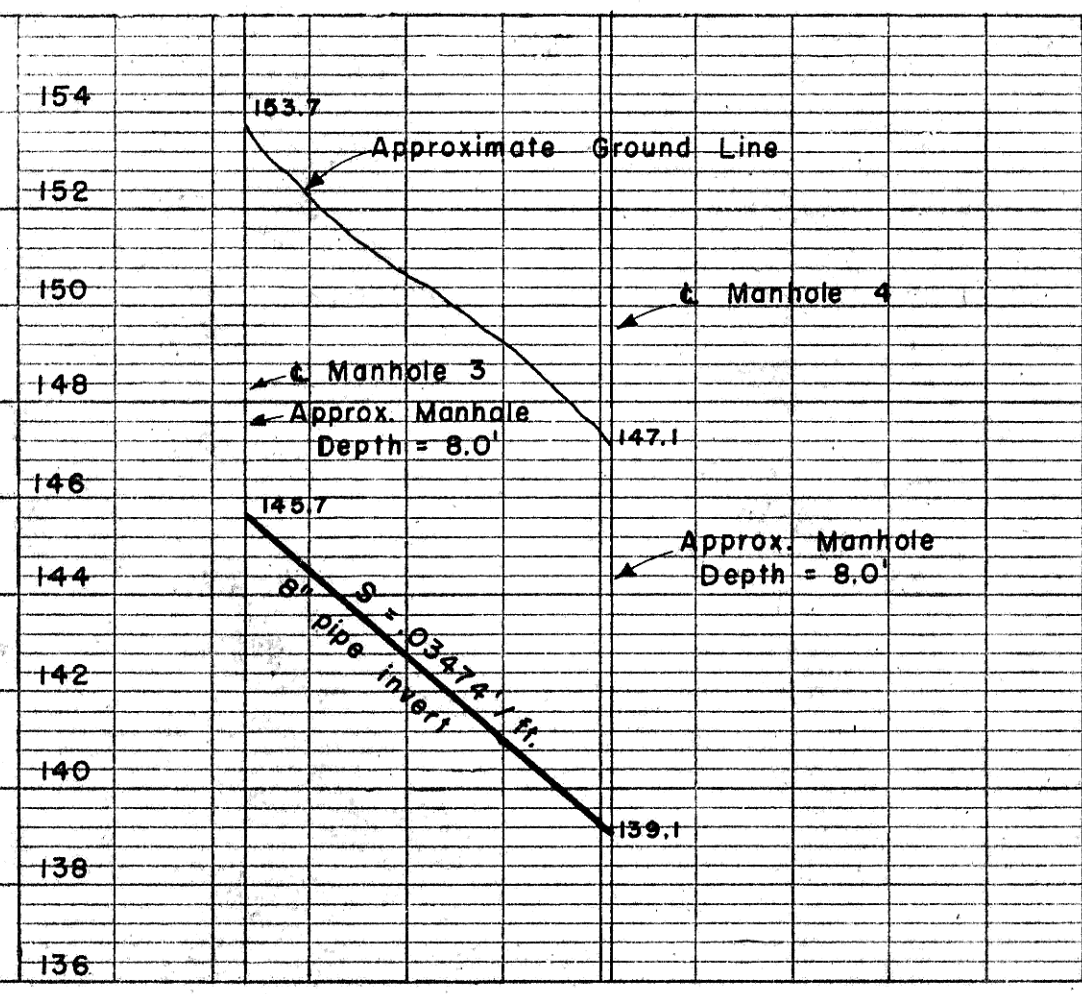

NOTE: Vertical Scale of Profile: 1" = 20'

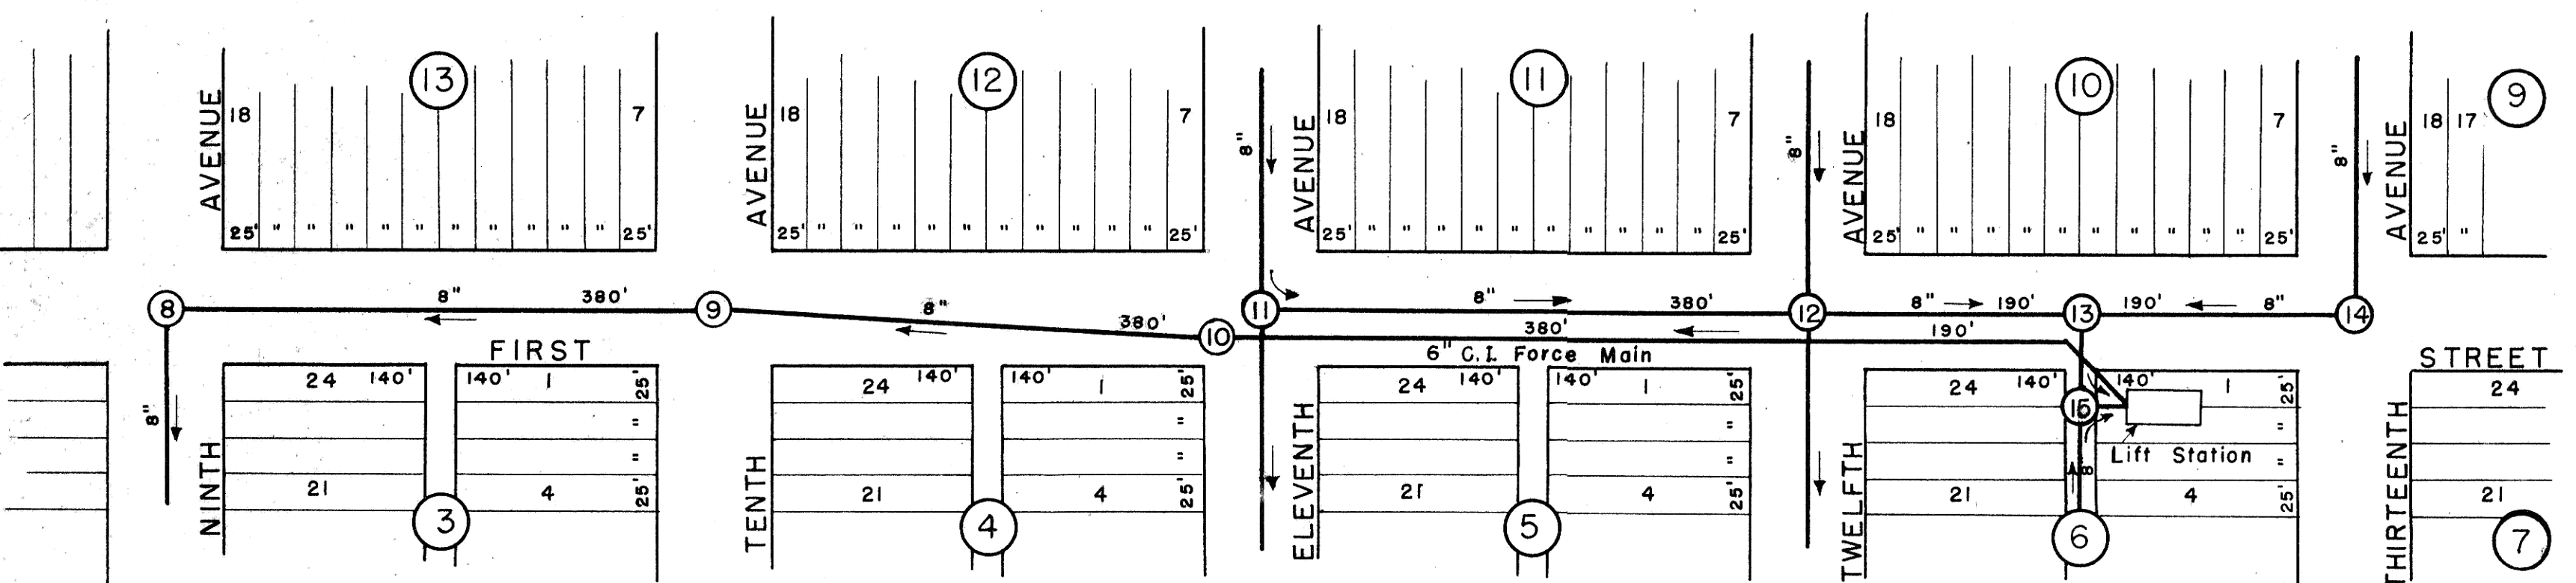


PLATE 4



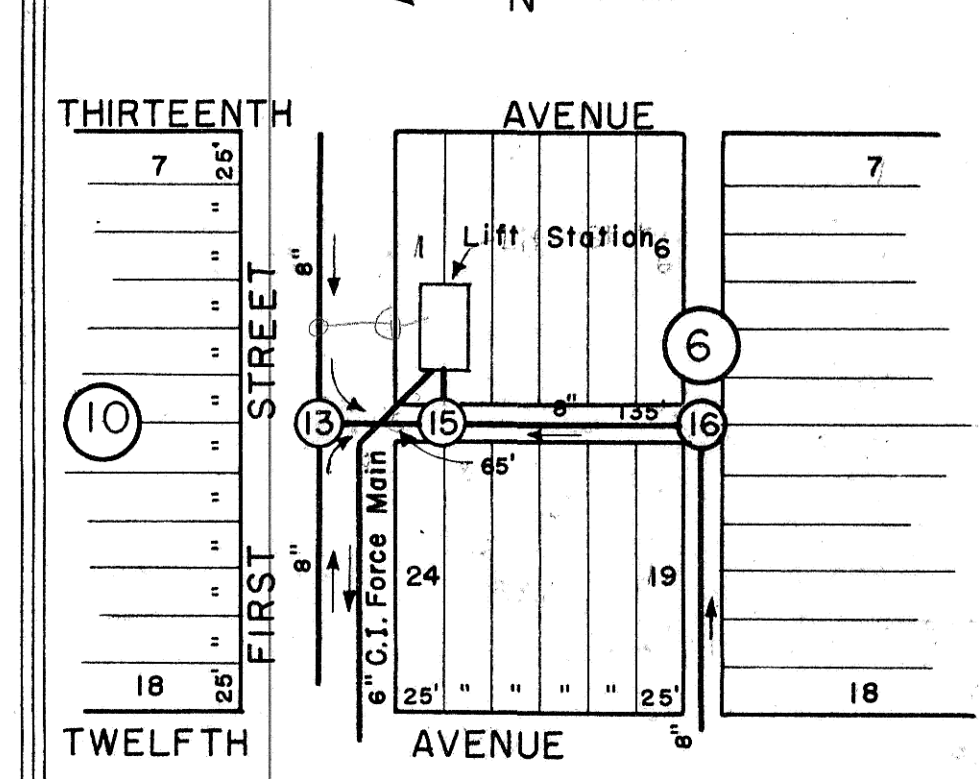


PLATE 5

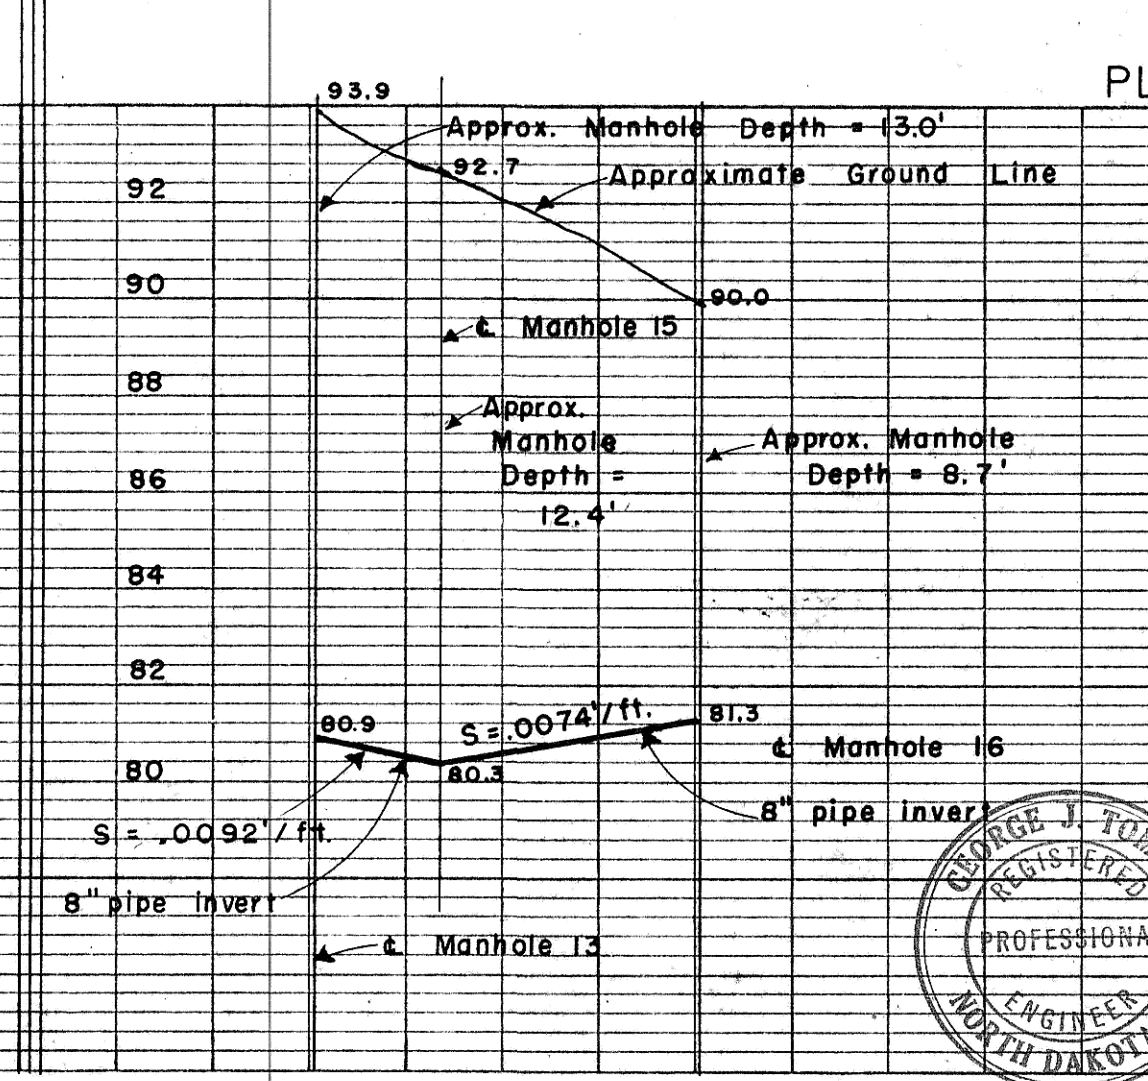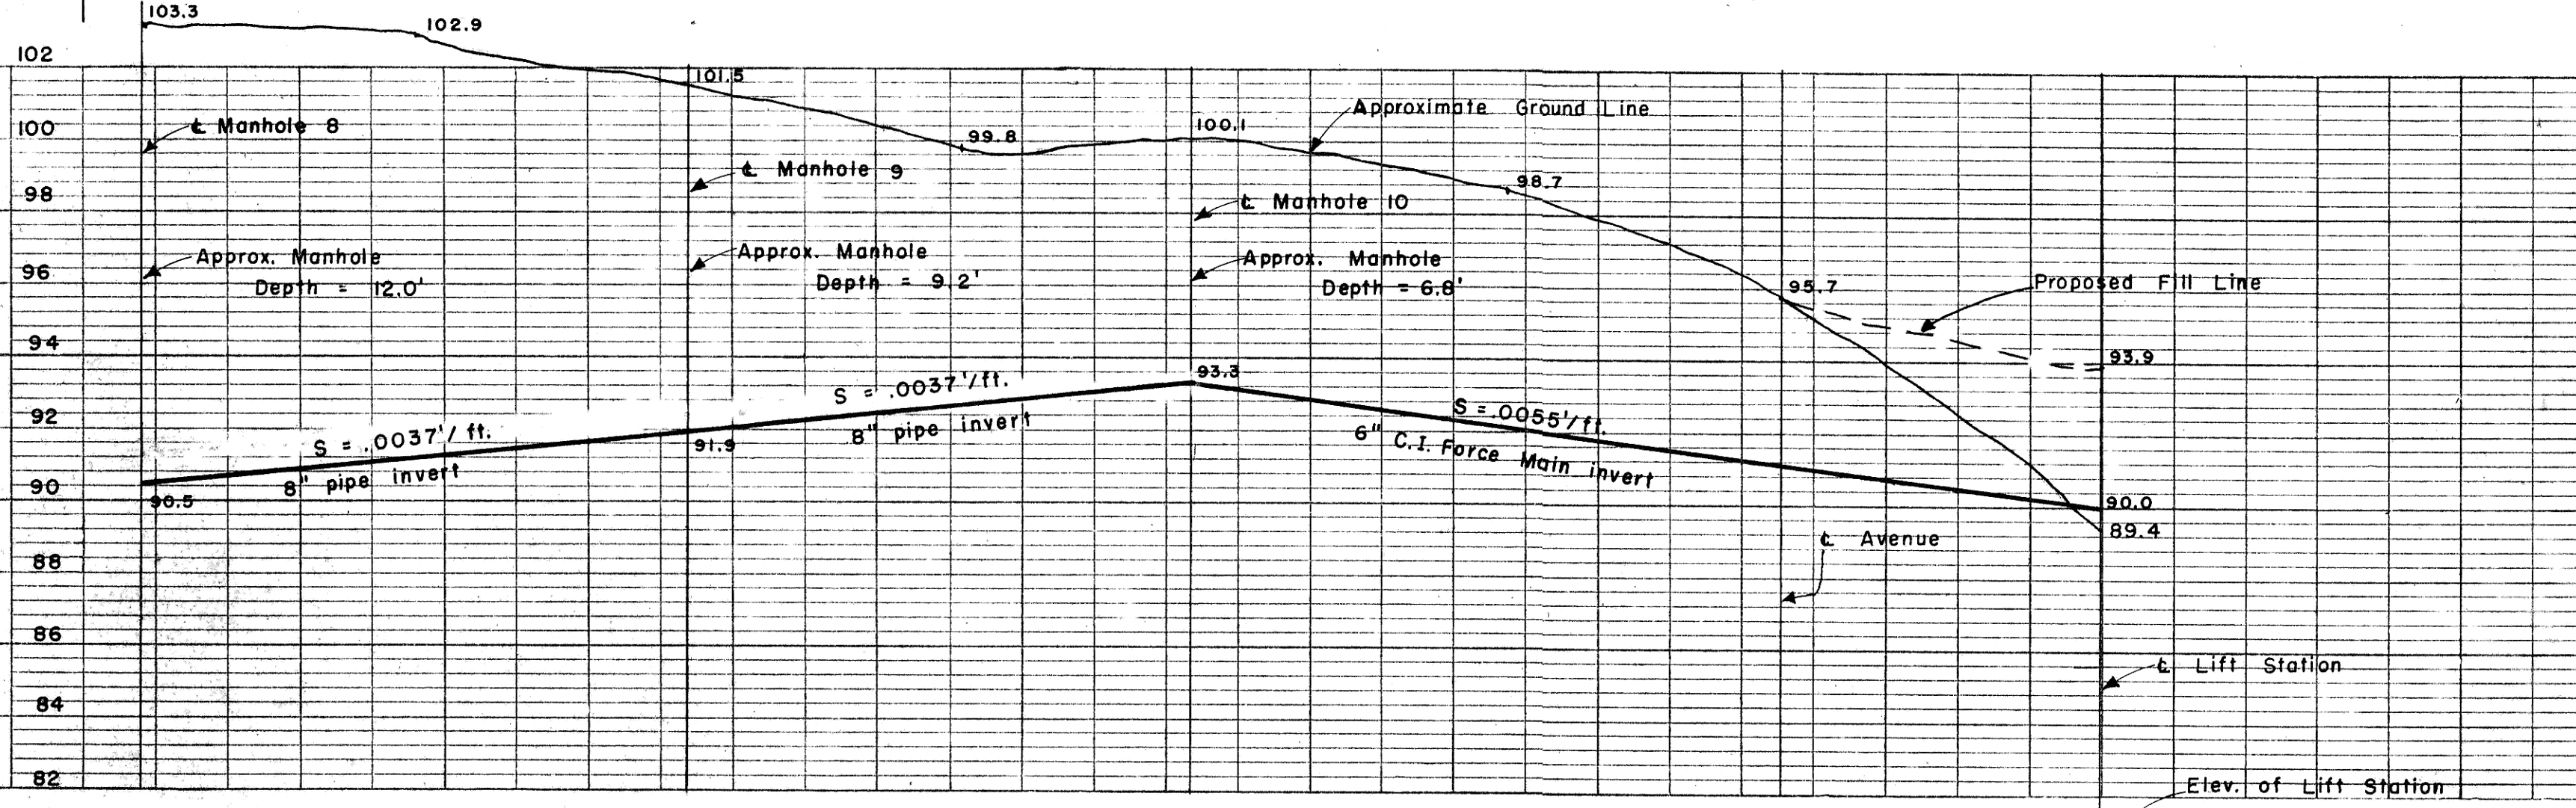

MANDAN, NORTH DAKOTA
SANITARY SEWER DISTRICT NO. 8
SANITARY SEWER DETAILS

SCALE: 1" = 100'

Drawn by: RYI
Checked by: LJT
George J. Toman
Consulting Engineer
Mandan, N. Dak.

