


FLOOR PLAN AT ELEVATION 1641.00

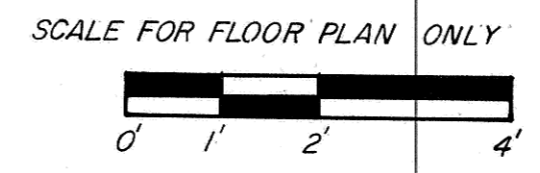

PHASE III

REV.	DATE	DESCRIPTION	BY

MANDAN INTERCEPTOR 1984
MANDAN, NORTH DAKOTA

MASTER PUMPING STATION
FLOOR PLAN AT ELEVATION 1641.00

ULTEIG ENGINEERS, INC. CONSULTING ENGINEERS • ARCHITECTS
 FARGO • BISMARCK • MINNEAPOLIS

DRAWN BY: K.M.S.	SCALE: AS SHOWN	PROJECT NO. 4241.00
CHECKED BY: <i>SR</i>	DATE: MAY 1984	SHEET A-1 of
APPROVED BY: <i>RE</i>		

Record Drawing