




1
S2
WETWELL SECTION VIEW

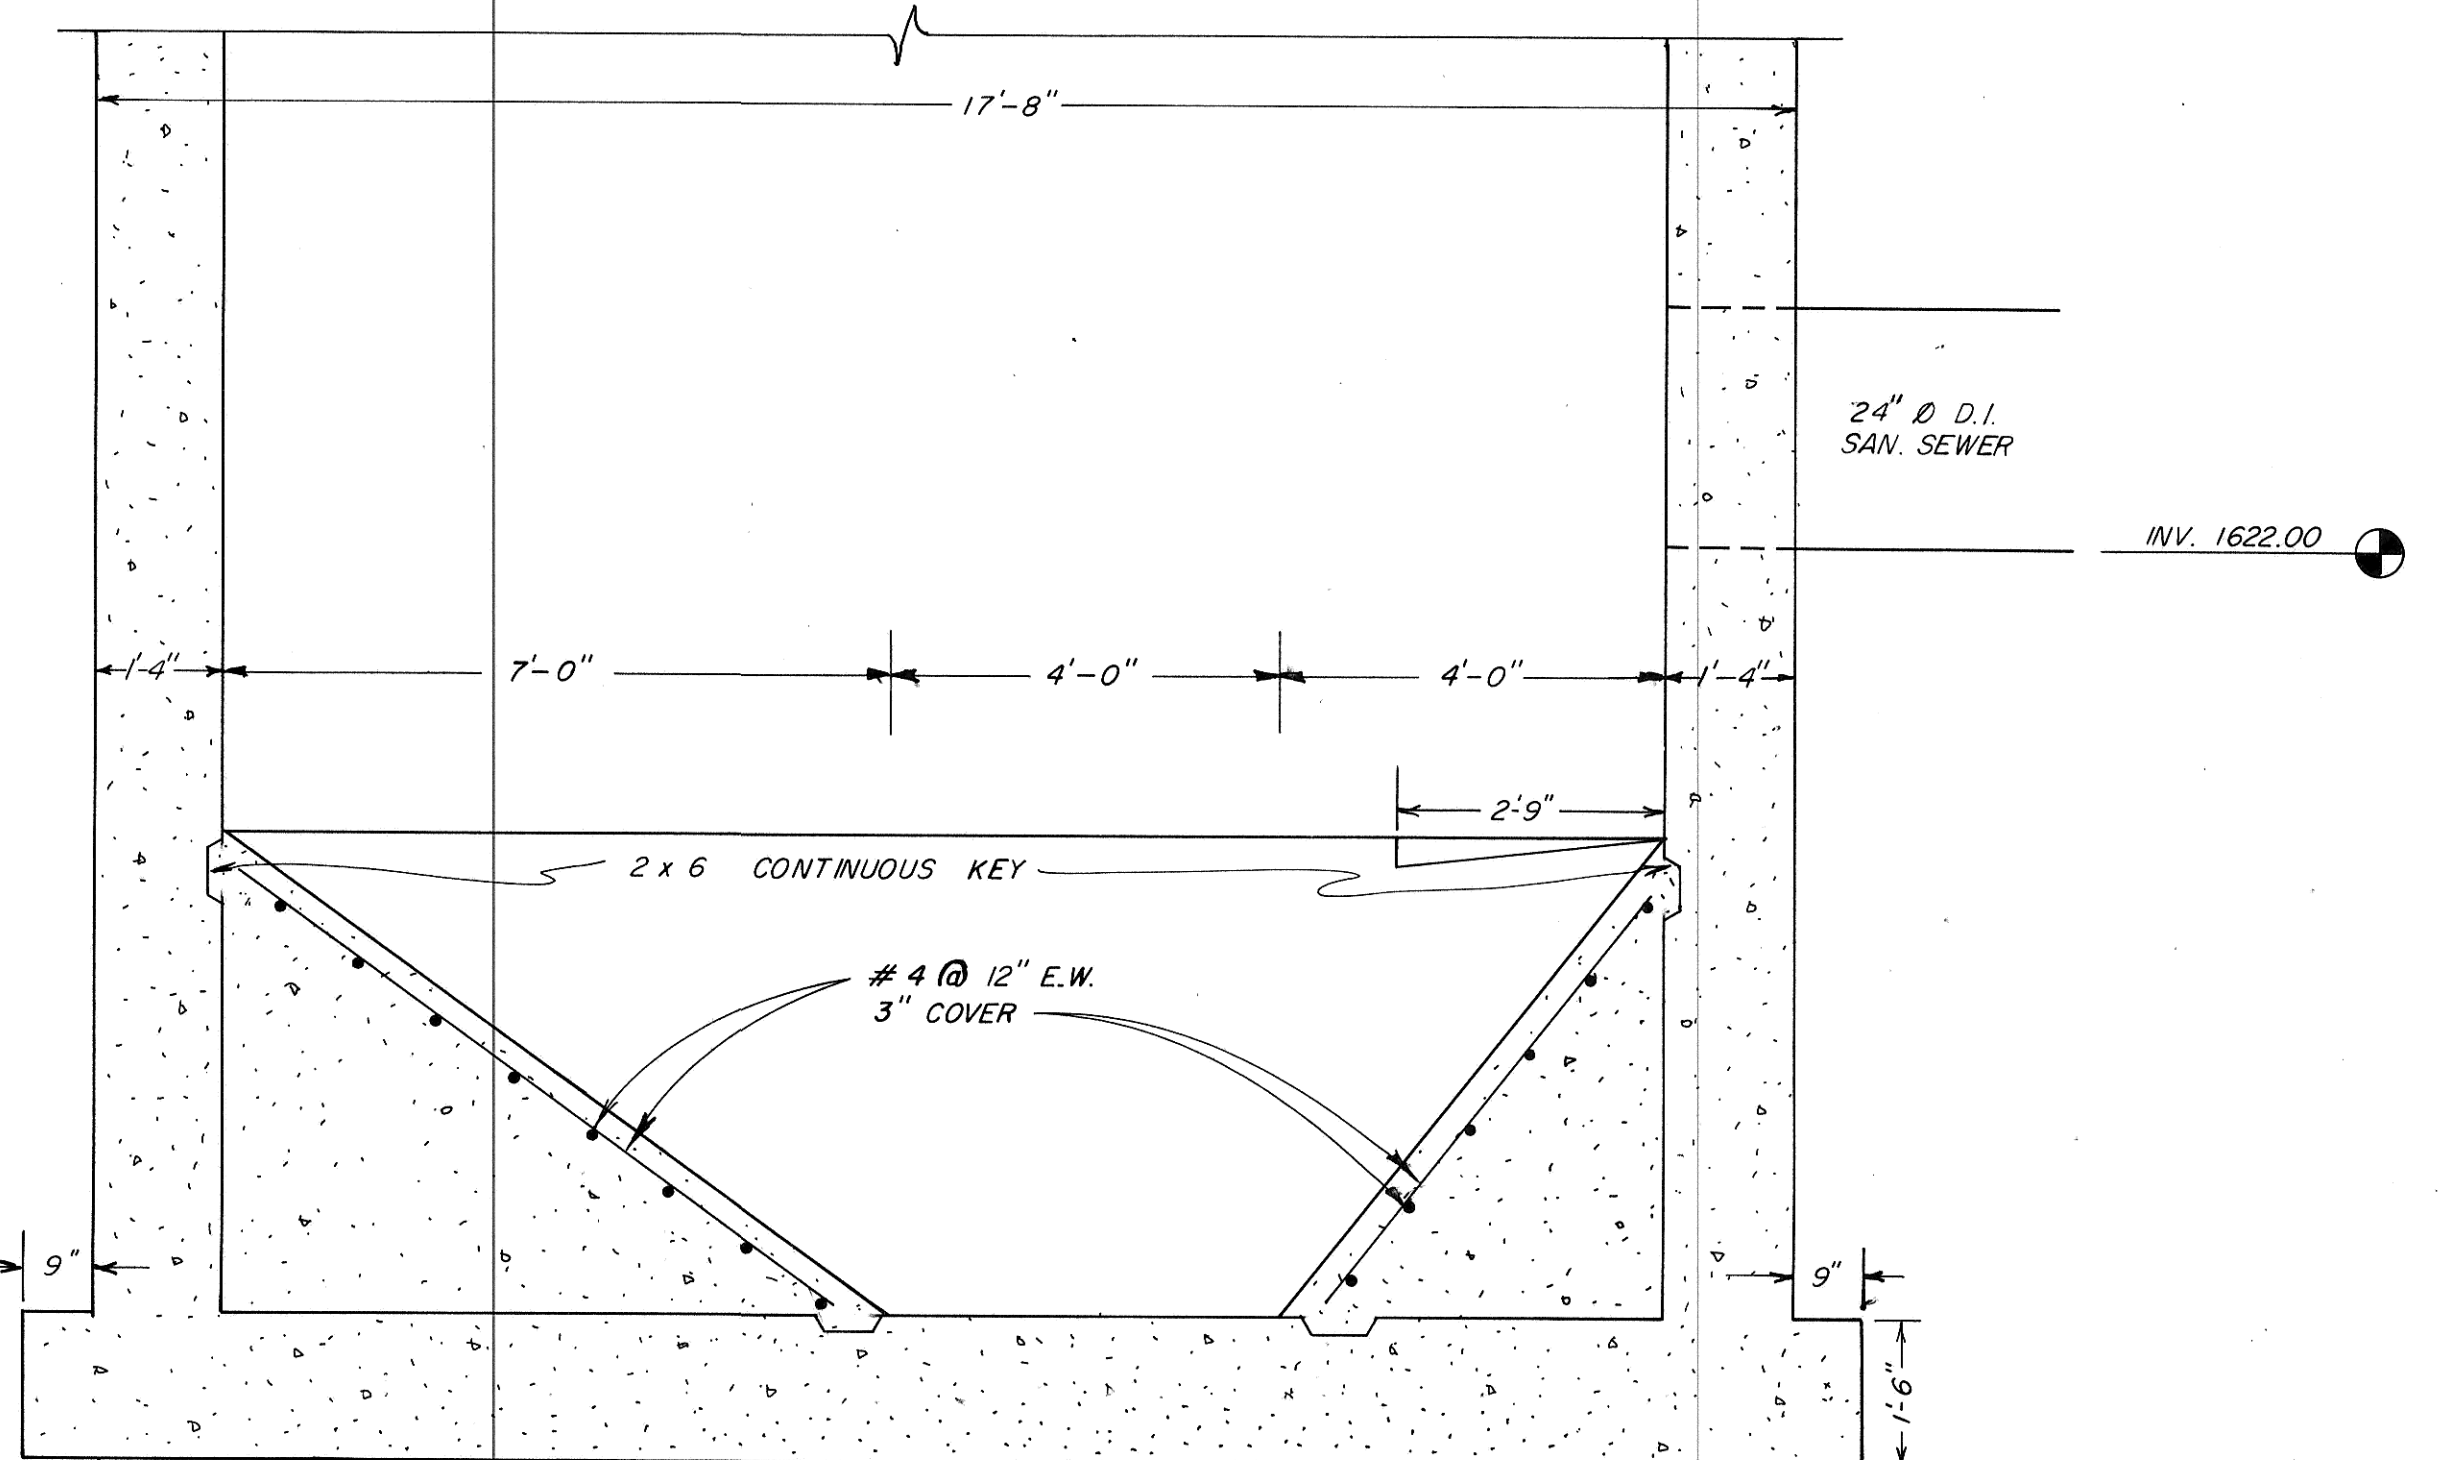



3
S2
WETWELL SECTION VIEW

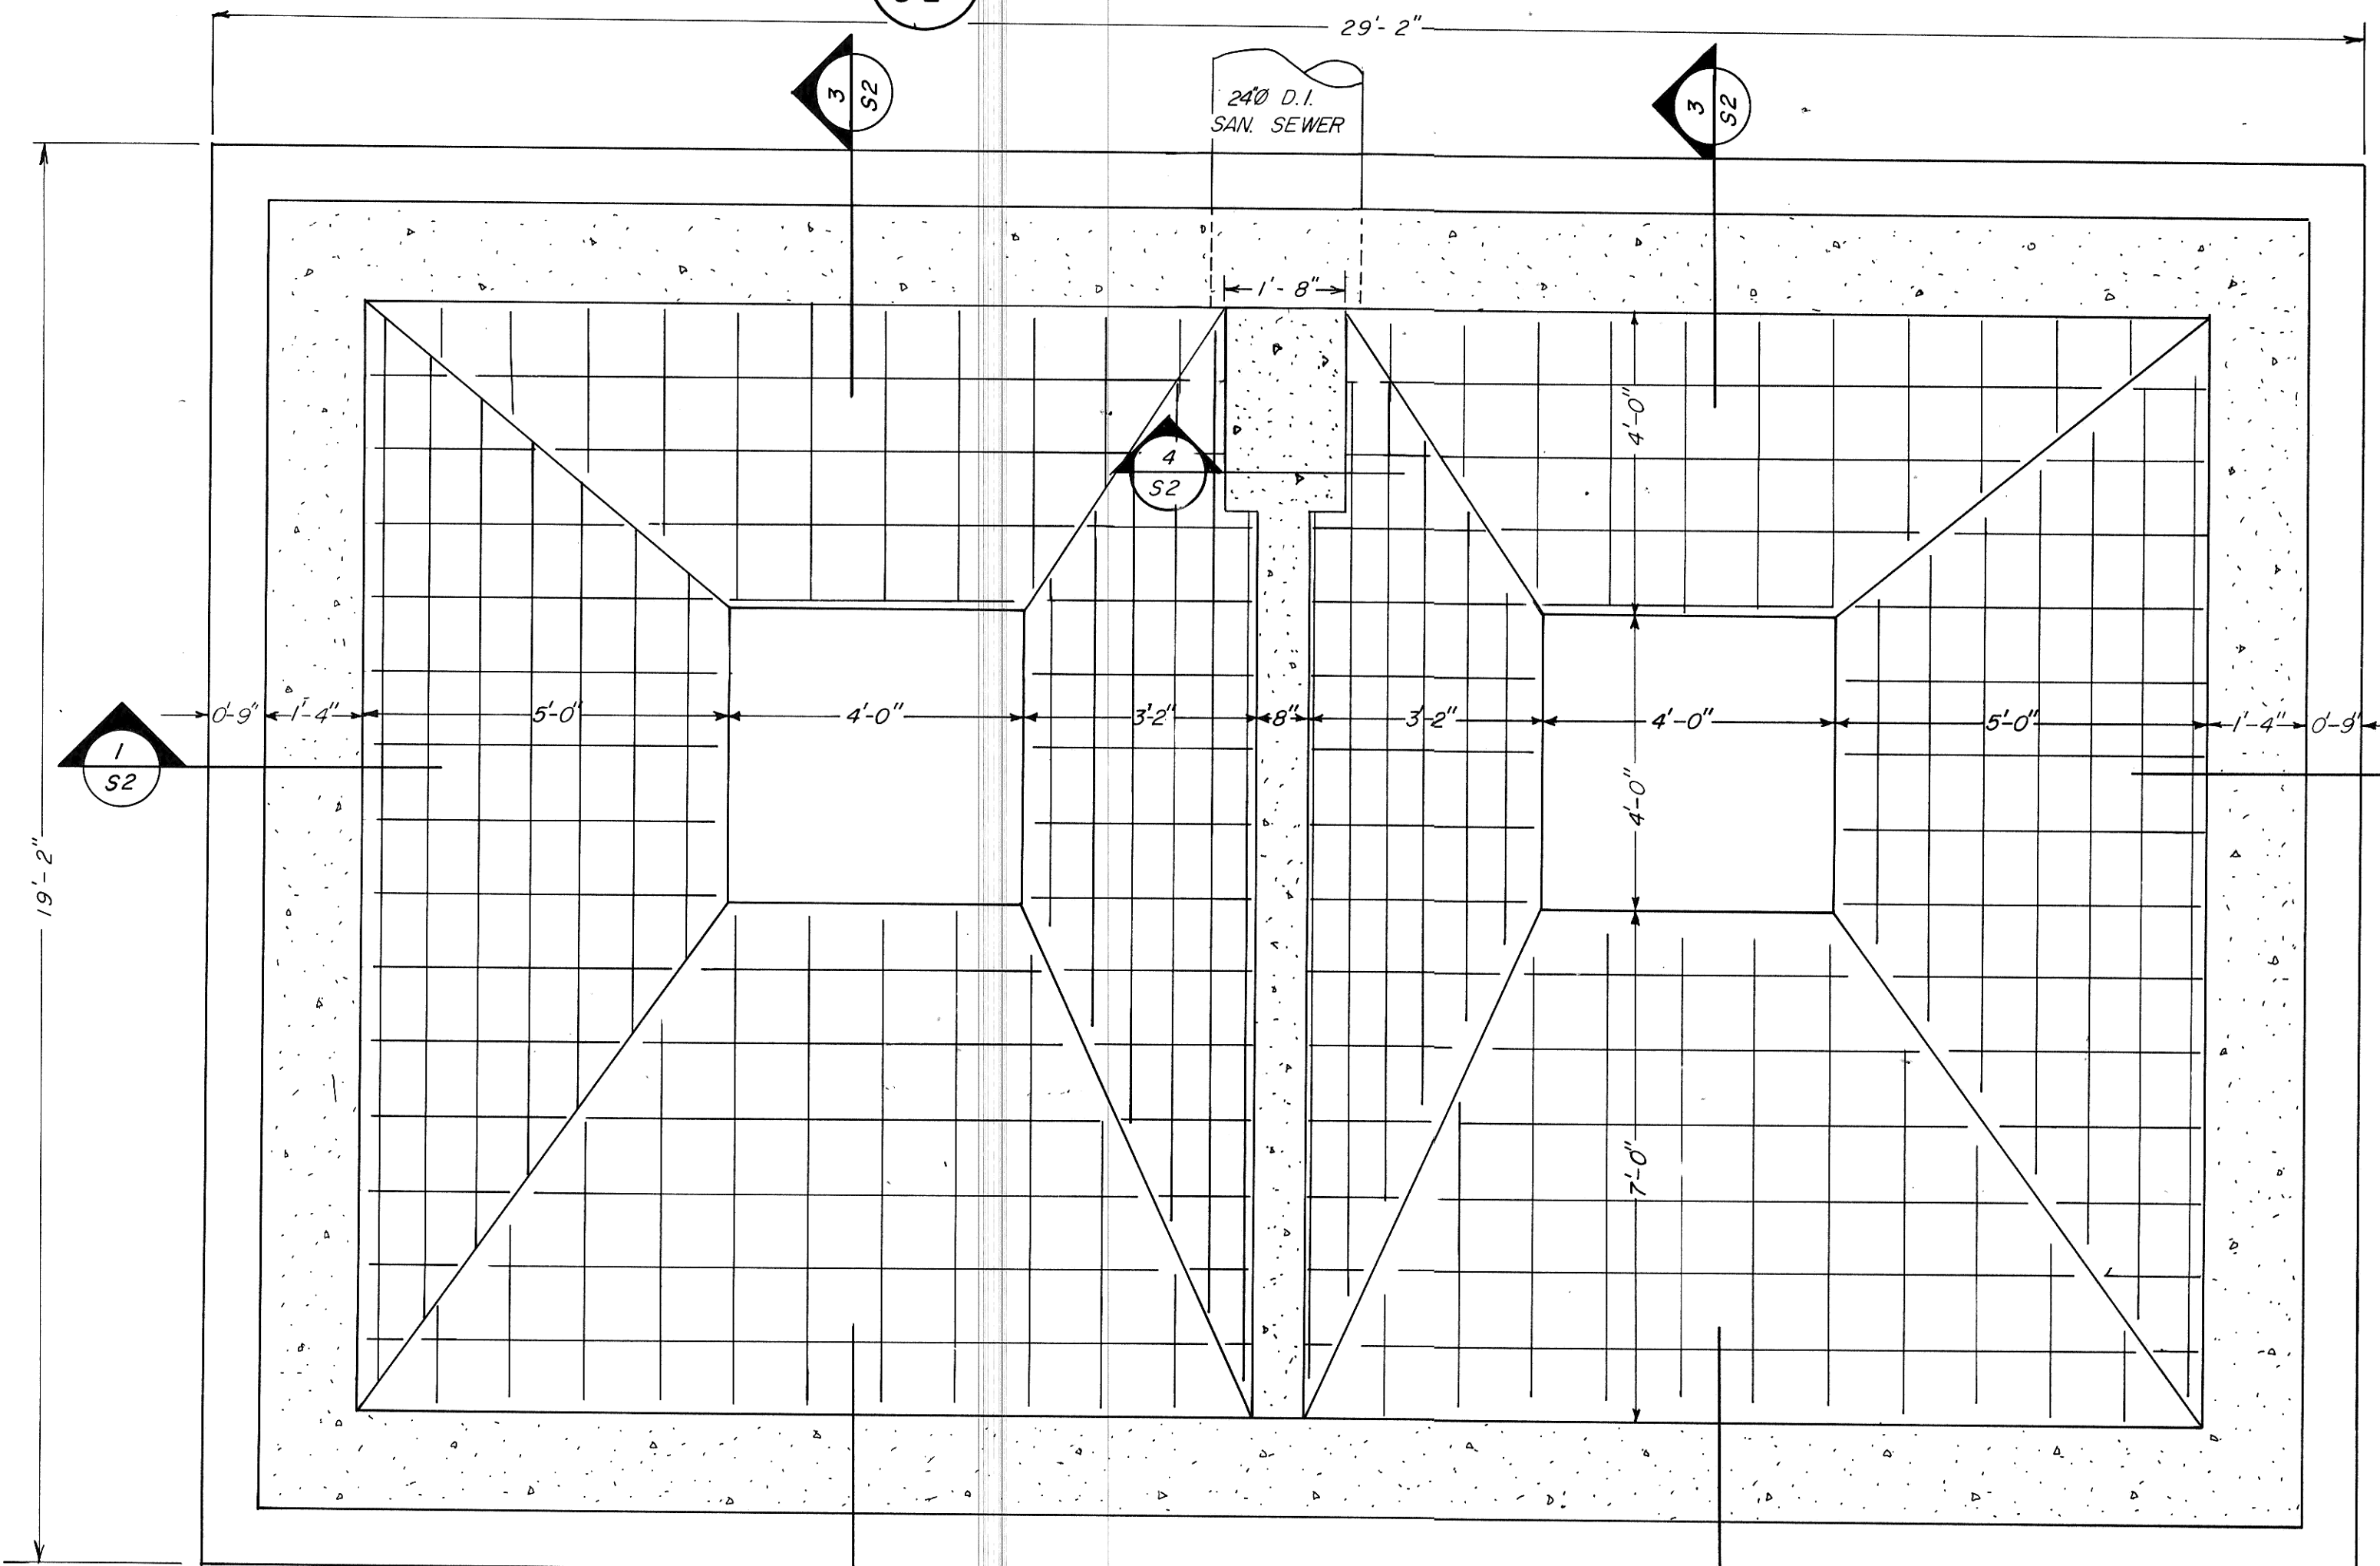

2
S2
WETWELL STRUCTURAL PLAN

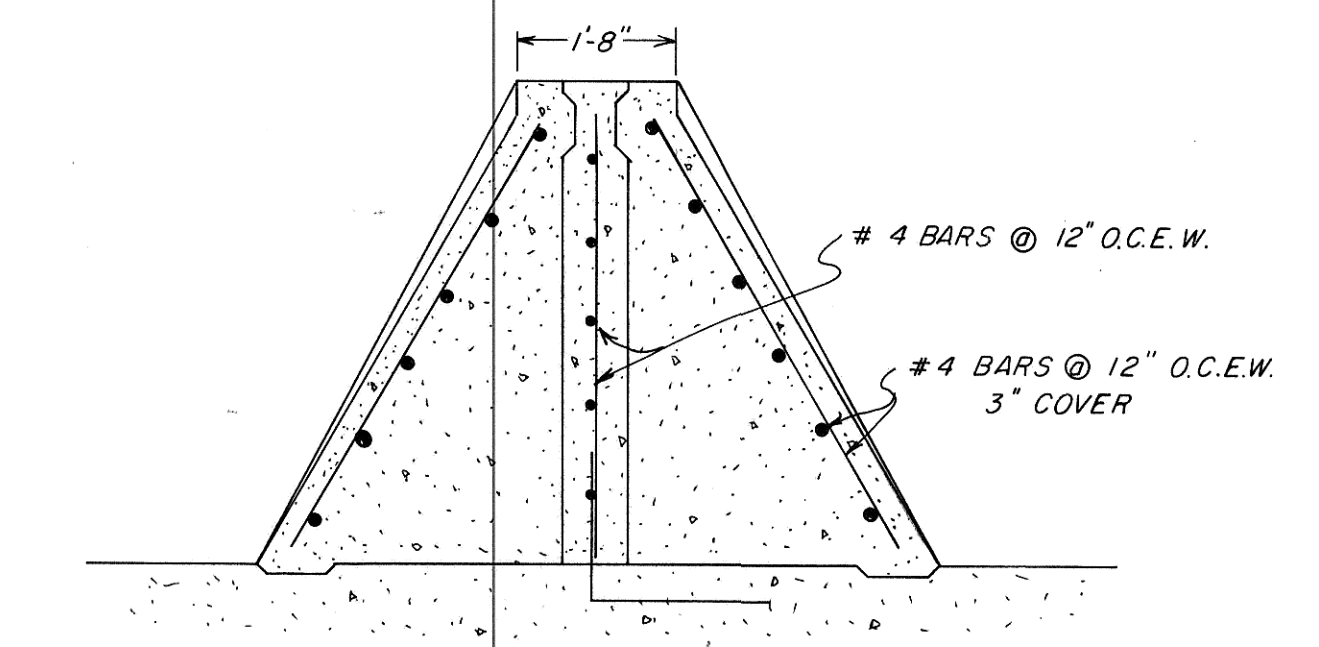

4
S2
BASKET SCREEN LEDGE

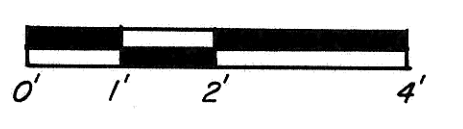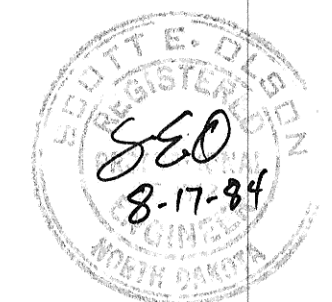

PHASE III

REV.	DATE	DESCRIPTION	BY

MANDAN INTERCEPTOR 1984		MANDAN, NORTH DAKOTA	
MASTER PUMPING STATION			
WETWELL STRUCTURAL PLAN			
ULTEIG ENGINEERS, INC. CONSULTING ENGINEERS • ARCHITECT			
FARGO • BISMARCK • MINNEAPOLIS			
DRAWN BY: K.M.S.	SCALE: AS SHOWN	PROJECT NO. 4241	
CHECKED BY: [Signature]	DATE: MAY 1984	SHEET 5-2 of	

Record Drawing

