
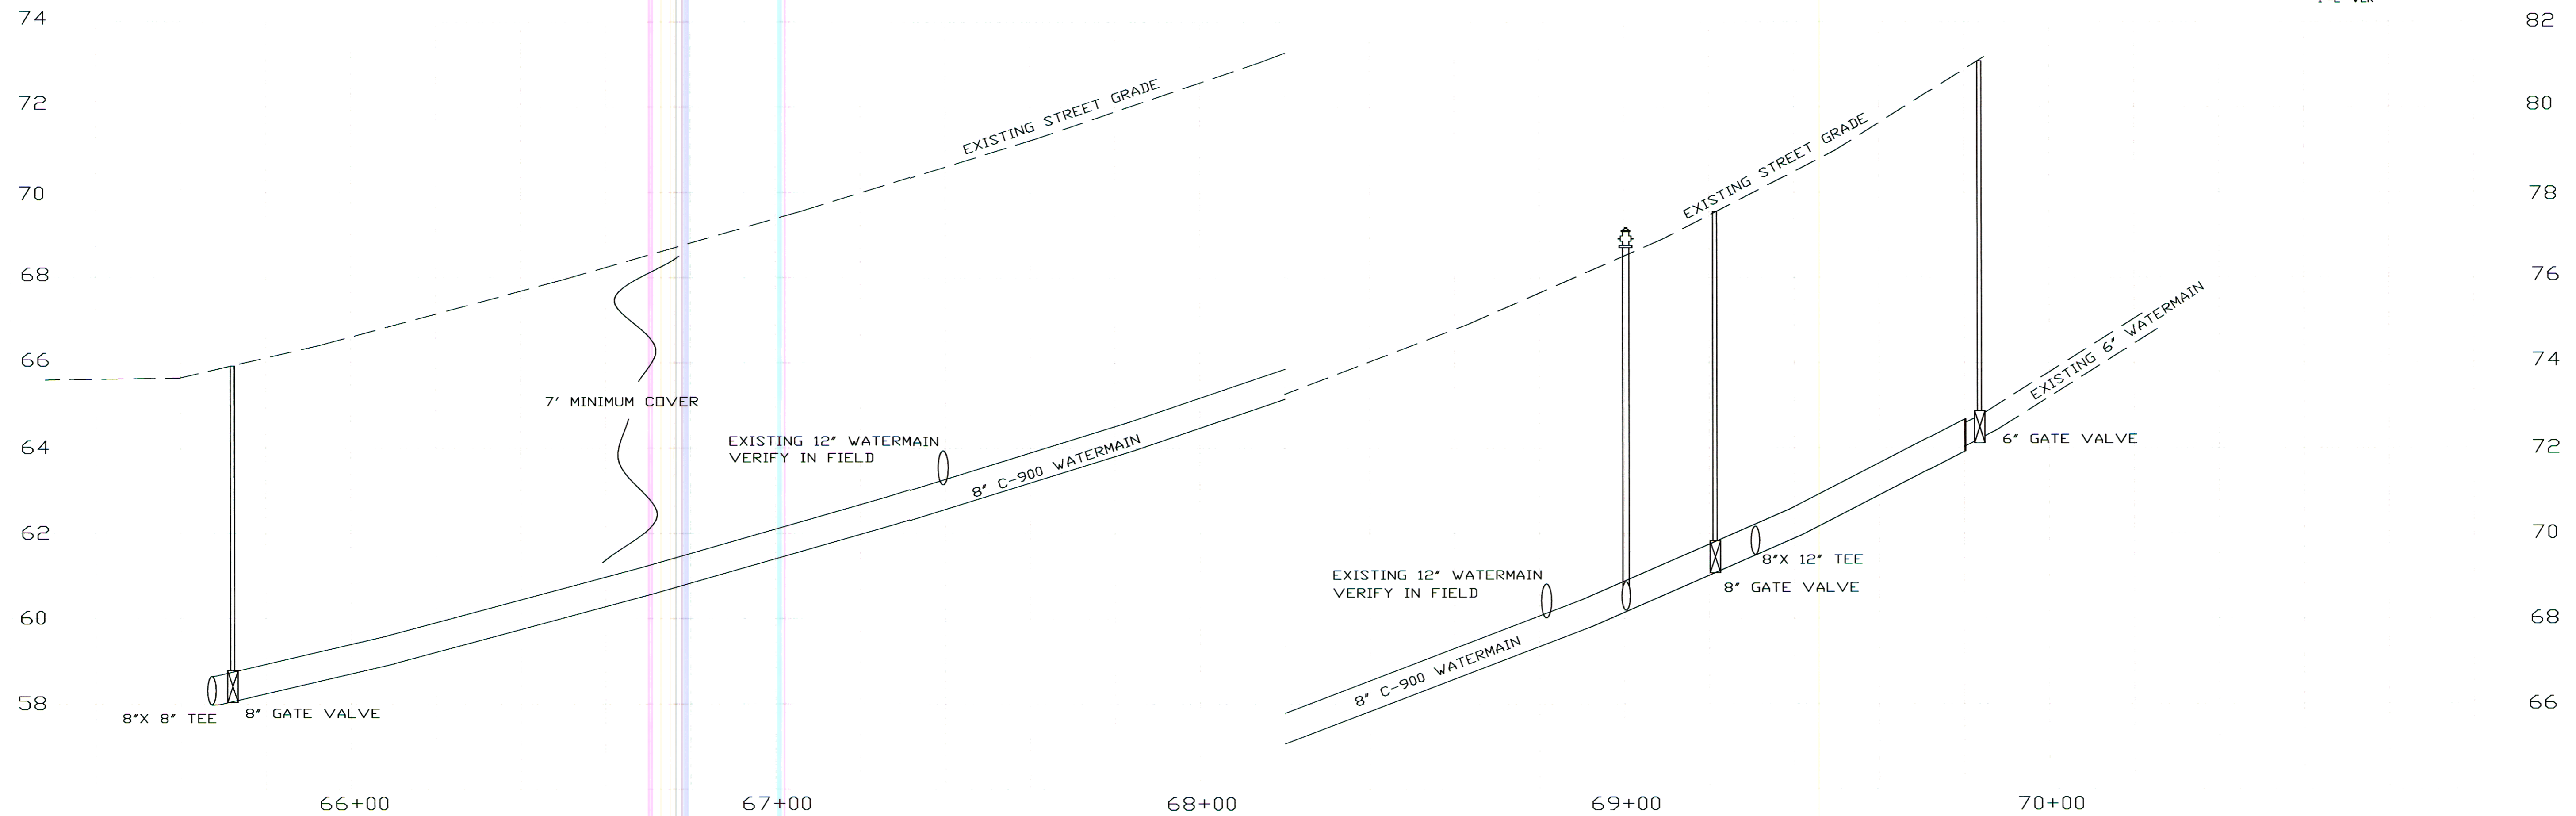


SEE SHEET 7 OF 8

--- Warning --- All utilities are to be located before digging.

Overhead utilities may be present.

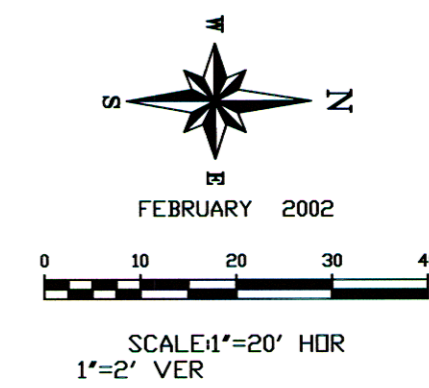

Description	Date	Drawn By	Checked By
Asbuilt	10/02	jlw	jlw

City of Mandan
 Watermain Replacement Project 2002-03
 8TH AVE NW - FROM 5TH ST TO 6TH ST

City Eng. T LITTLE	Drawn By: J L W
Approved By: T R L	Checked By: T R L
Project No. 2002-03	Date: 2/5/2002
District No. N/A	Scale: AS SHOWN