
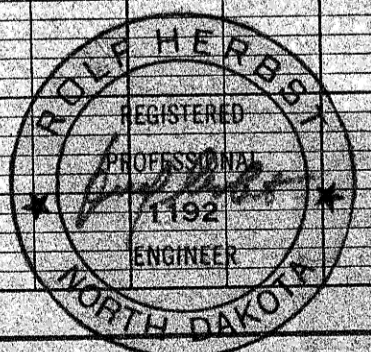
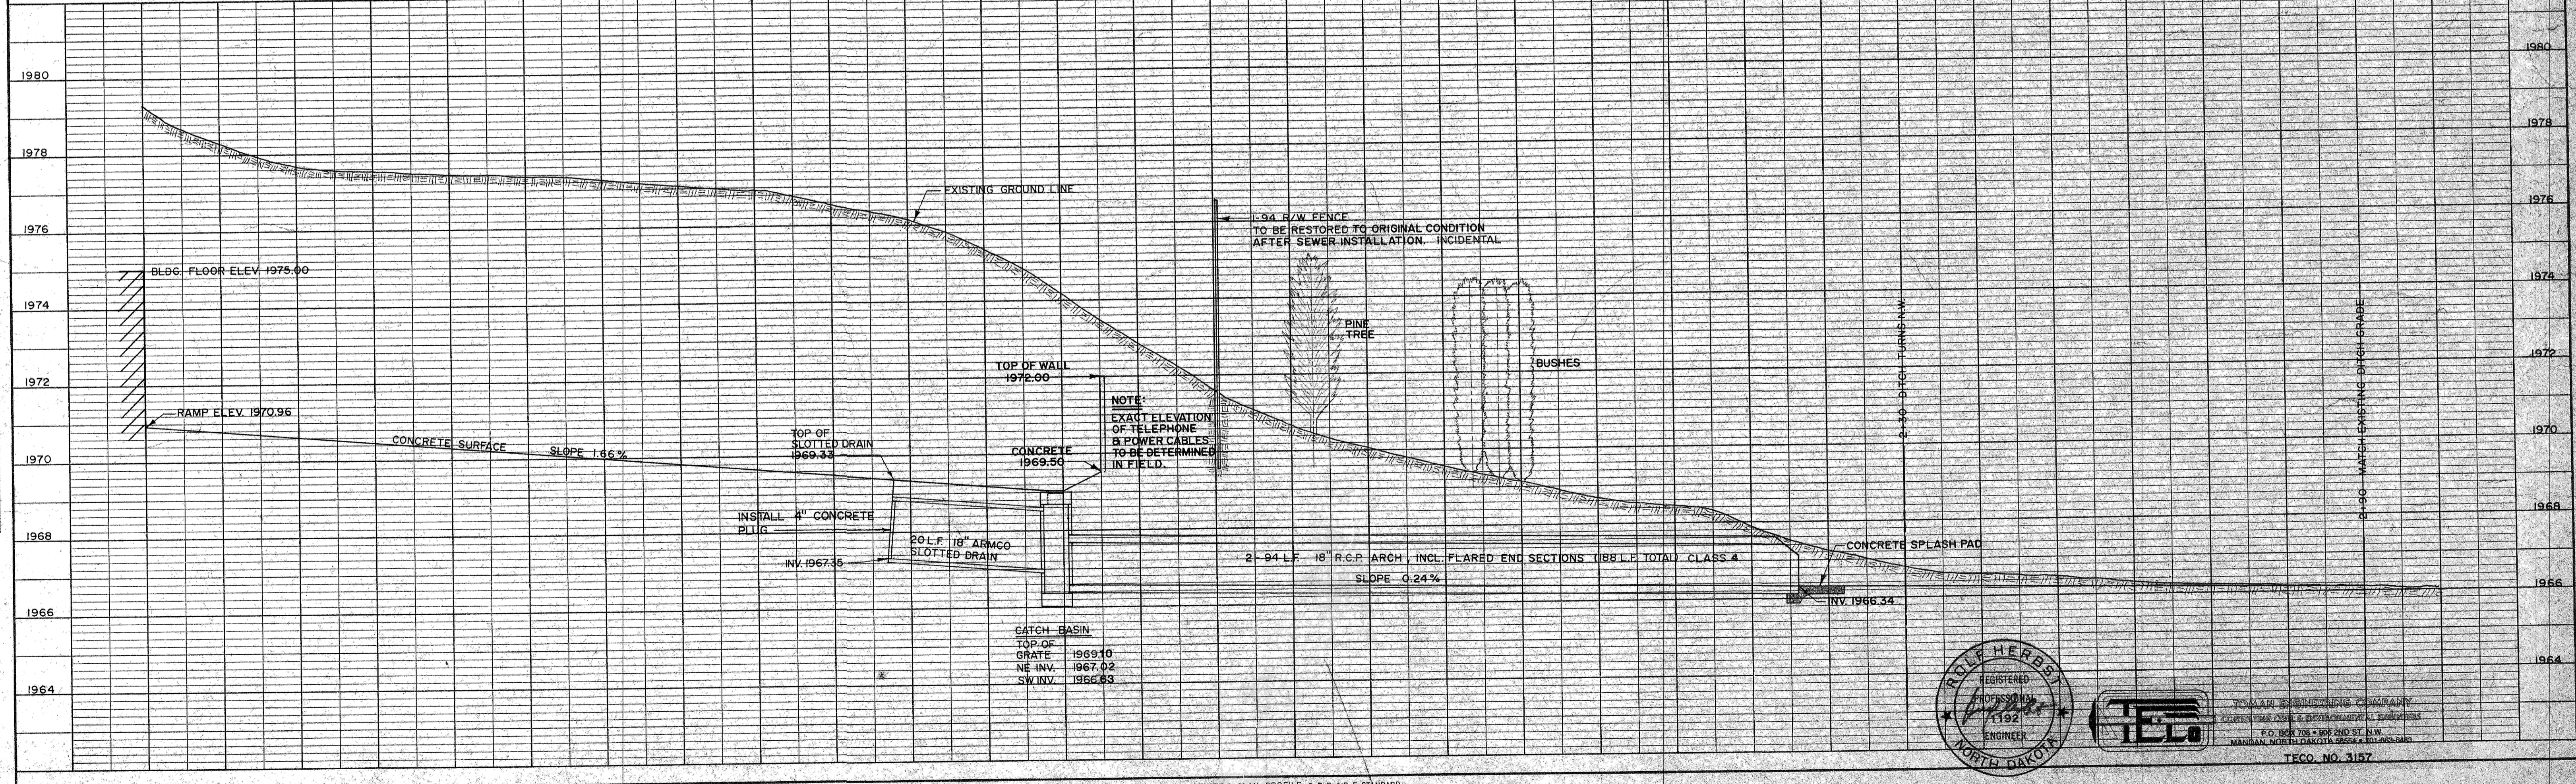


PLAN
 SURVEYED, PLOTTED, CHECKED, NOTE BOOK, RT. OF WAY CHECKED, NO.

PROFILE
 SURVEYED, GRADES CHECKED, B. M. & NOTED, STRUCTURE NOTATIONS CHECKED, NO.

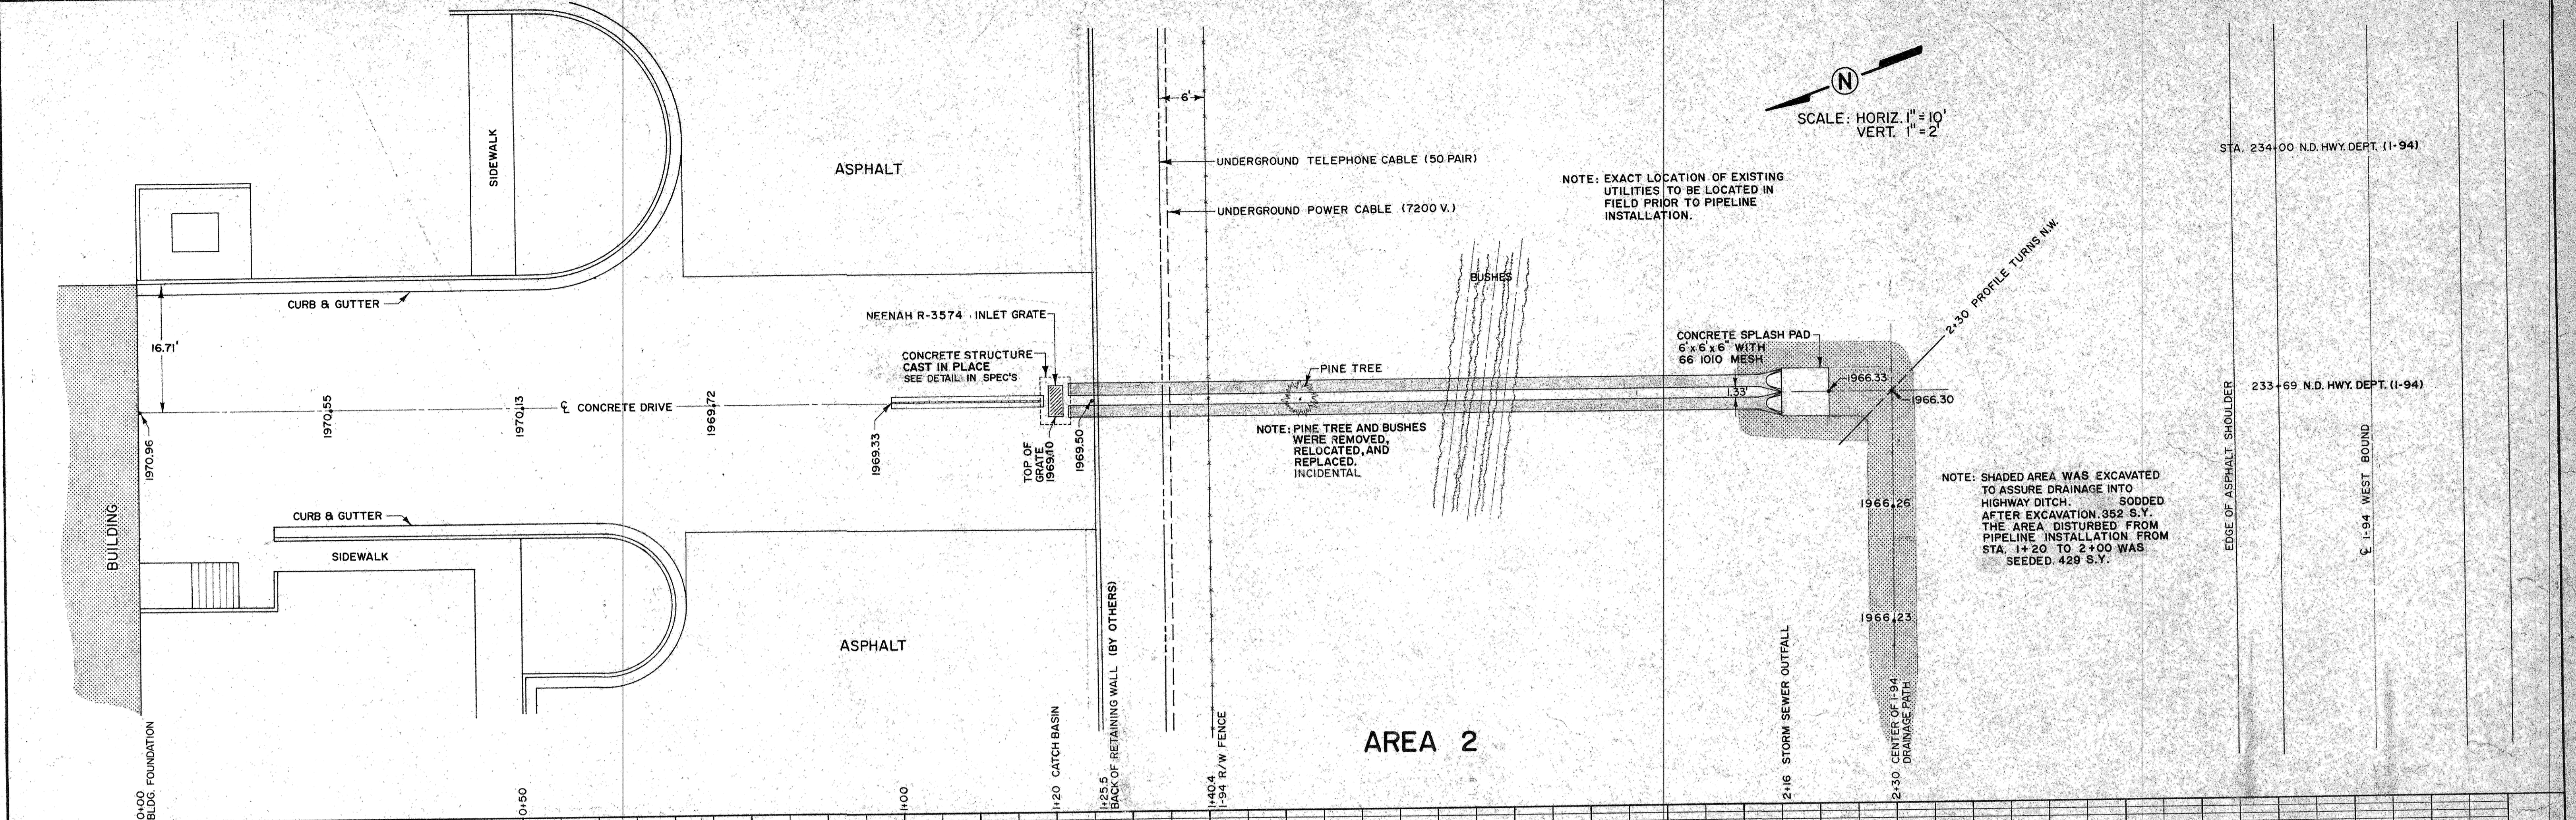

TECO ENGINEERING COMPANY
 1192
 ENGINEER

PLATE 1 - PLAN - PROFILE O.P.R. & R.E. STANDARD
 KEUFFEL & ESSER CO. NEW YORK
 K. & E. Co. No. 347-1R ALBANY 1932 MADE IN U.S.A. 2409

SHEET NO. 4 OF 5 SHEETS
 ASBUILT DRAWING