


CITY OF MANDAN

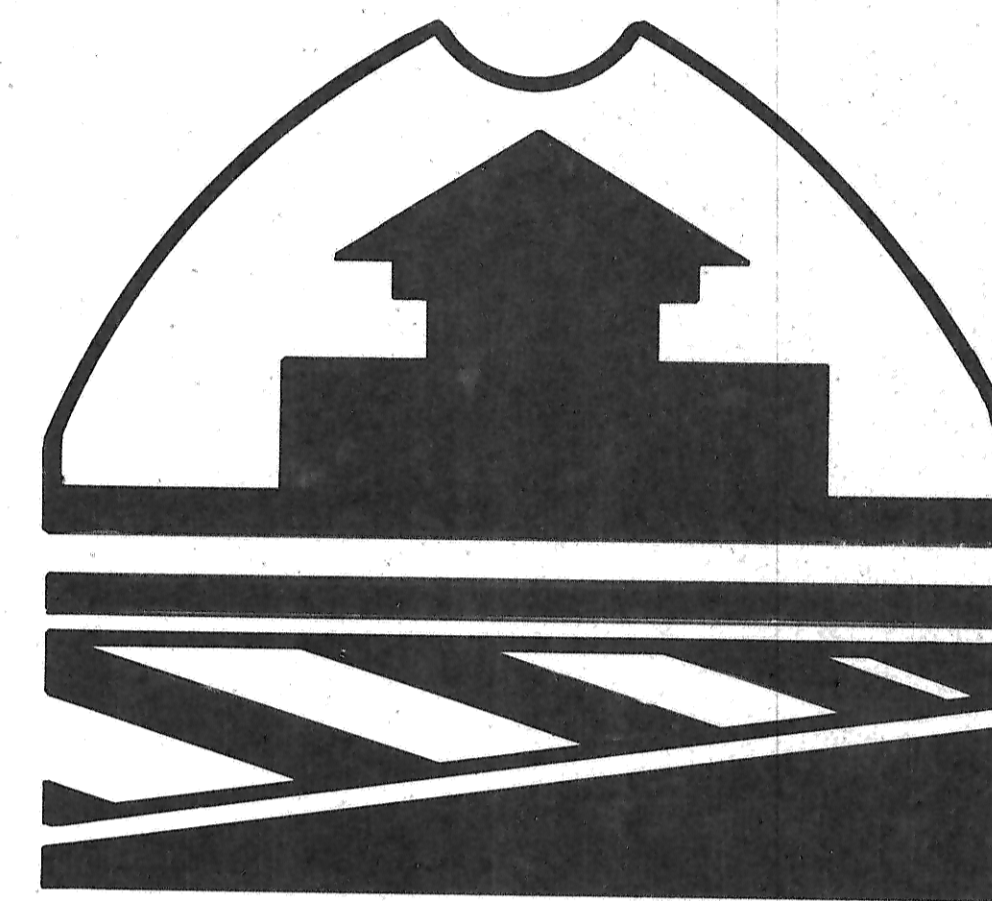

SANITARY SEWER IMPROVEMENT DISTRICT No. 19 PROJECT No 88-11

ENGINEER'S CERTIFICATE
I, THOMAS R. LITTLE, BEING A REGISTERED PROFESSIONAL ENGINEER, HEREBY CERTIFY THAT THE ATTACHED PLANS WERE PREPARED UNDER MY SUPERVISION AND ARE COMPLETE AND CORRECT TO THE BEST OF MY KNOWLEDGE AND BELIEF.

Thomas R. Little
THOMAS R. LITTLE P.E., R.L.S.
CITY ENGINEER
MANDAN, NORTH DAKOTA

8

AS BUILT

SHEET 1 of 2 COVER SHEET
SHEET 2 of 2 8" SANITARY SEWER

D 19
P 88-11