
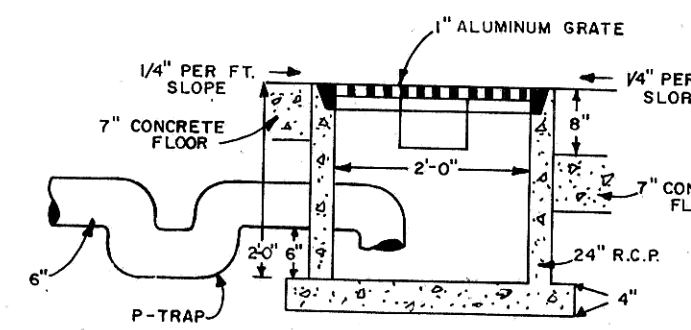
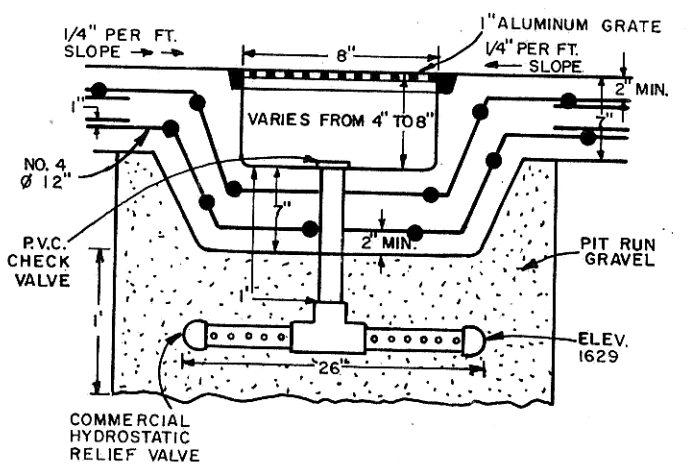


SCALE: 1" = 4'

- LEGEND**
- HBK — HOSE BIB KEY
 - C.O. — CLEAN OUT
 - HW — HOT WATER
 - CW — COLD WATER
 - HWH — HOT WATER HEATER
 - BLDG. SEWER
 - FD — FLOOR DRAIN
 - WATER CLOSET
 - SINK
 - URINAL
 - CG — CHLORINE GAS LINE

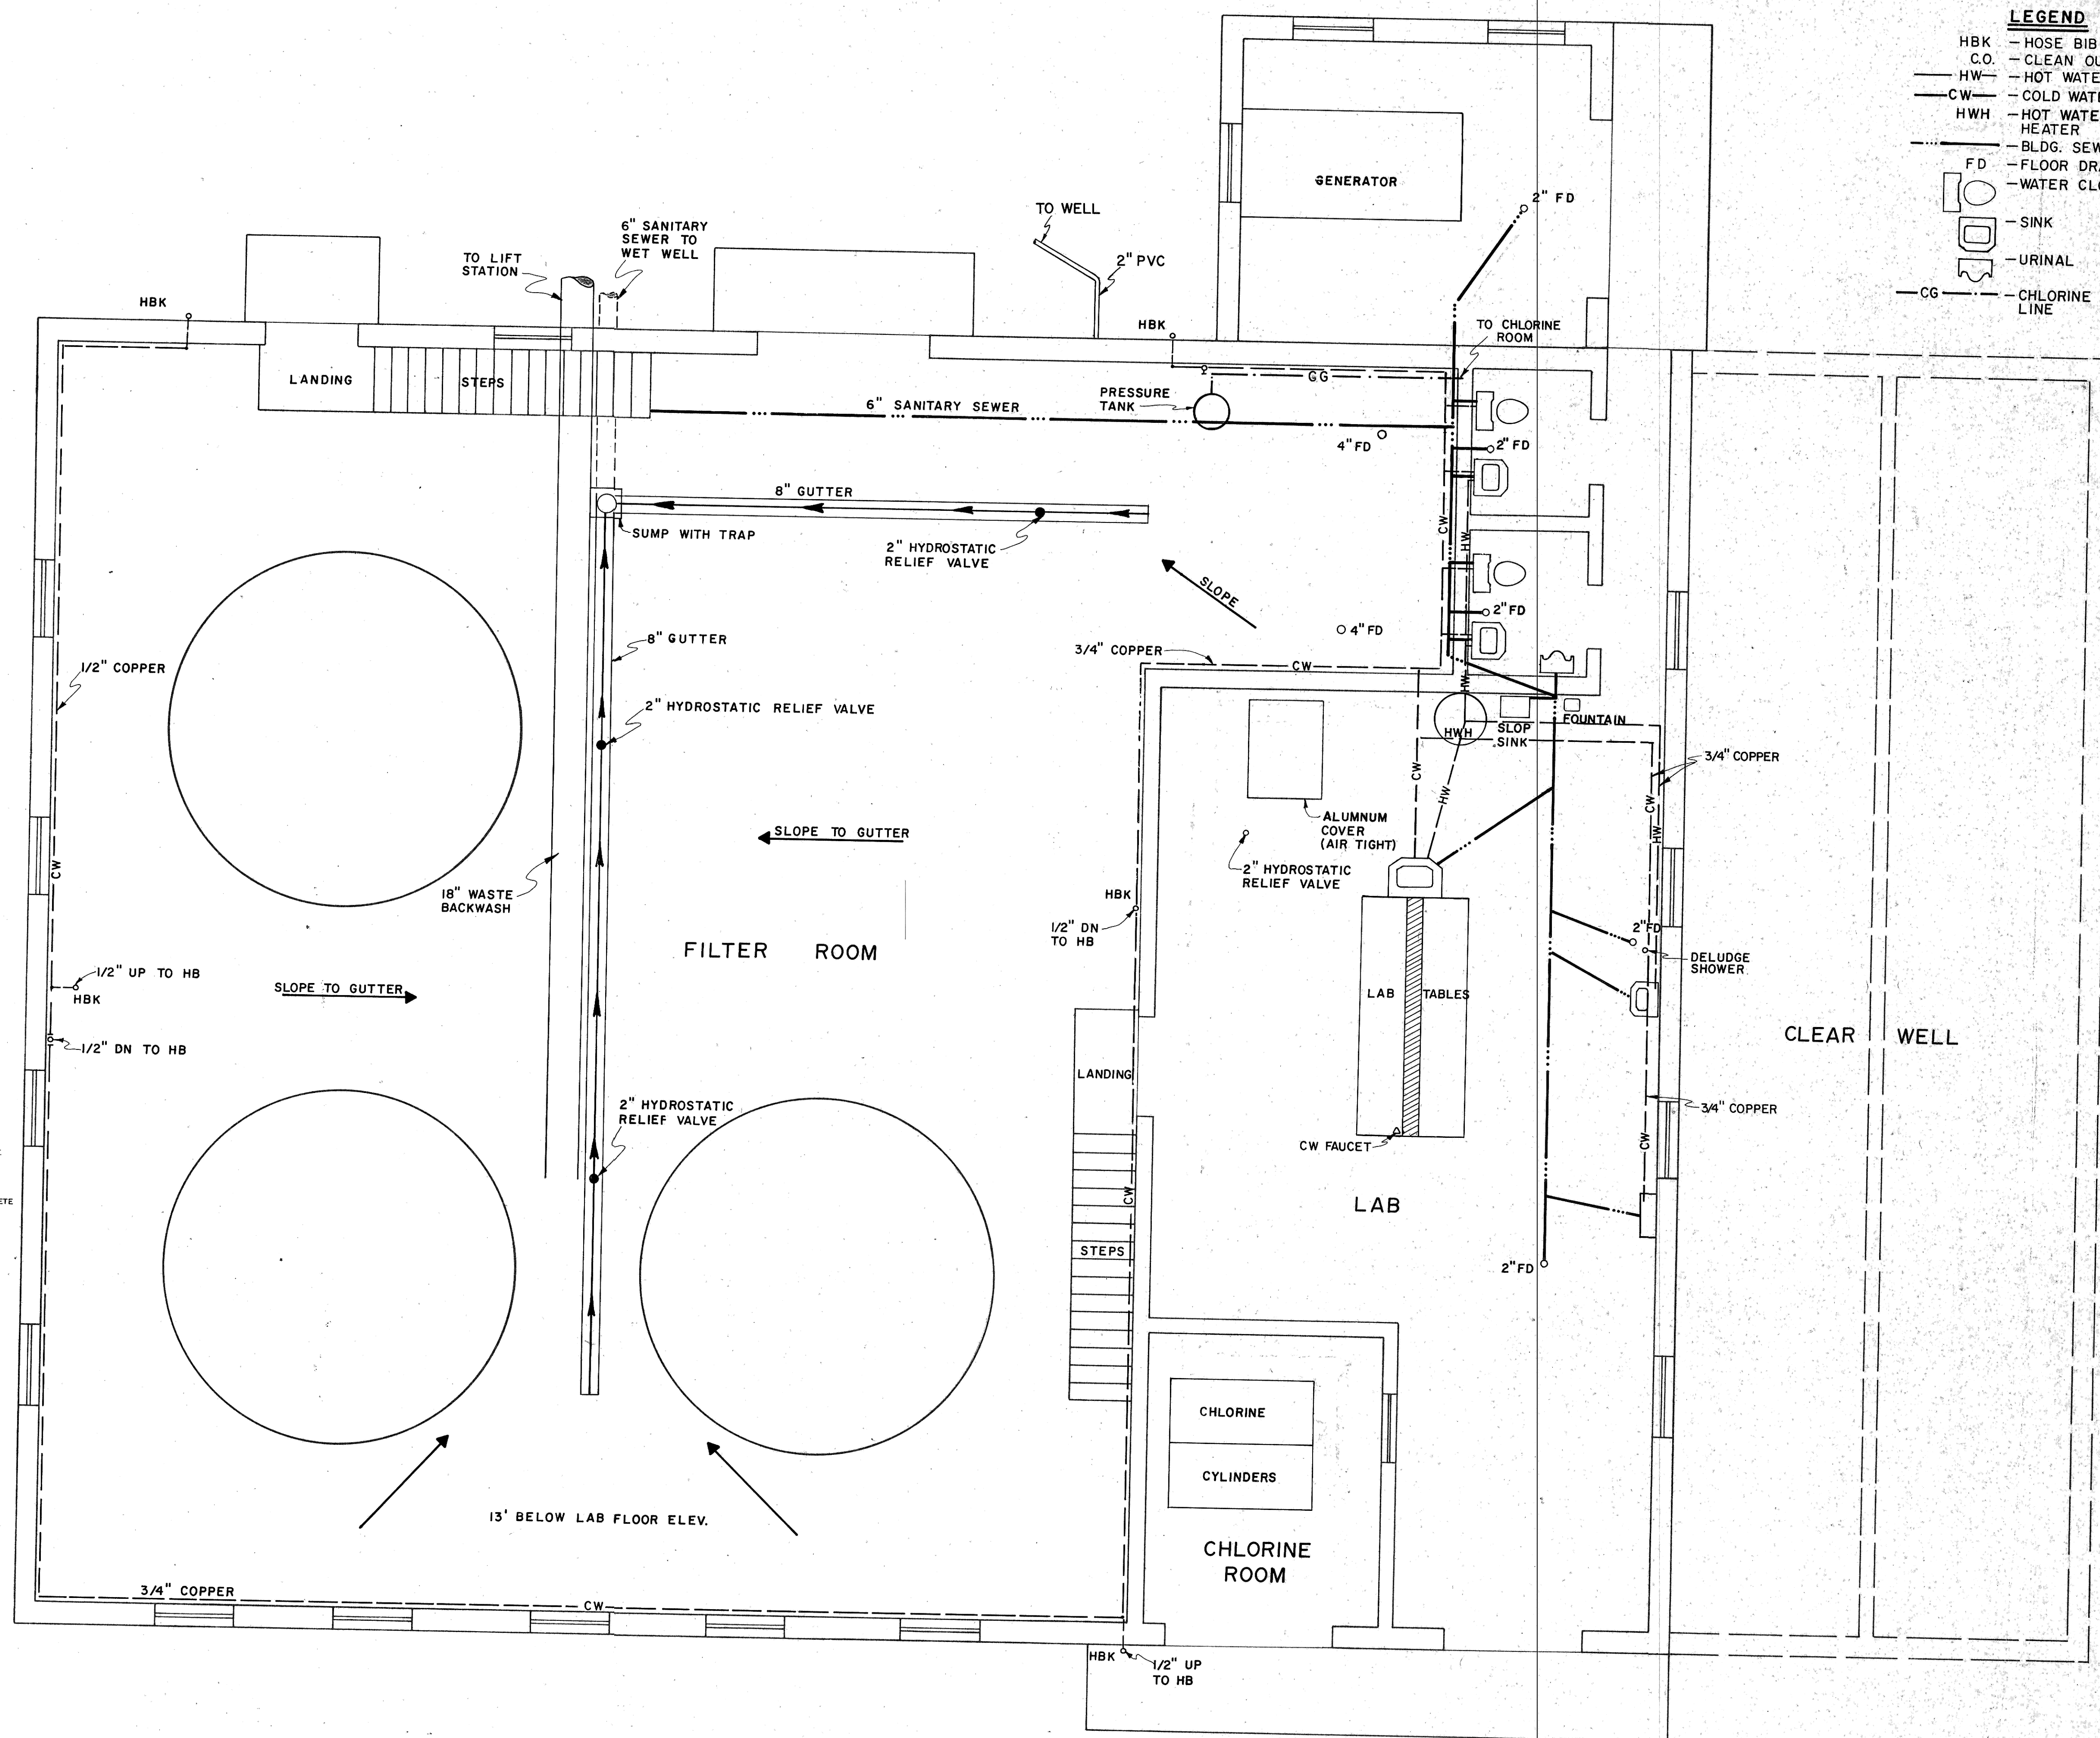

TOMAN ENGINEERING COMPANY
 CIVIL & ENVIRONMENTAL CONSULTANTS
 P.O. BOX 708 BOISEVAIN, MAN. ROK OEO
 MANDAN, N.D. 58554

UPGRADING WASTEWATER TREATMENT FACILITIES INCREMENT 1
 CONTRACTOR'S RECORD DRAWINGS (AS BUILT)
 EPA NO. C380325-03
 CITY OF MANDAN, N.D.
 CITY PROJECT NO-SEWER IMPROVEMENT DISTRICT NO-17

PLUMBING LAYOUT

DRAWN BY: TP
 CHECKED BY:
 SHEET NUMBER: 5-A
 OF 23 SHEETS