

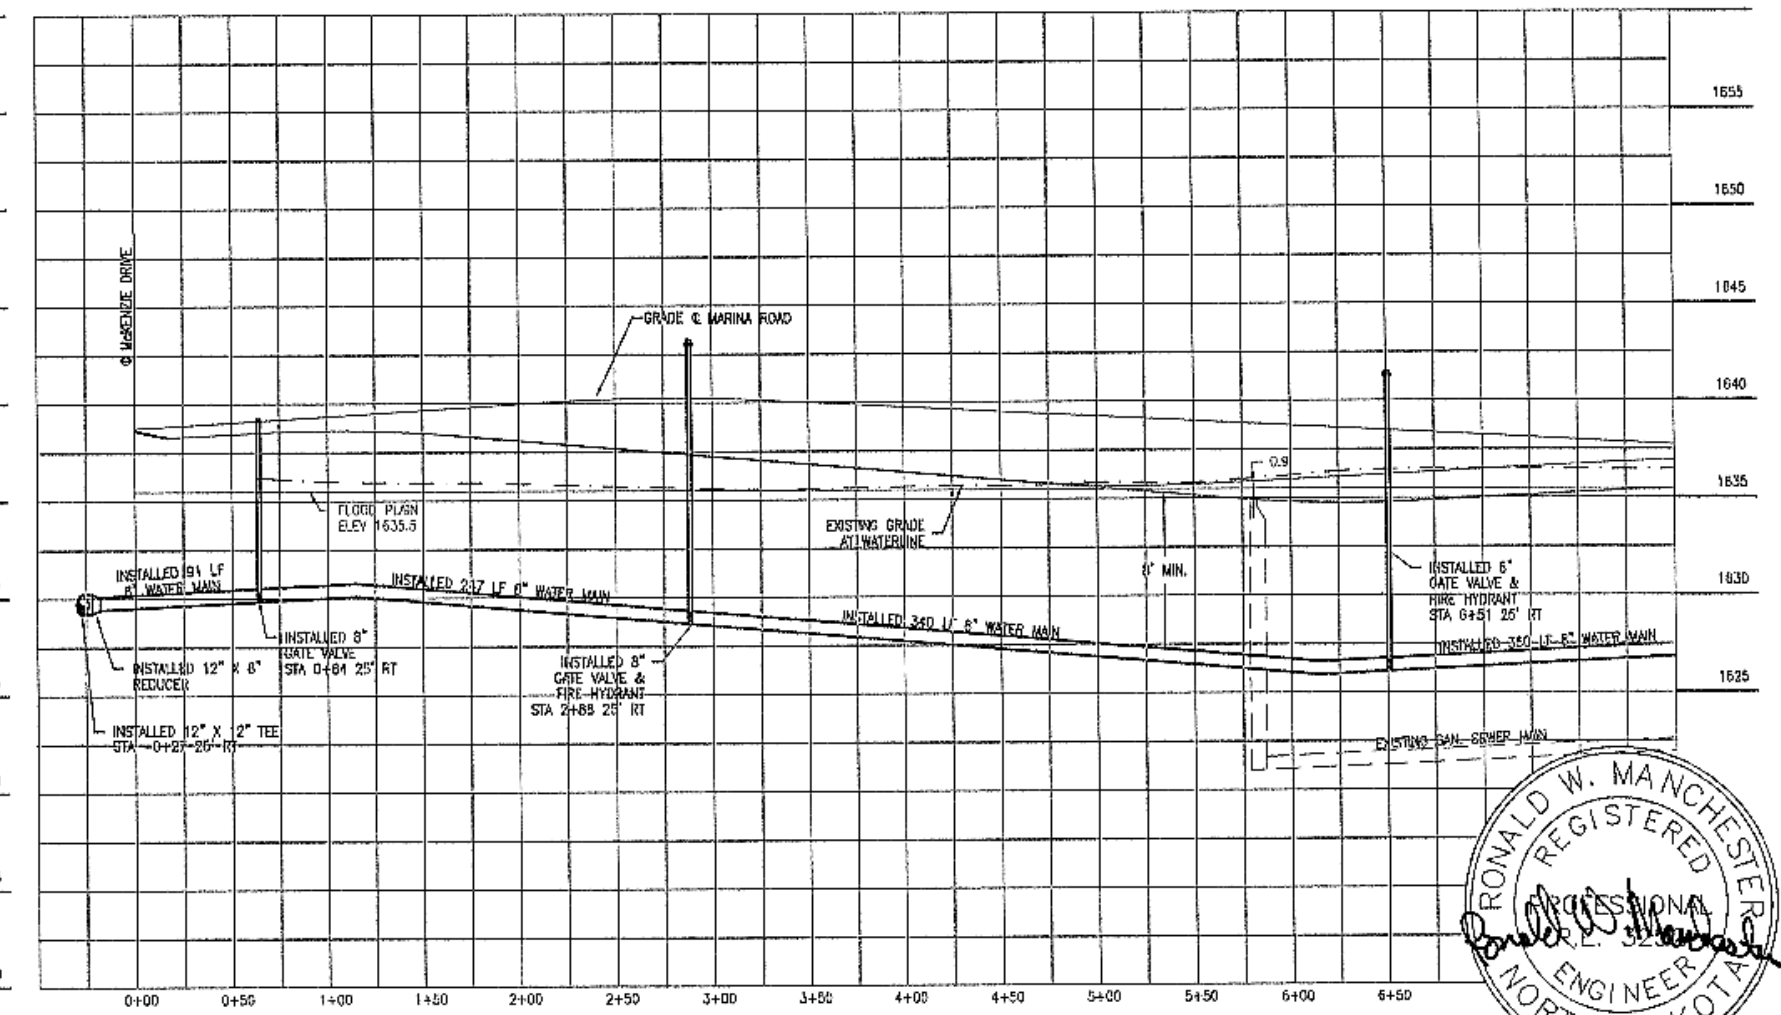


# AS BUILT WATER IMPROVEMENT PLANS McKENZIE DRIVE & MARINA ROAD

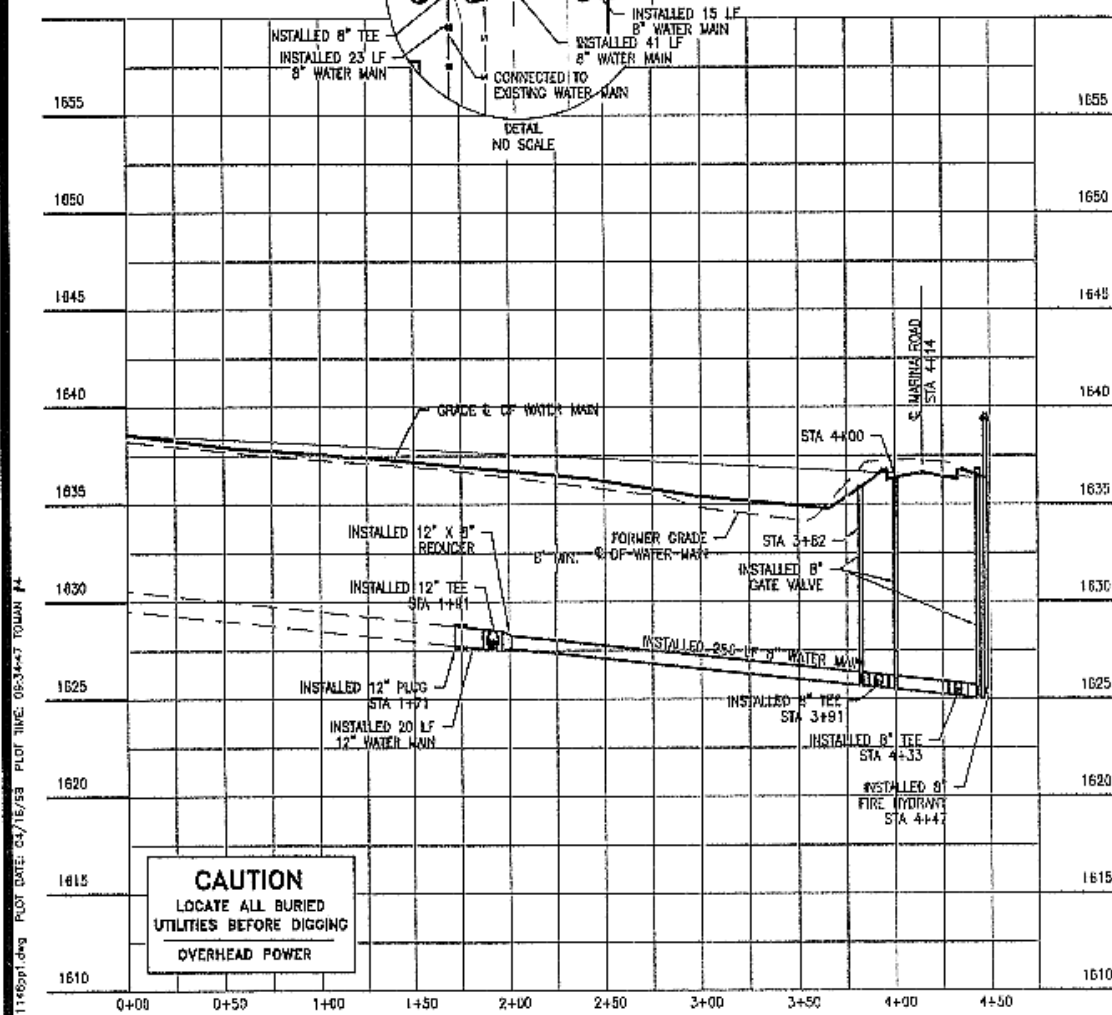

D:\1000\1146pr-1\1146pp1.dwg, 1/20/2005 4:42:32 PM, 1:2  
 DWGNAME: 1146pp1.dwg, PLOT DATE: 03/18/05, PLOT TIME: 09:34:43, PLOT BY: TDM

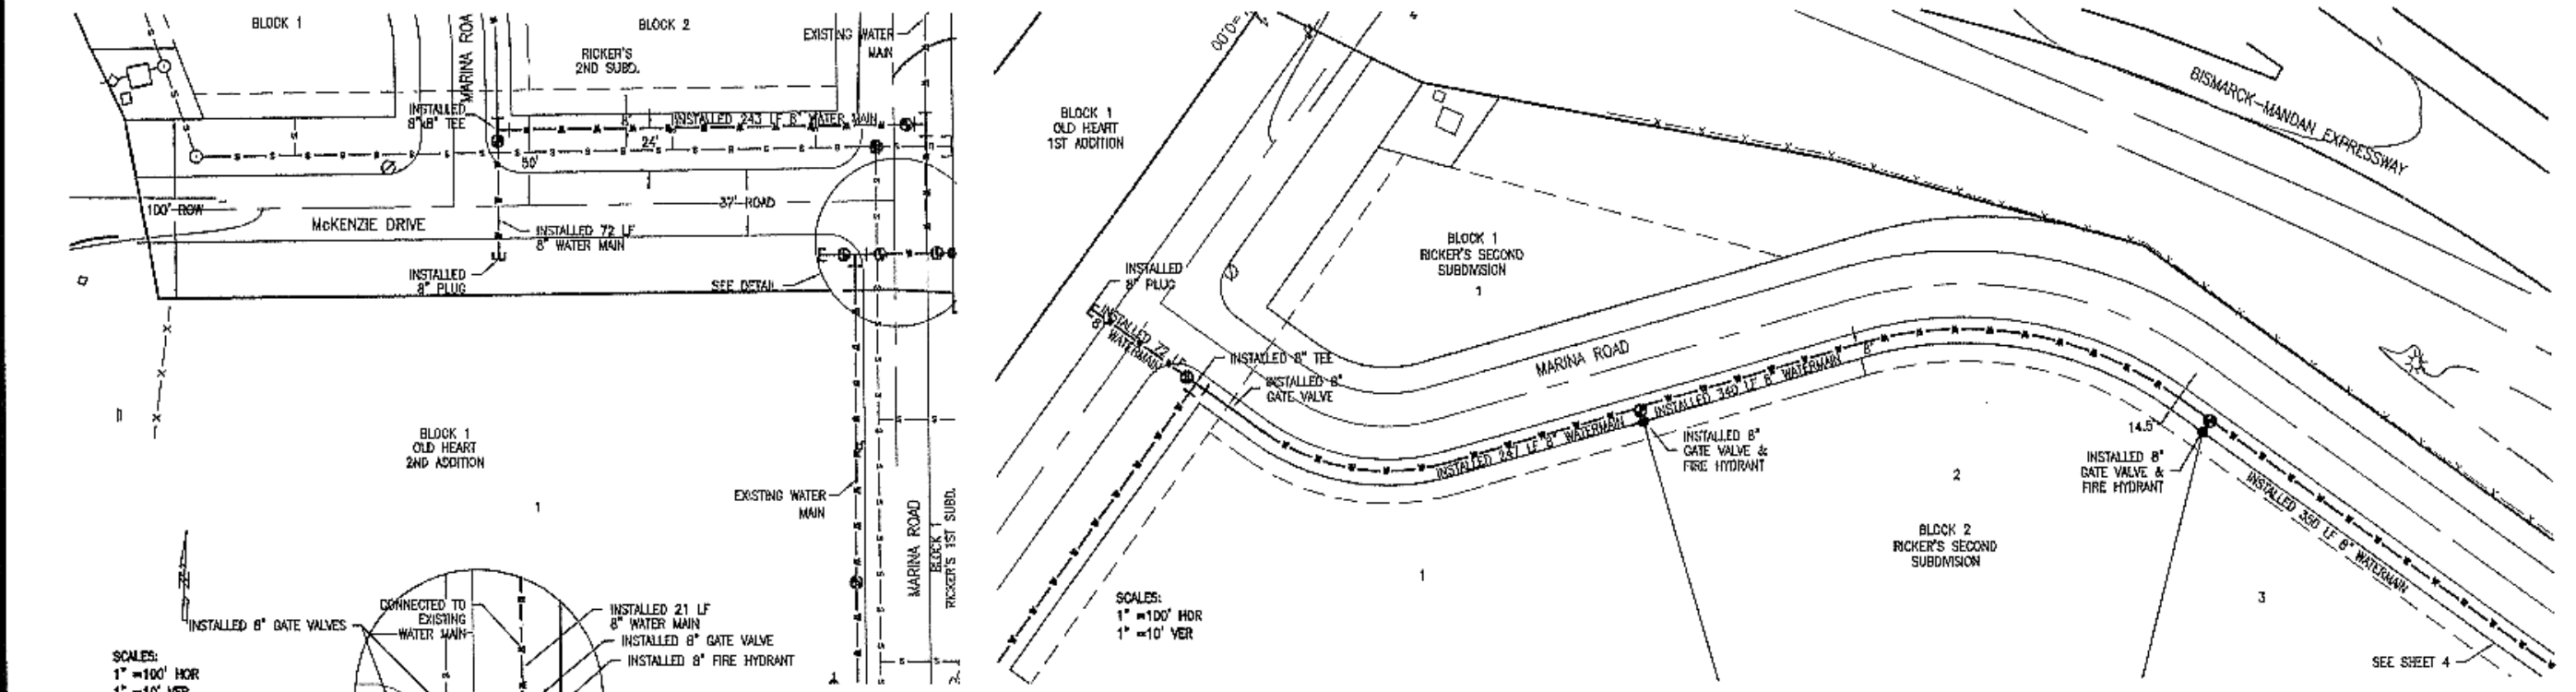

TOMAN ENGINEERING COMPANY  
 CONSULTING CIVIL & ENVIRONMENTAL ENGINEERS  
 908 2ND ST. N.E. (701) 643-4492

PROJECT: AS BUILT PLAN & PROFILES  
 McKENZIE DRIVE & MARINA ROAD  
 CITY PROJECT NO. 98-8

NO.	REVISIONS	DATE	BY	CHK
1	0200.000000.000000	03/18/05	TDM	TDM

SHEET NUMBER: 3 OF 5 SHEETS