4th AVENUE N.E.

15th STREET N.E.

DIVISION STREET N.E.

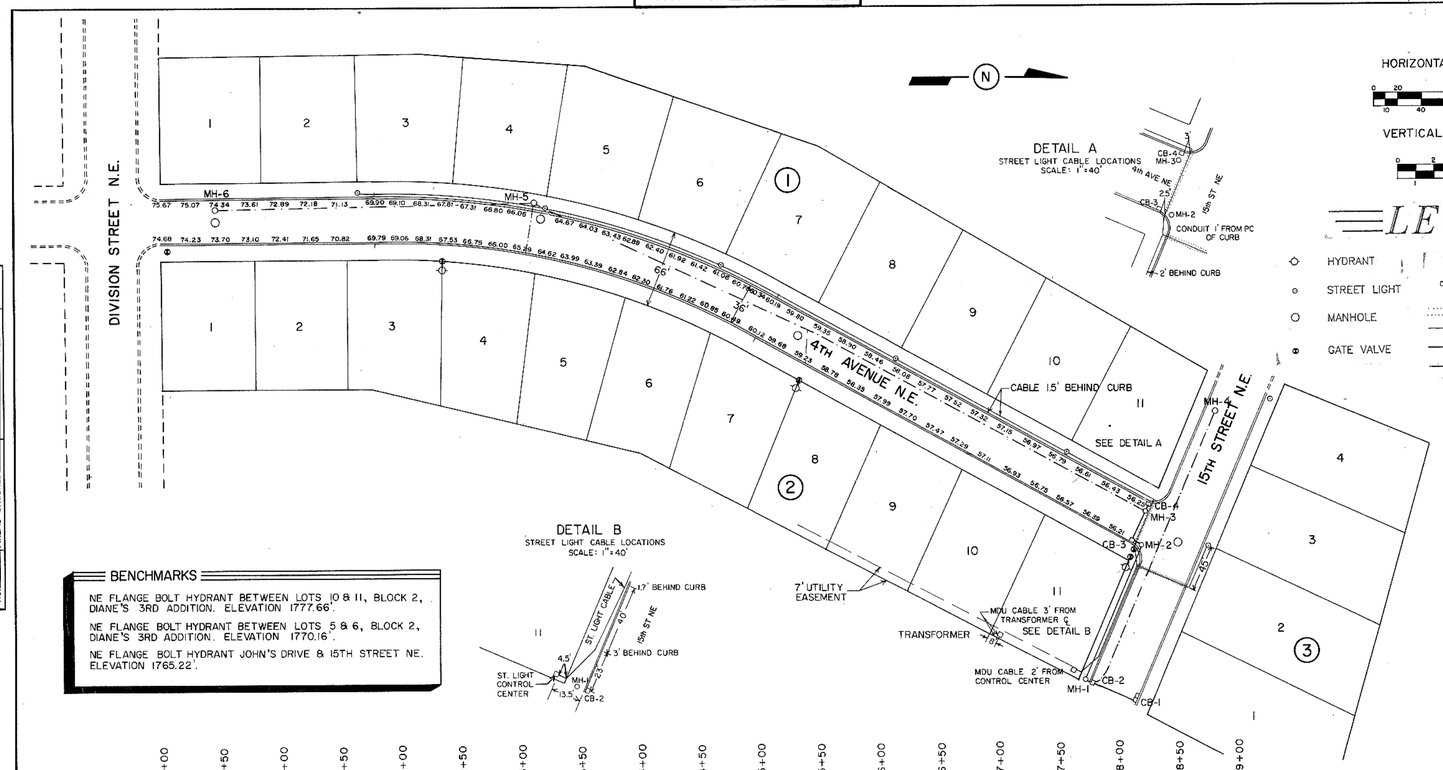

DETAIL A
STREET LIGHT CABLE LOCATIONS
SCALE: 1"=40'

DETAIL B
STREET LIGHT CABLE LOCATIONS
SCALE: 1"=40'

HORIZONTAL SCALE: 1"= 60'

VERTICAL SCALE: 1"= 4'

LEGEND

- HYDRANT
- STREET LIGHT
- MANHOLE
- GATE VALVE
- STORM SEWER MANHOLE
- CATCH BASIN
- 2" CONDUIT
- UNDERGROUND CIRCUITRY
- 15" REINFORCED CONCRETE PIPE
- 6" PERFORATED COLLECTOR PIPE

BENCHMARKS

NE FLANGE BOLT HYDRANT BETWEEN LOTS 10 & 11, BLOCK 2, DIANE'S 3RD ADDITION. ELEVATION 1777.66'.

NE FLANGE BOLT HYDRANT BETWEEN LOTS 5 & 6, BLOCK 2, DIANE'S 3RD ADDITION. ELEVATION 1770.16'.

NE FLANGE BOLT HYDRANT JOHN'S DRIVE & 15TH STREET NE. ELEVATION 1765.22'.

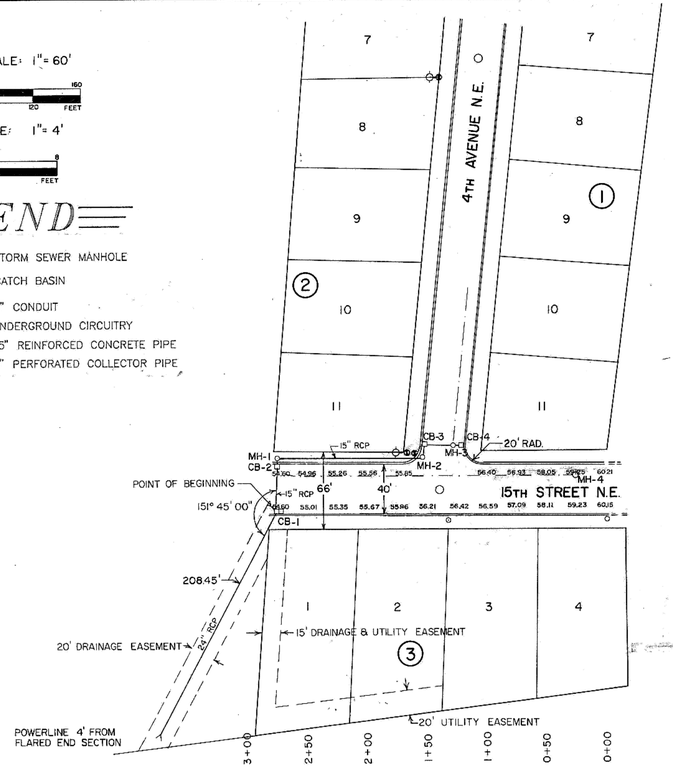

UNDERDRAIN SYSTEM NOT SHOWN ON 15TH STREET N.E. PLAN. SEE 4TH AVENUE N.E. PLAN FOR UNDERDRAIN SYSTEM.

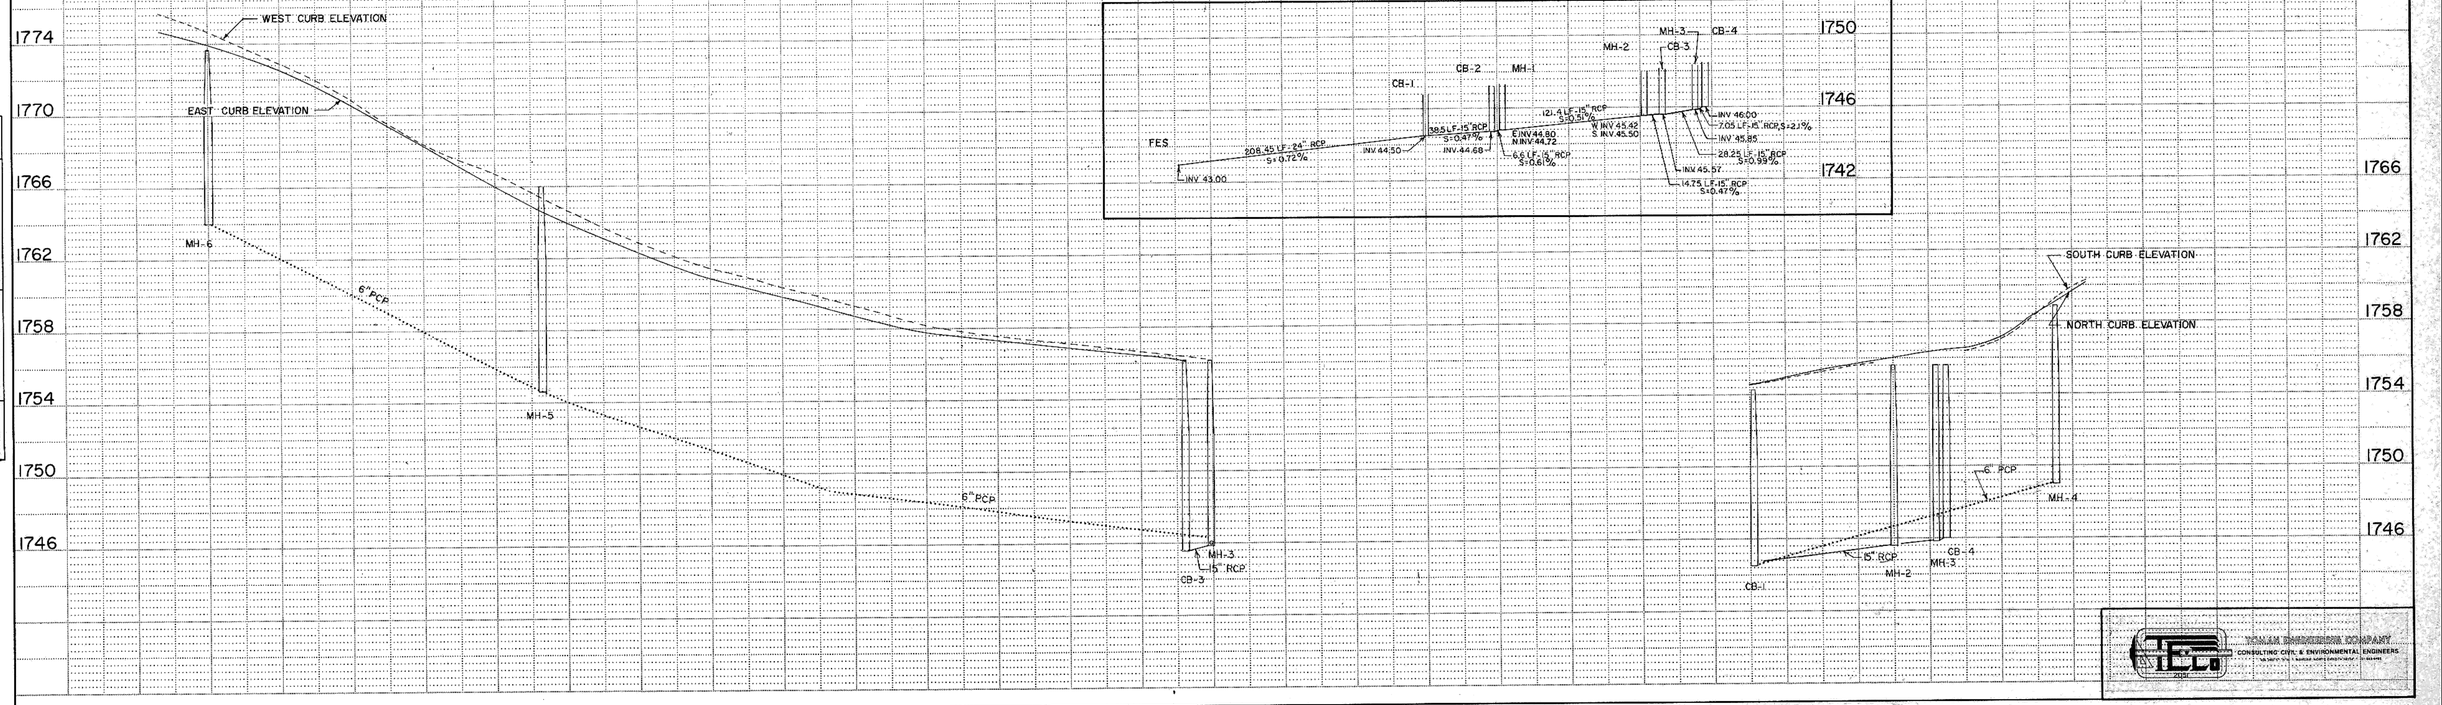

TECO
CONSULTING CIVIL & ENVIRONMENTAL ENGINEERS

4th AVENUE N.E. and 15th STREET N.E. PLAN & PROFILE

SHEET 3 OF 6 AS BUILT DRAWING

TECO NO. 2052

SHEET 4 COMBINED WITH SHEET 3

FINAL SURVEY — NOTE BOOK NO. — SURVEYED — PLOTTED — TEMPLATE — AREAS — AREAS CHECKED — BY — DATE

ORIGINAL SURVEY — NOTE BOOK NO. — SURVEYED — PLOTTED — TEMPLATE — AREAS — AREAS CHECKED — BY — DATE