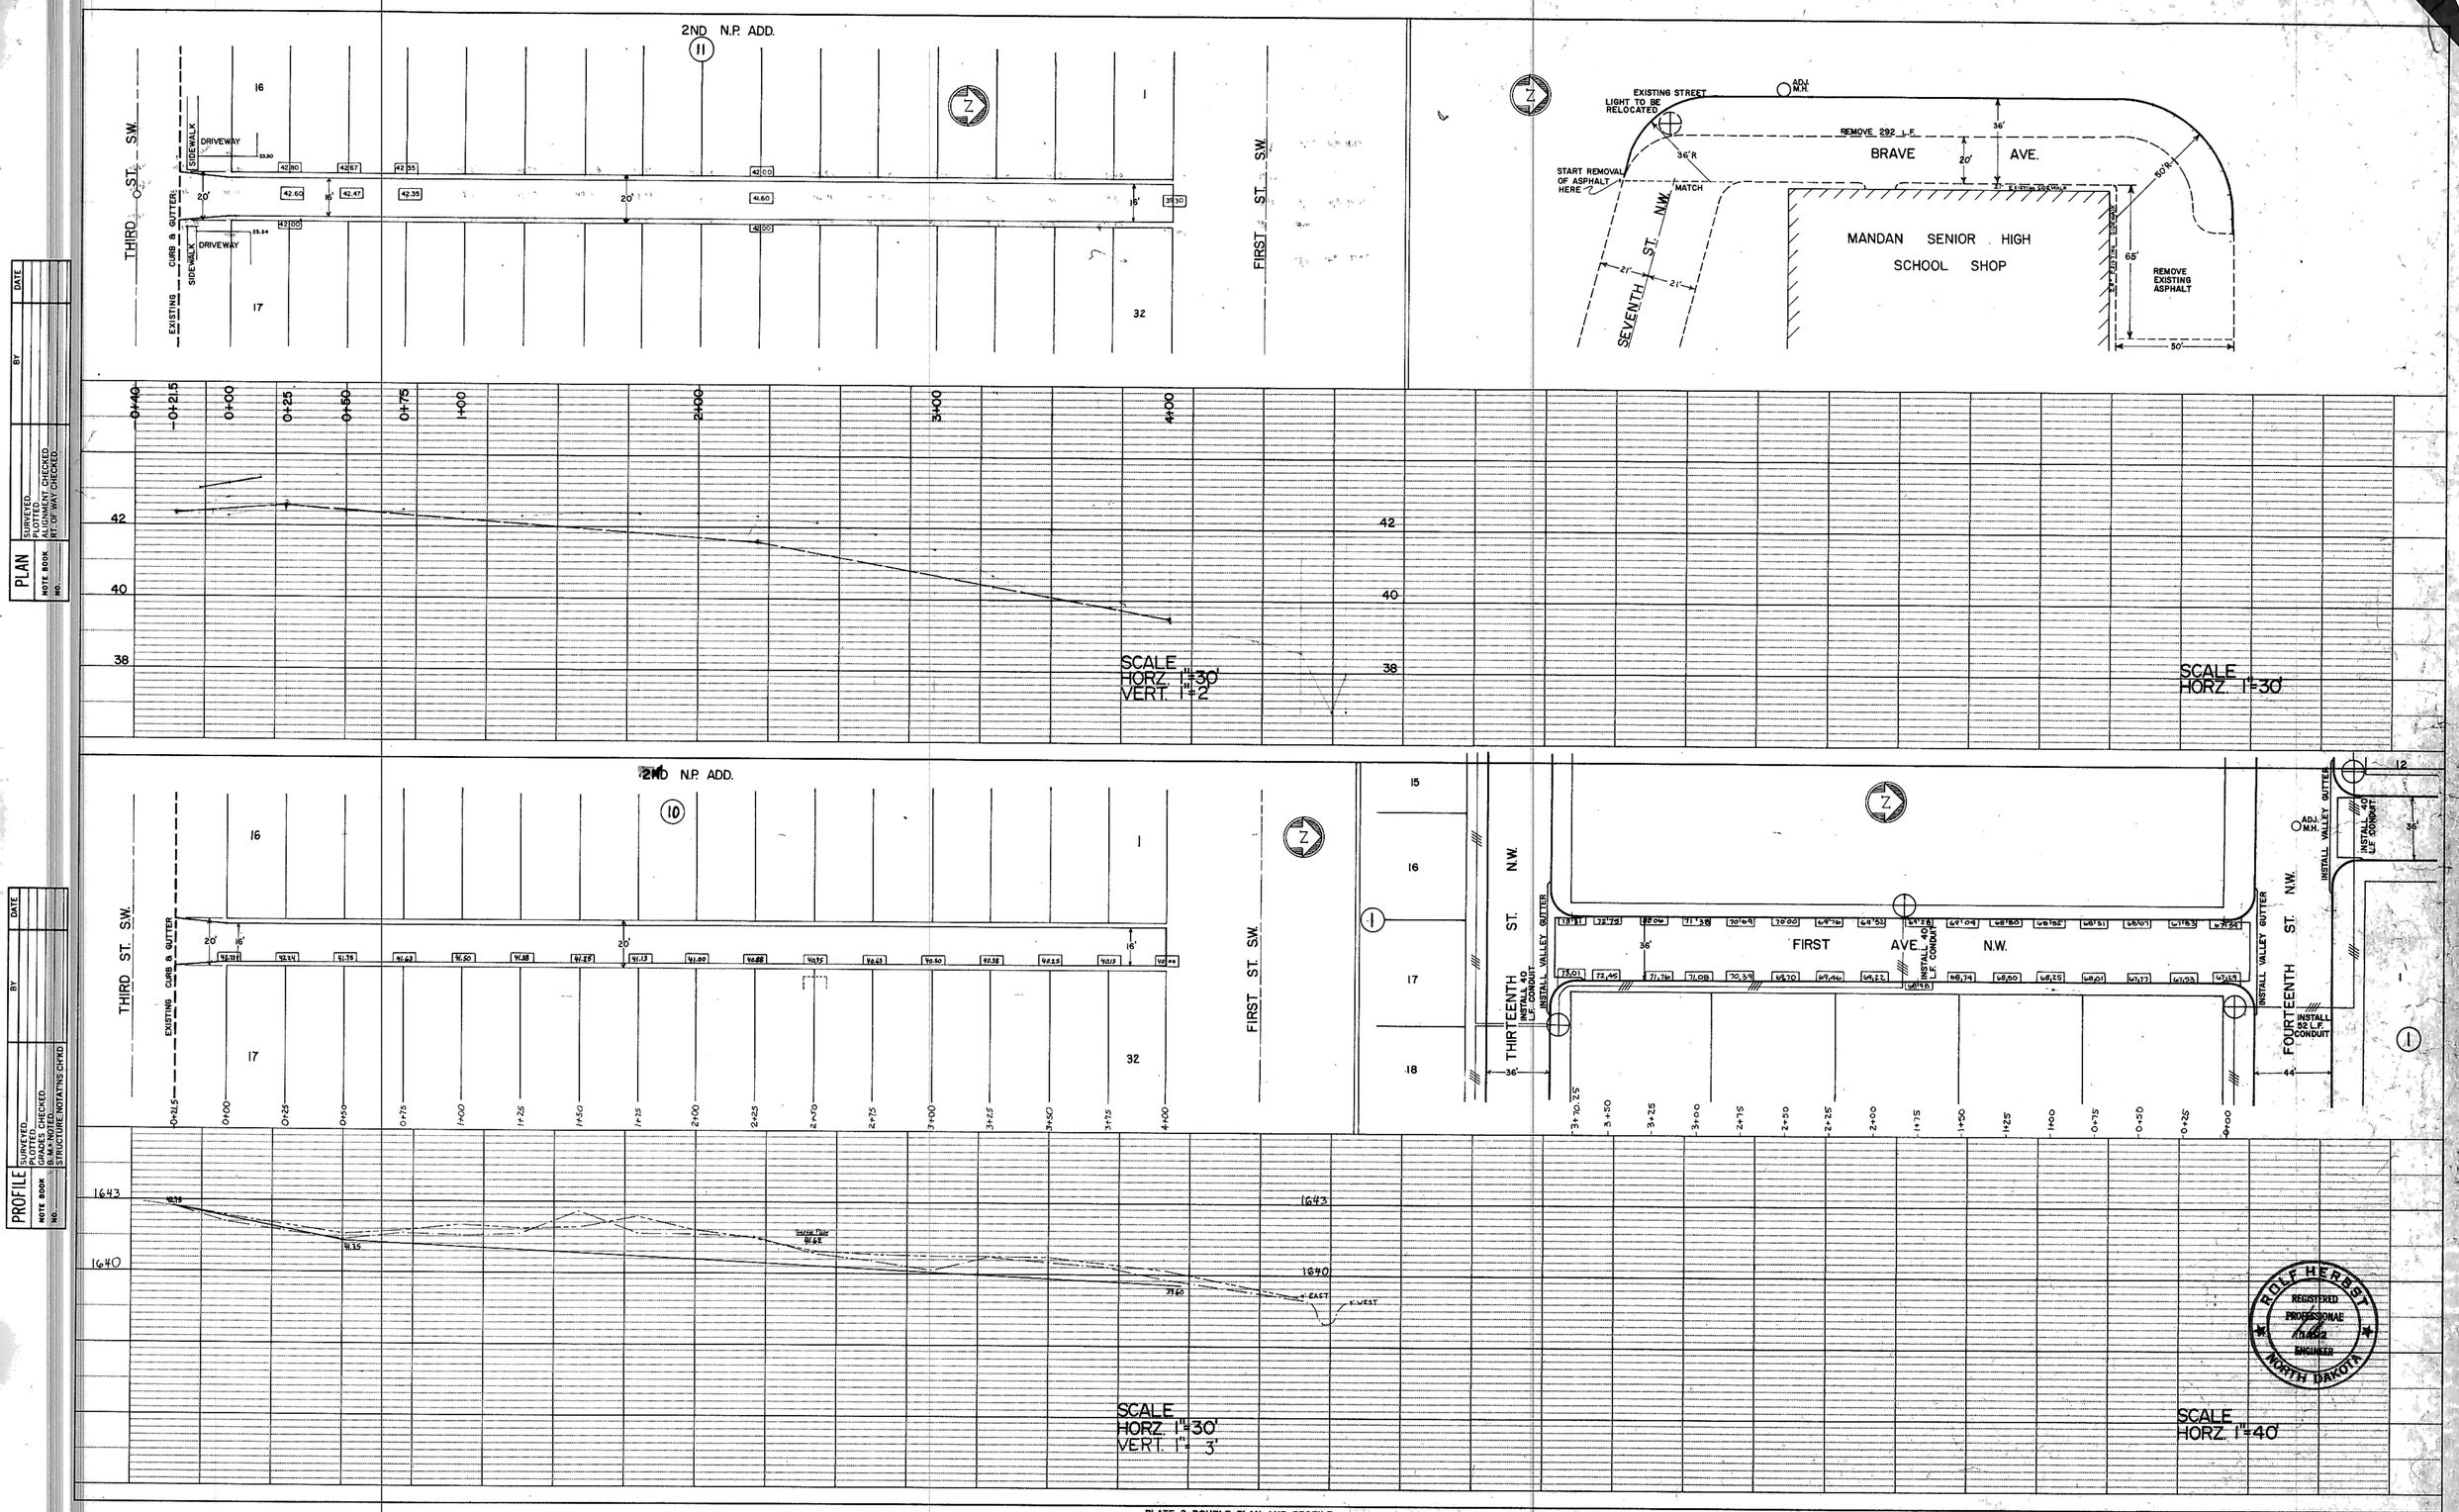

PLAN
NOTE BOOK NO.
SURVEYED
PLOTTED
ALIGNMENT CHECKED
RT. OF WAY CHECKED
BY
DATE

PROFILE
NOTE BOOK NO.
SURVEYED
PLOTTED
GRADES CHECKED
B.M. NOTED
STRUCTURE NOTATNS CHKD
BY
DATE

PLATE 2—DOUBLE PLAN AND PROFILE—DOTTED
100% RAG — MADE AND PRINTED IN U.S.A.
NATIONAL TRACING PAPER DIVISION
I.B.P.&L. CO., INC. INDIANAPOLIS, INDIANA

SHEET NO. 11 OF 16 SHEETS